
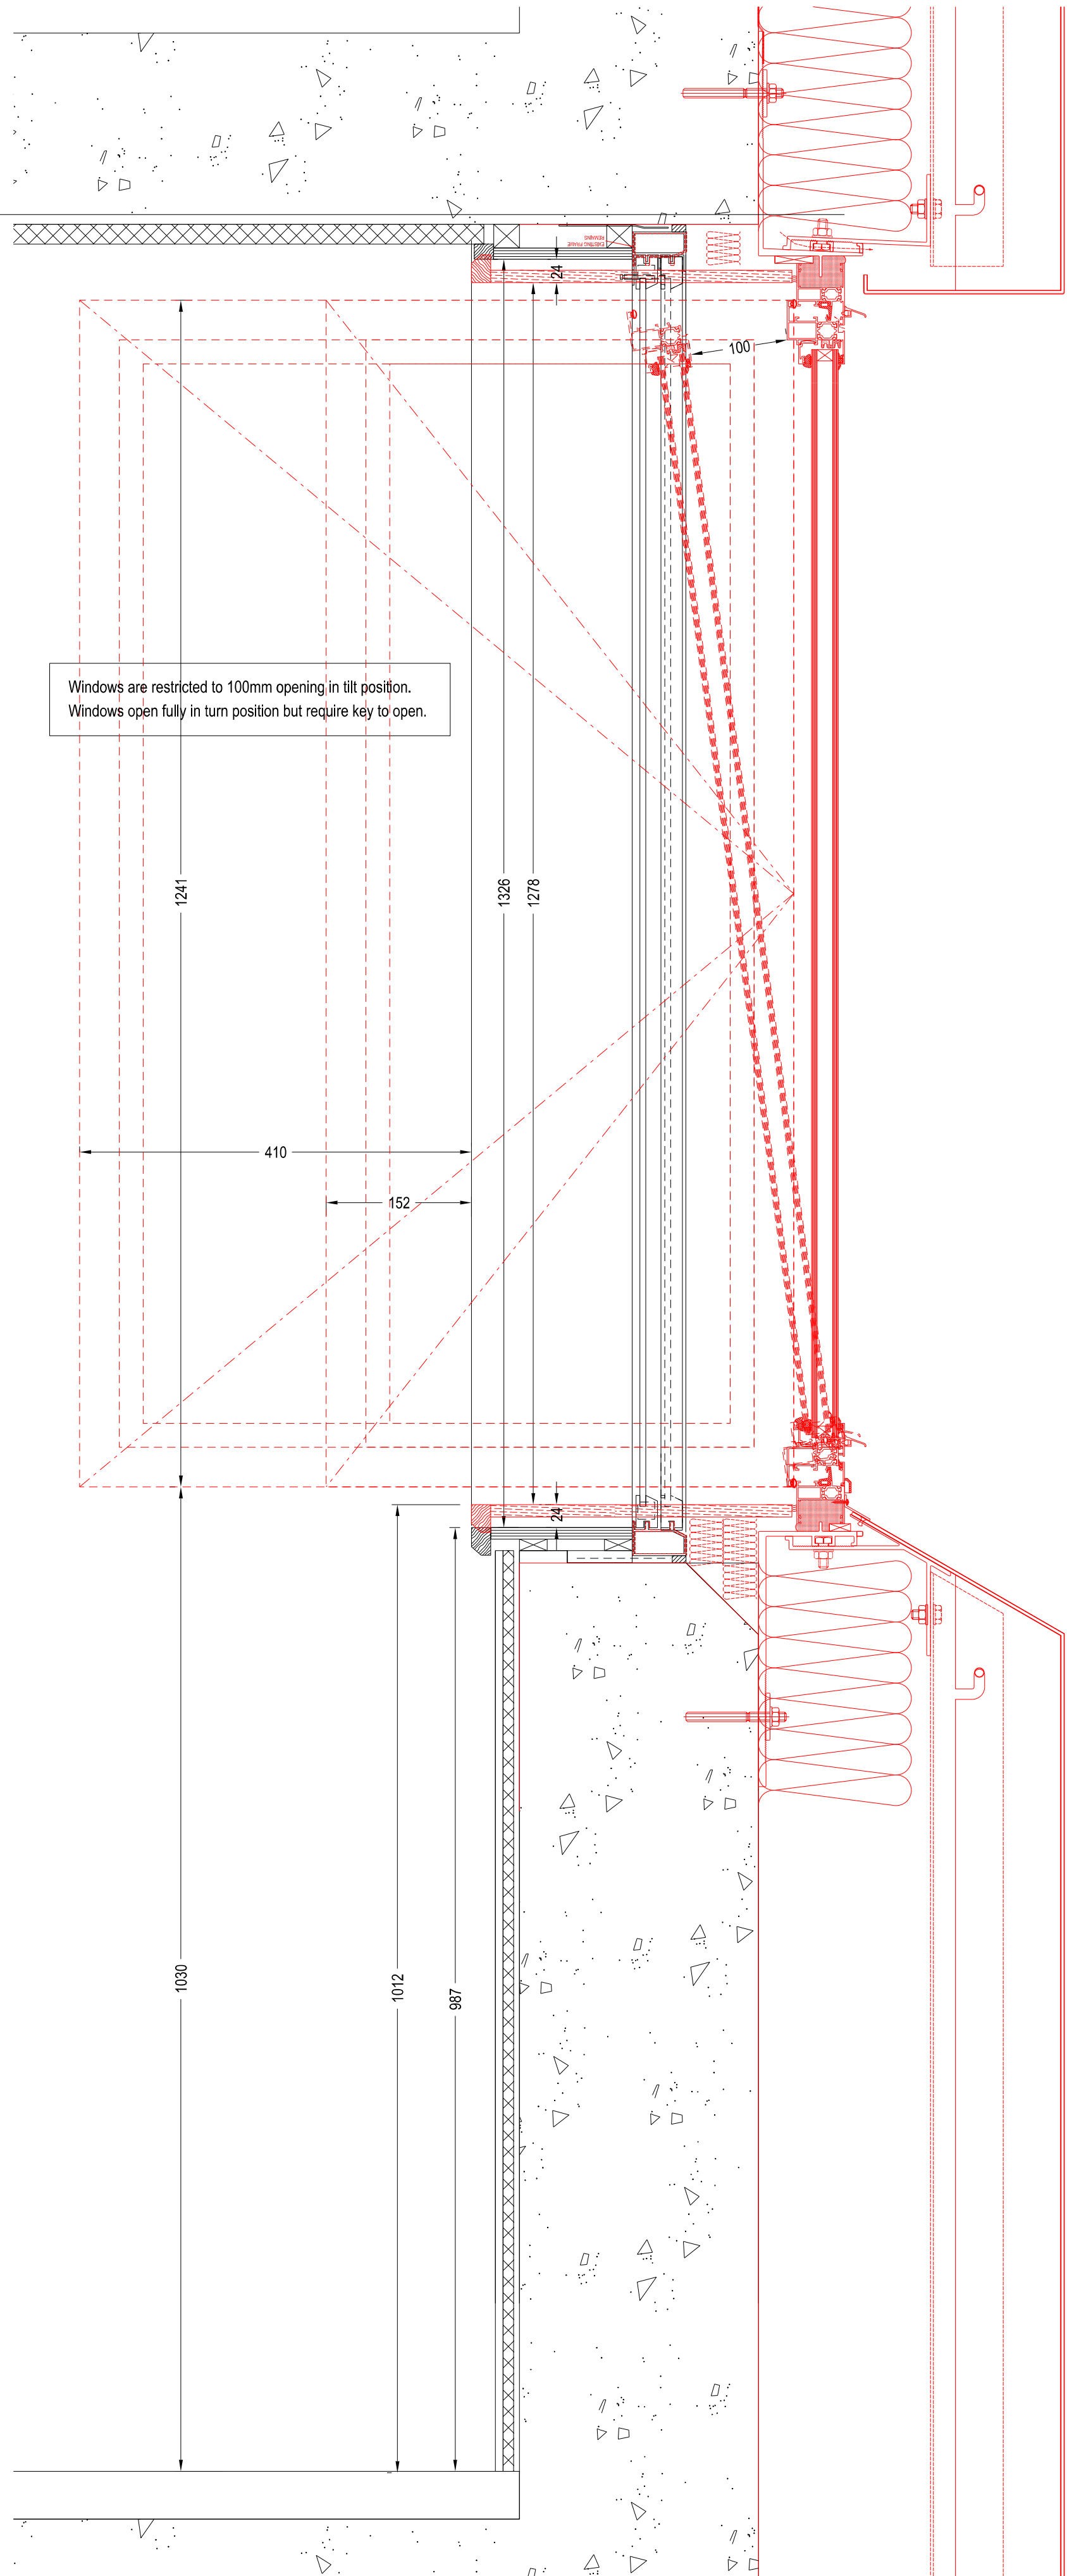
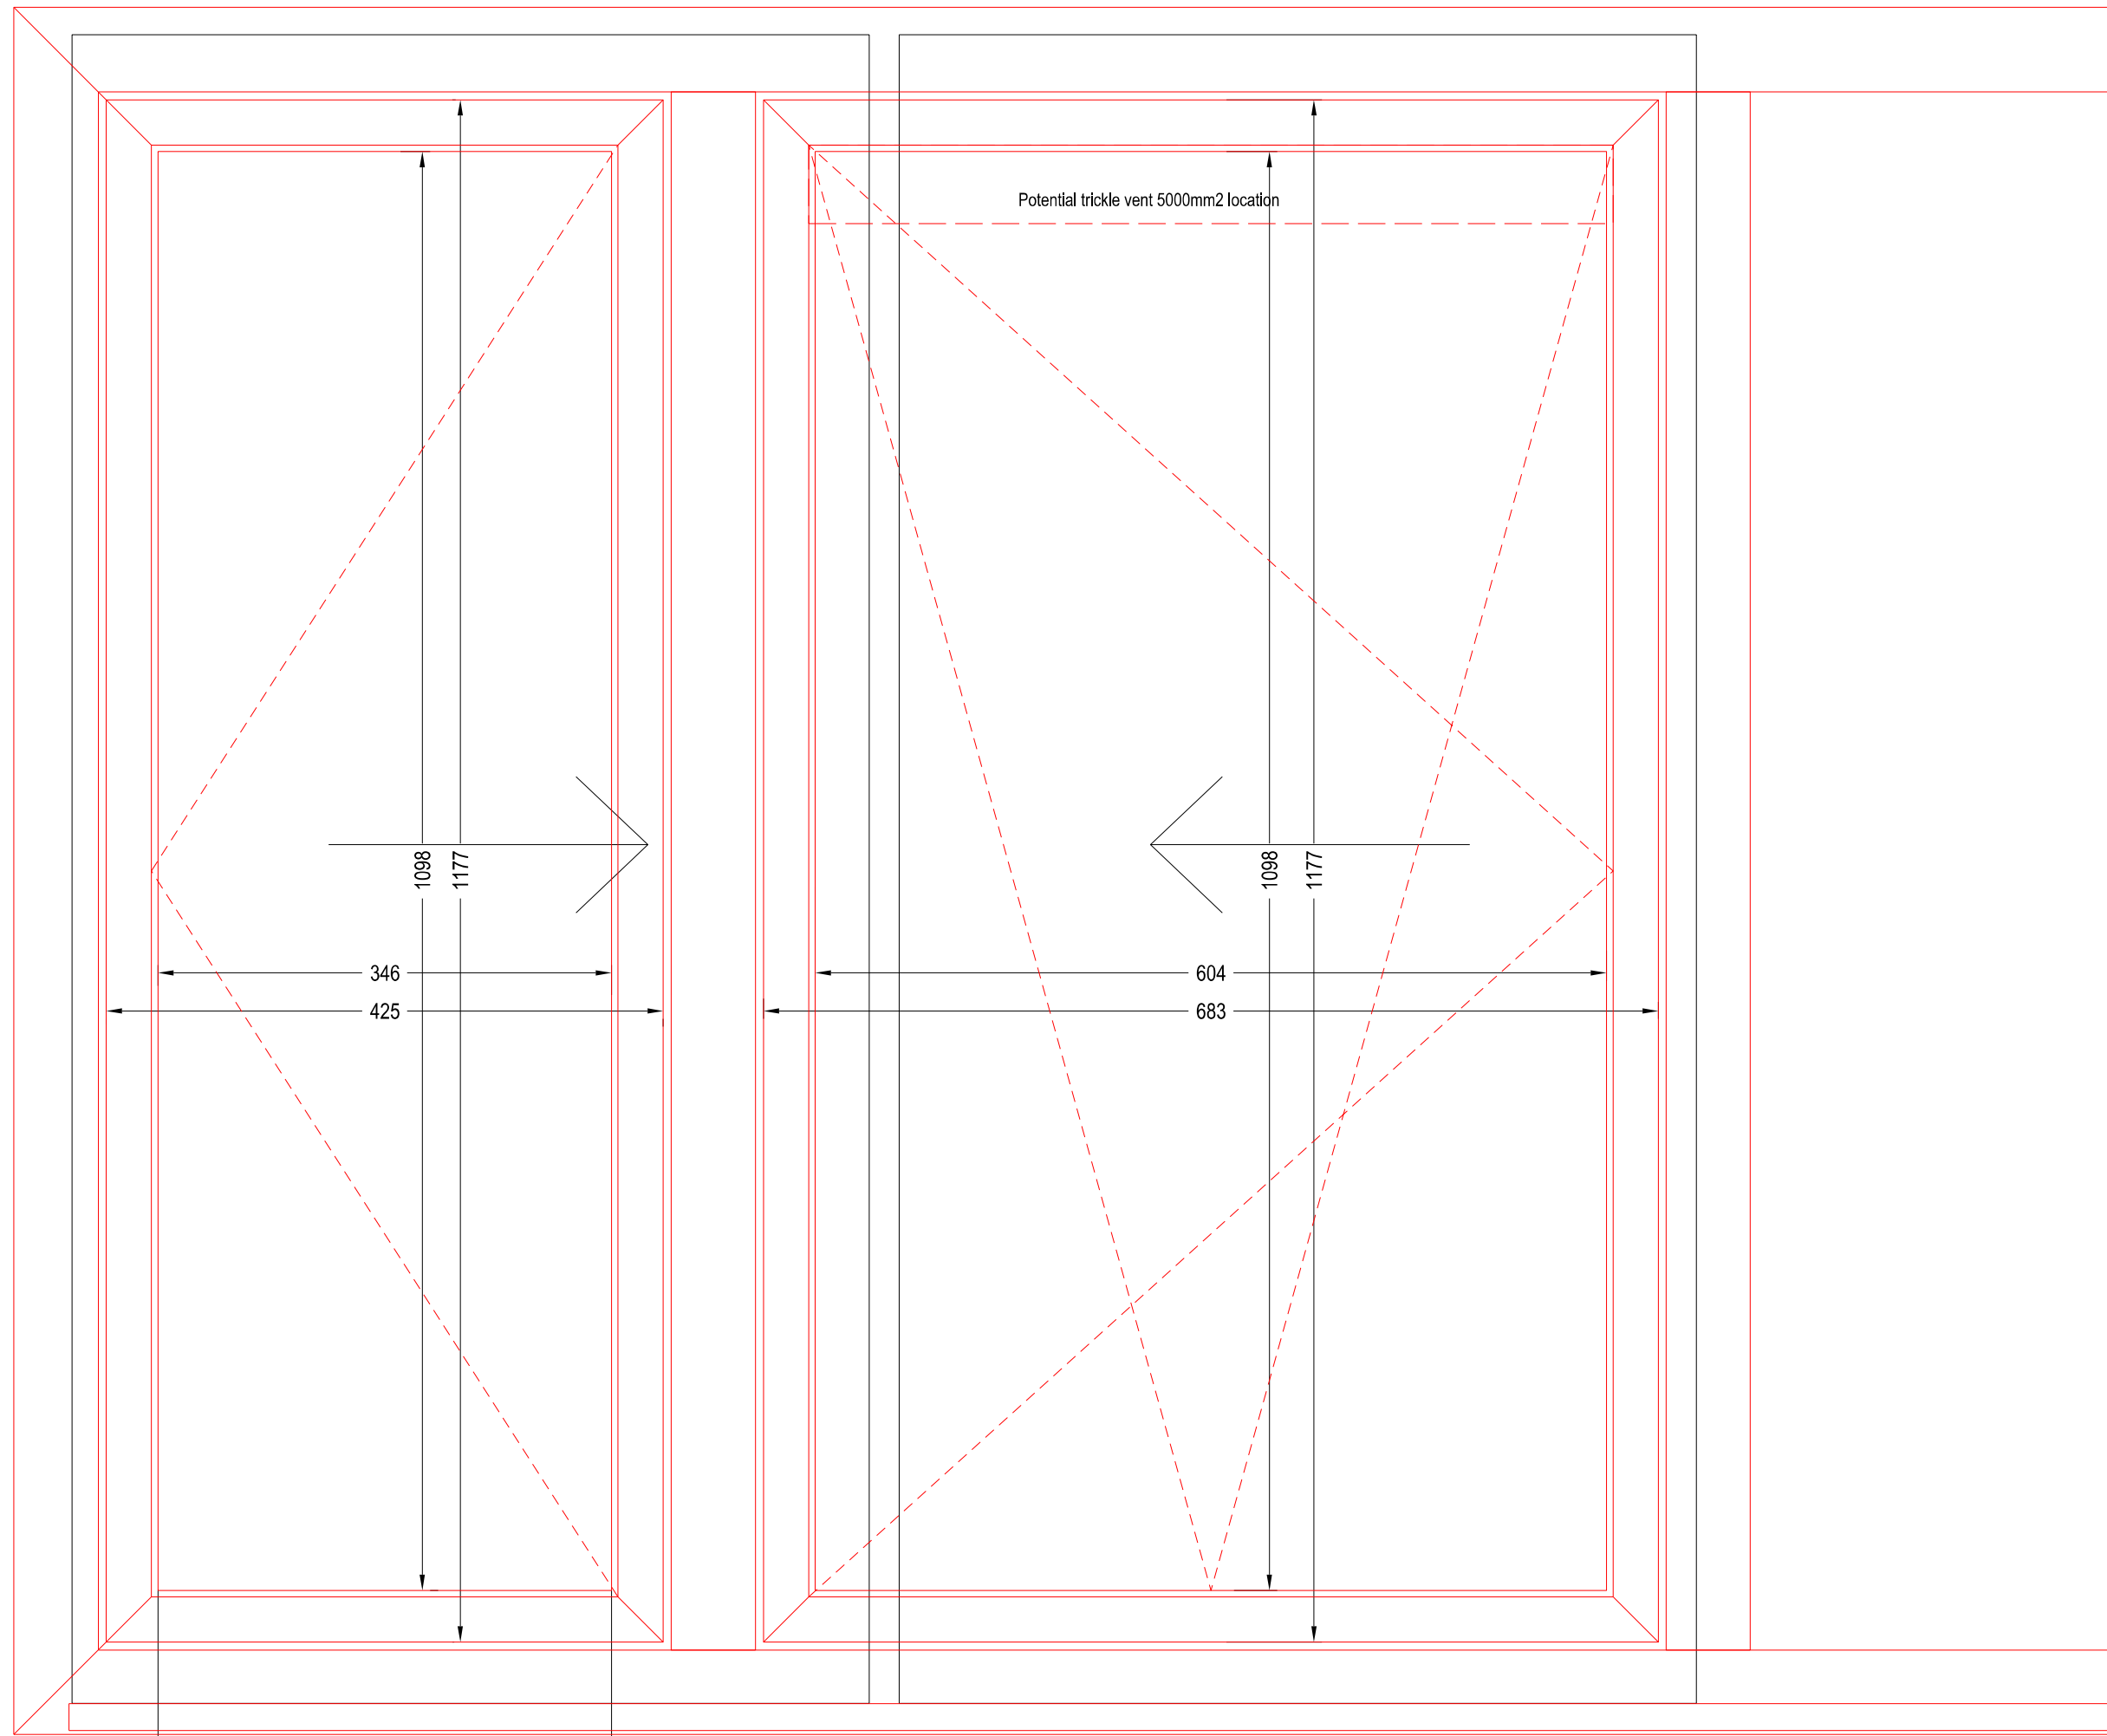


Kitchen Window
Vent- Colour Matched to
Window Frame

Existing window opening and frame shown in black
Proposed window shown in red

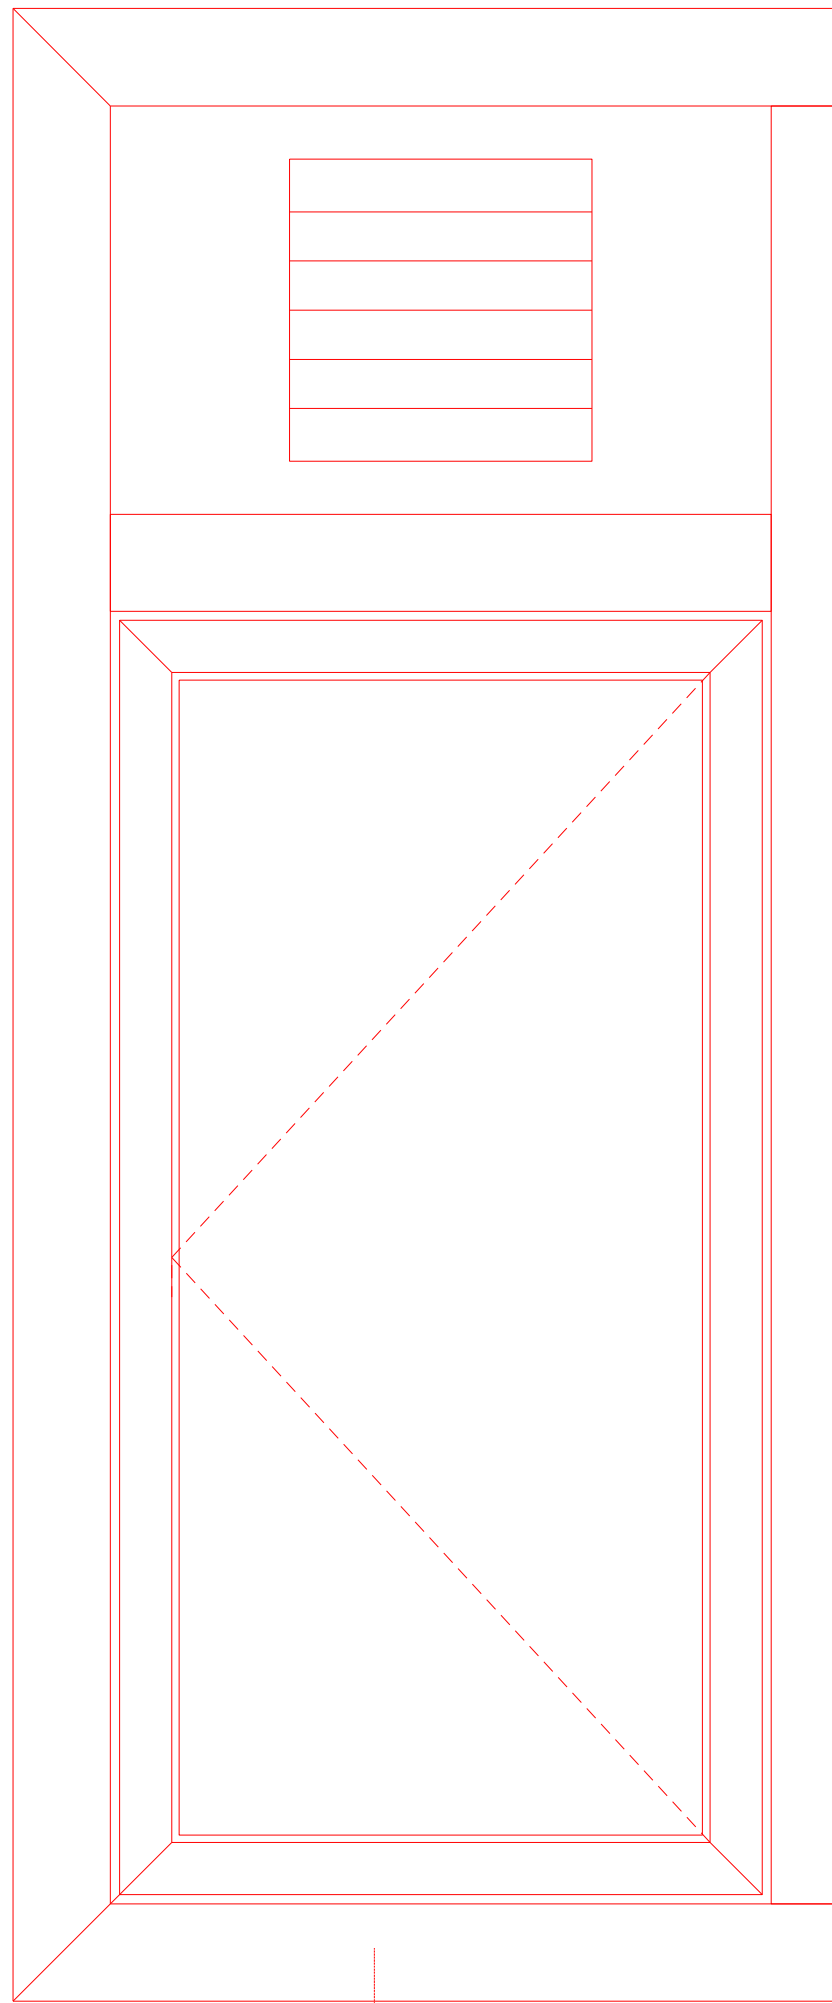

- NOTE
1. THIS DRAWING IS COPYRIGHT STUDIO E LLP
 2. THE CONTRACTOR MUST NOT SCALE FROM THE DRAWING ALL DIMENSIONS TO BE TAKEN FROM DIMENSION STRINGS.
 3. WHERE ANY DISCREPANCIES ARE FOUND BETWEEN DIMENSIONS THESE MUST BE BROUGHT TO THE ATTENTION OF THE ARCHITECTS FOR RESOLUTION.
 4. WHERE DISCREPANCIES EXIST BETWEEN REFERENCE OR ASSEMBLY DRAWINGS & DETAIL DRAWINGS, THE LATTER TAKE PREFERENCE.

03	24/11/14	Kitchen Window Layout Added
02	19/11/14	Small Window Opening Amended
01	18/11/14	Types Updated

FOR INFORMATION

STUDIO E LLP
Palace Wharf, Rainsville Road,
London, W6 9HN
Tel: 020 7381 7126
Fax: 020 7381 4995

KENSINGTON AND ALDRIDGE
ACADEMY

PROJECT

Reduced Window Opening
Inward Opening Leafs
DRAWING

1:20@A3 05/11/14
SCALE DATE

1265 SK 112 03 SE
DWG. NO. REVISION CHECKED

02 1:5 Horizontal Plan Section - Existing and Harleys Proposed Detail

03 1:5 Vertical Section - Existing and Harleys Proposed Detail