


West Terrace Flats Entrance Gate - 1:10

Pier Capping
Type 2

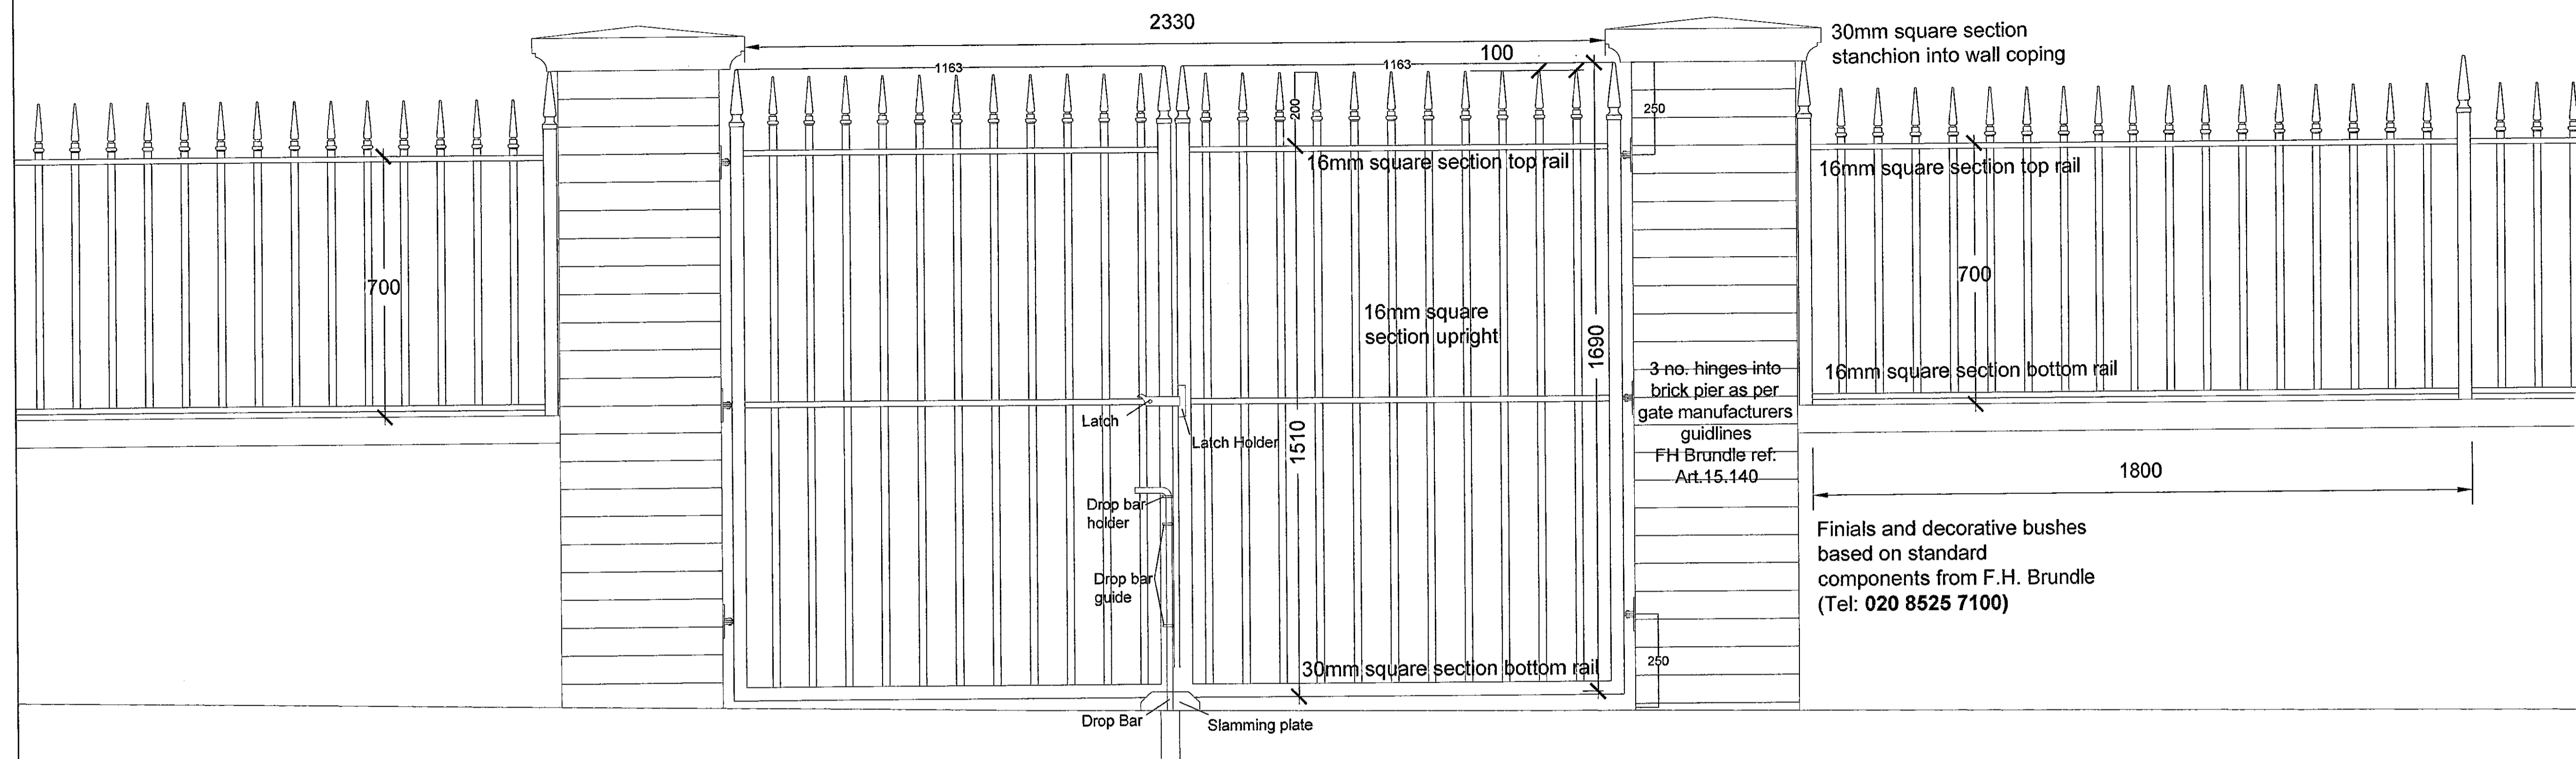

Contractors are not to scale dimensions from this drawing

Revision	Date
2	29.07.03

Reference to Con-Tech wall coping details added. Whitby Bird pier reinforcement note included.

NOTE:

Final fabrication size to be agreed on-site after fixing of pier spacings. Measurements to be taken by fabricator.

Refer to BML-10337-90-125 for latest scheme layout.
Refer to BML-10337-90-520 for wall coping and capping unit details.
Refer to BML-10337-90-525 for railing details.
Refer to BML-10337-90-522 for section and details location plan.
Refer to Whitby Bird Dwg 16460/S/401 for retaining walls construction details.
Refer to Con-Tech (tel: 01226 244 051) drawings CT445-01-06 and GA01 for stone coping details.

Gate and accessories to be FH Brundle or similar approved.

Gate Accessories:

Drop Bar Guide - Art no. 058806
Drop Bar - Art No. 058810
Drop Bar Holder - Art No. 058808

Gate Latch - Art No. 058802
Latch Holder - Art No. 058812



Hinges - Art No. 15.140 Hinge MA with welded plate 90x90x4mm

Pier Construction - Gate supporting Piers: Cores to be backfilled with concrete and single T12 rod central to pier and lapped into footing beneath (as Whitby Bird recommendations)

EX	DIR	TP	AG	CLU	AK
R.B.I	K.C.	11 SEP 2003	PLANNING		
N	C	SW	SE	APPL	REC

Non-opening Gates - Standard Detail - 1:10

Finials and decorative bushes based on standard components from F.H. Brundle (Tel: 020 8525 7100)

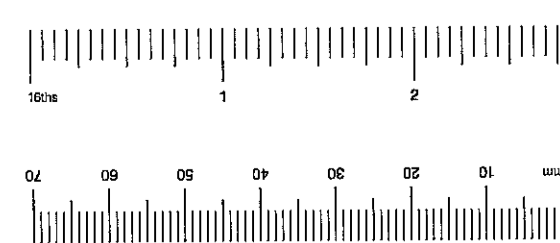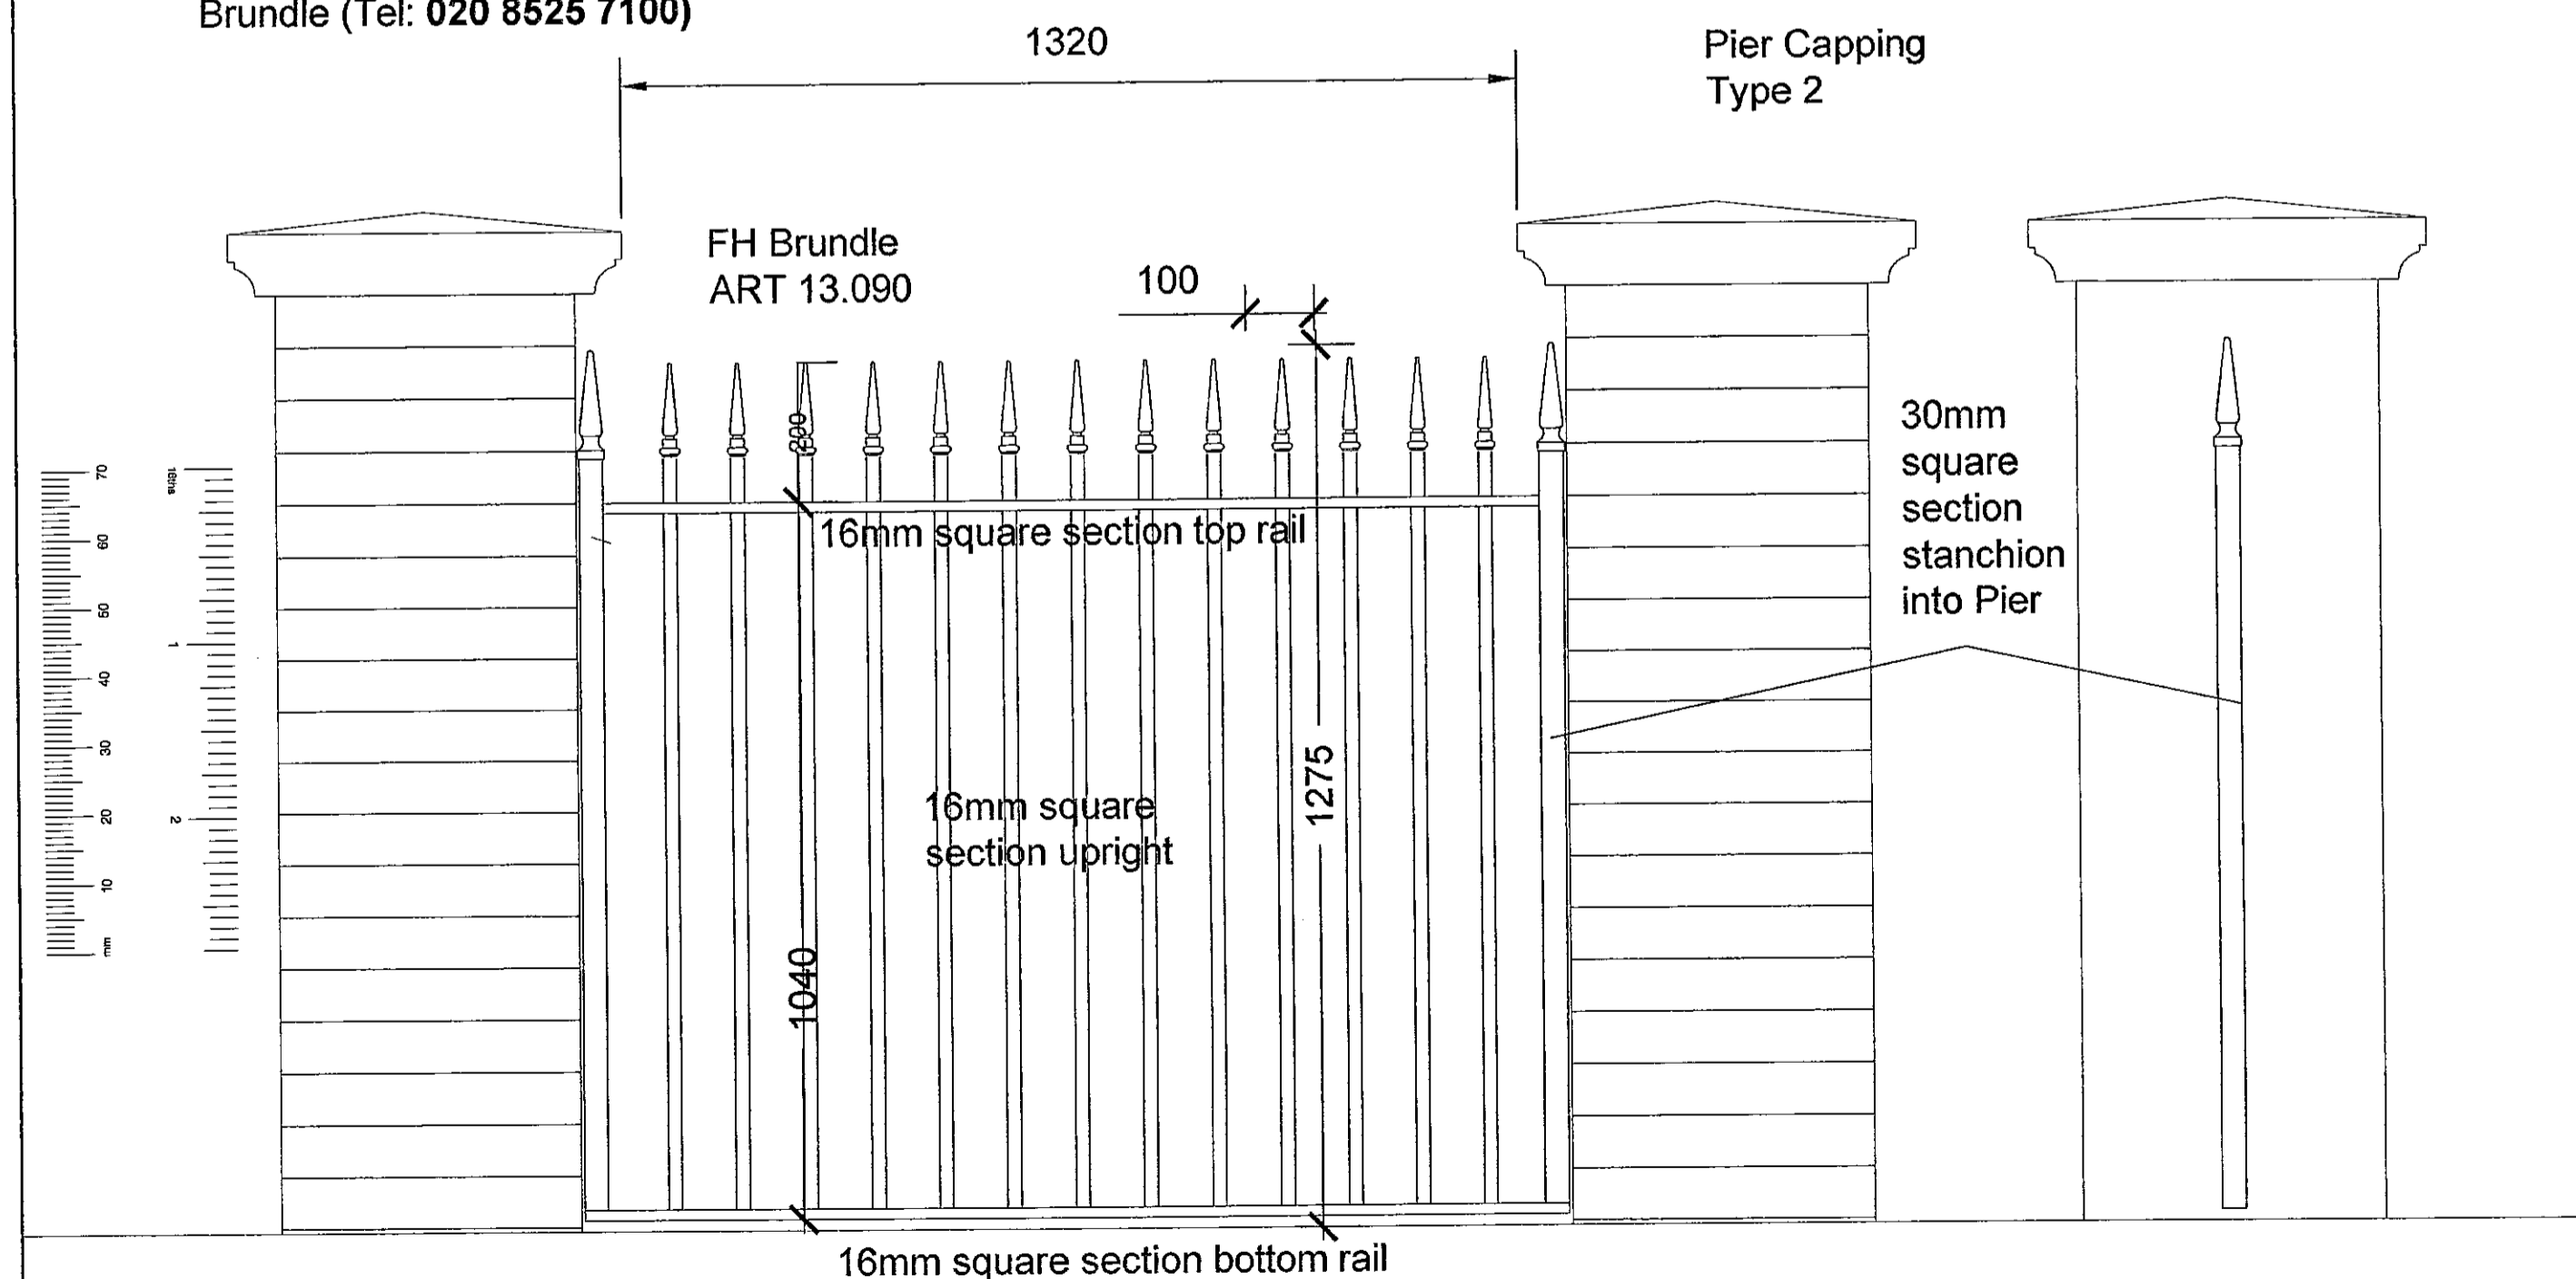

BroadwayMalyan
Landscape

Woburn Hill, Addlestone
Weybridge, Surrey KT15 2QA
T: +44(0)1932 845599
F: +44(0)1932 846043
E: Bml@BroadwayMalyan.com

Client

ST JAMES HOMES

Project

Aubrey Walk Campden Hill Res.

Description

Aubrey Walk Elevation

Gate Features

Campden Hill Flats to West

Status




For Construction

Scale	Drawn	Date
1:20	CPJ	01.07.03
Job number	Drawing number	Revision
10337	526	2

Aubrey Walk Elevation 1:200



Contractors are not to scale dimensions from this drawing

Revision _____ Date _____

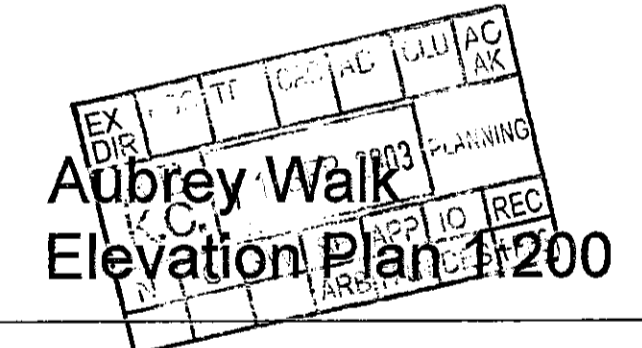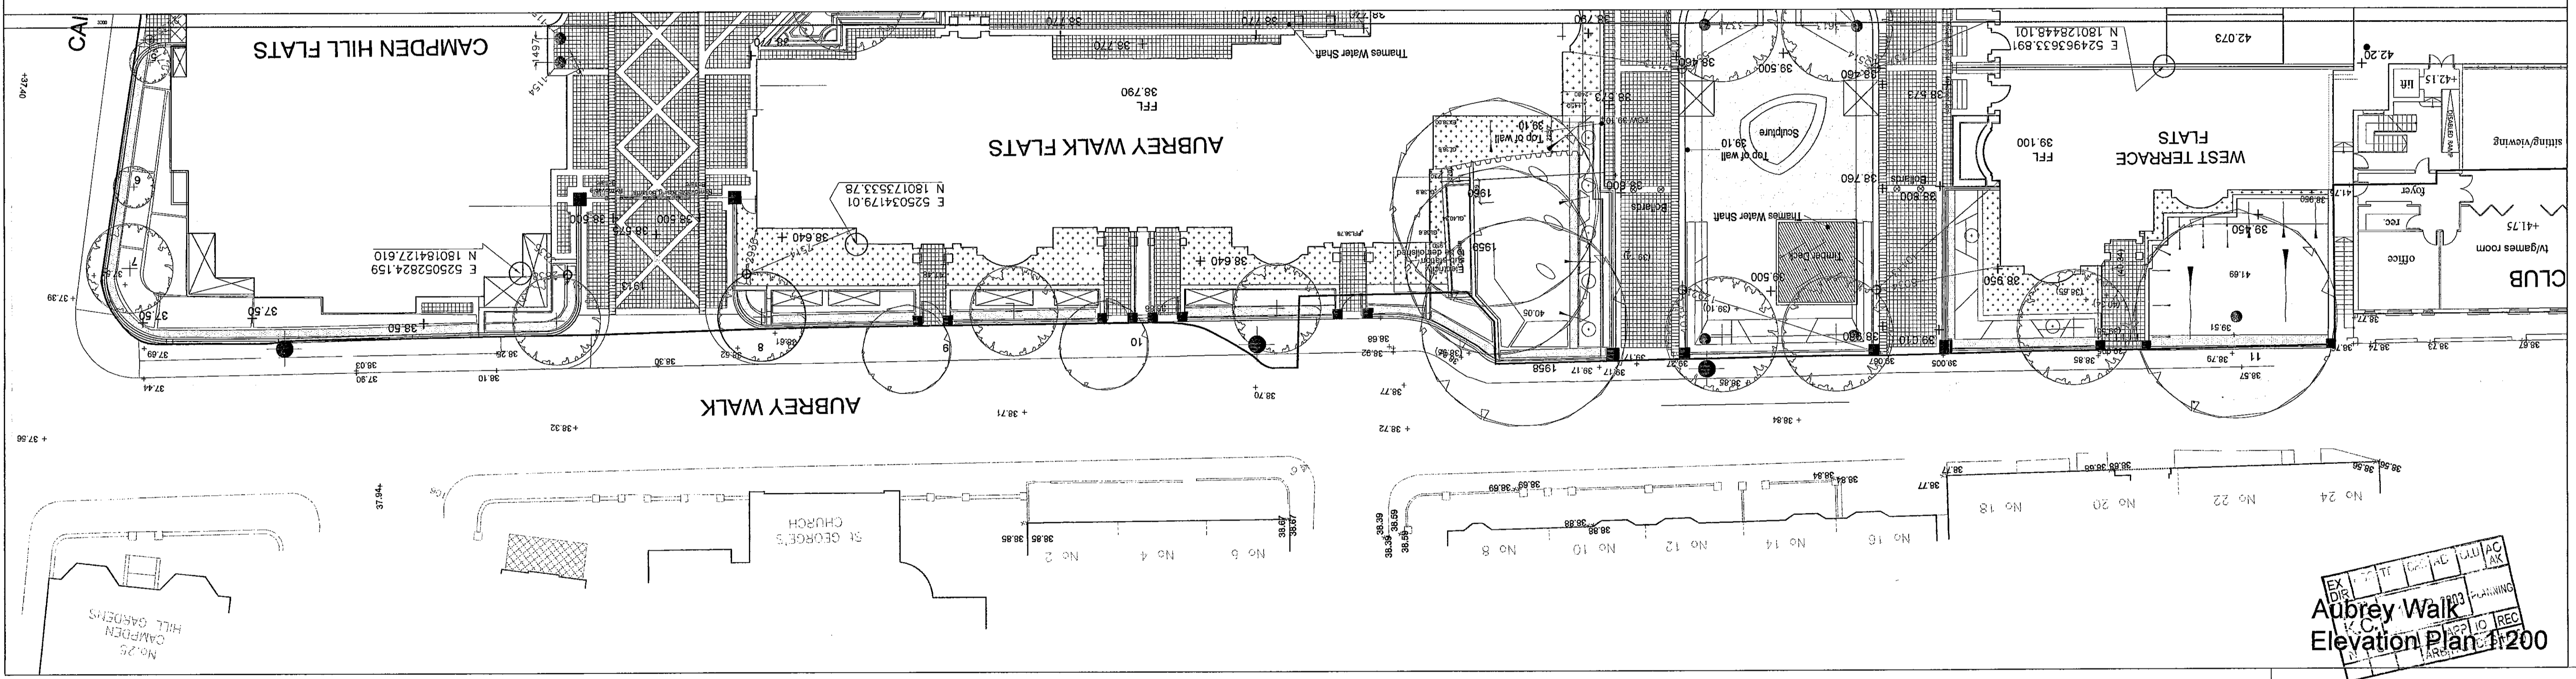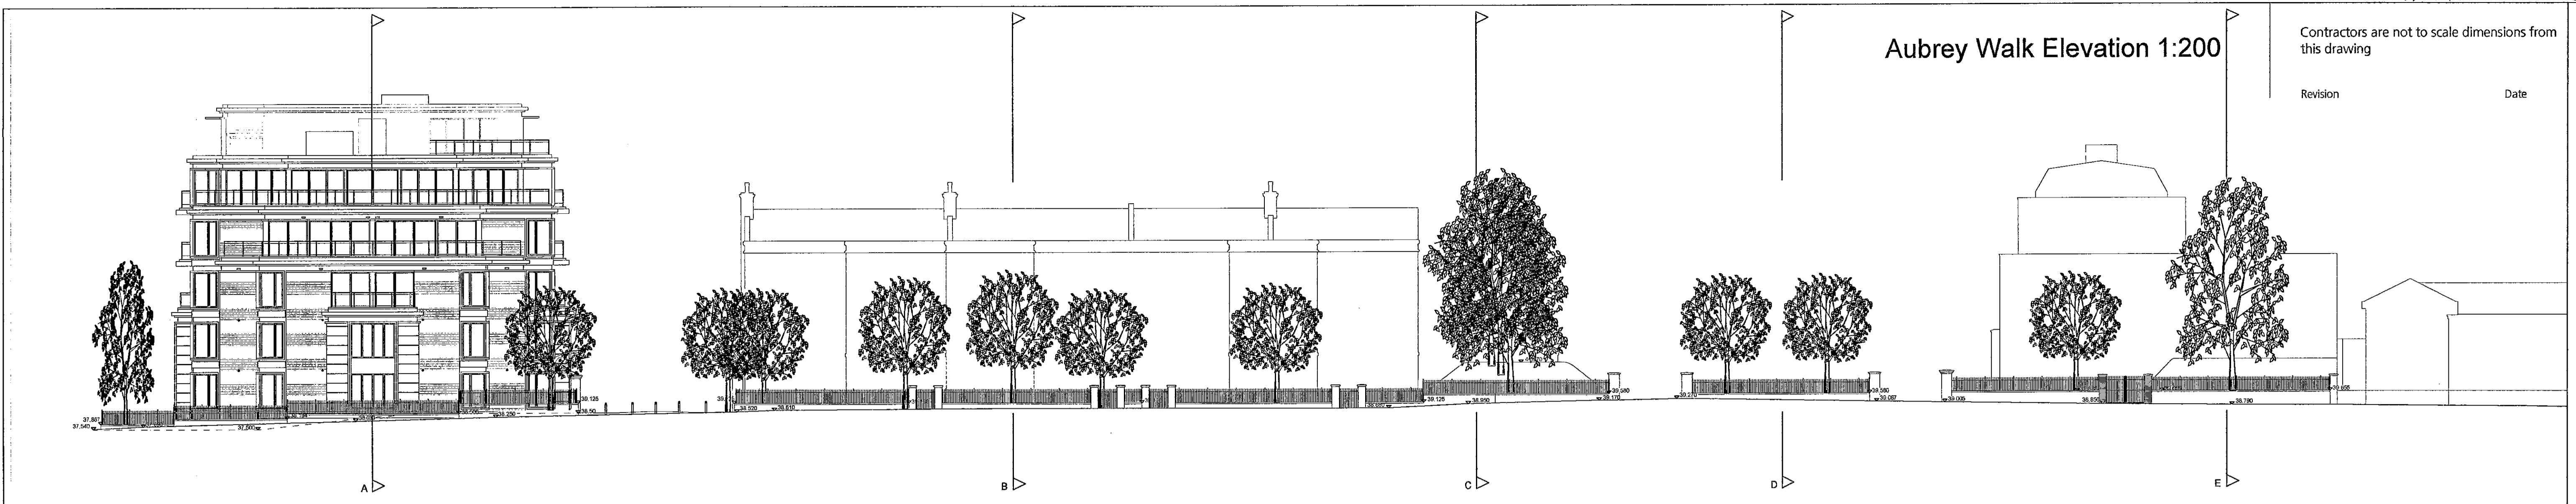

NOTE:
 Refer to BML-10337-90-125 for latest scheme layout.
 Refer to BML-10337-90-520 for wall coping and capping unit details.
 Refer to BML-10337-90-525 for railing details.
 Refer to BML-10337-90-522 for section and details location plan.
 Refer to BML-10337-90-542 for section through Aubrey Walk boundary wall.

A	Alteration to tree heights & Section E	14.12.99
B	Minor amendments	15.12.99
C	Piers indicated minor amendments	21.01.00
D	Copings to walls amended	23.2.00
E	Copings to walls amended	13.3.00
F	Minor amendments	12.4.00
G	Change to gate position on elevation	23.5.00
H	Issue for Tender	15.03.02
J	Addition of drop bollards	28.03.02
K	Revise wall level to match BM dwgs	05.08.02
L	Amendments to detail section	06.03.03
M	Amendments to reflect VE meetings	18.06.03
N	Pier cappings amended, West terrace flats gate added and wall height adjusted.	04.07.03
1	For Construction Removed trees no longer shown, Grass and gravel hatch shown.	10.07.03
2	For Construction Amendment to references.	19.08.03
3	Bollards updated	26.08.03

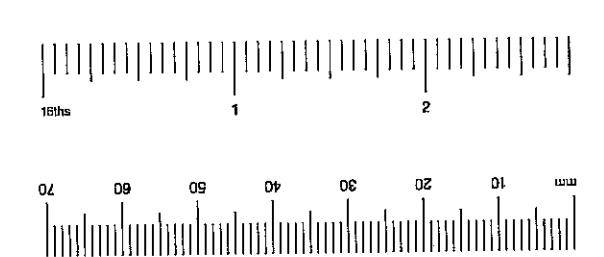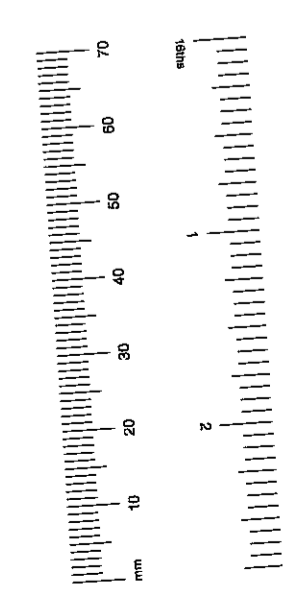


BroadwayMalyan
Landscape
 Woburn Hill, Addlestone
 Waybridge, Surrey KT15 2QA
 T: +44(0)1932 845599
 F: +44(0)1932 845043
 E: Bml@BroadwayMalyan.com

Client
ST JAMES HOMES
 Project
Aubrey Walk Campden Hill Res
 Description
**Boundary Elevations
 Aubrey Walk Frontage
 Campden Hill Flats to West**


Status
For Construction
 Scale Date Drawn Date
 1:200 CPJ 26.08.03
 Job number Drawing number Revision
 10337 155 3
 Original size 100mm Copyright Broadway Malyan Limited

Contractors are not to scale dimensions from this drawing


Revision Date
 A Amendments to schedule FA 06.03.03
 B Species and specifications amended in agreement with CPJ 08.09.03
 TC Landscapes in response to availability issues.

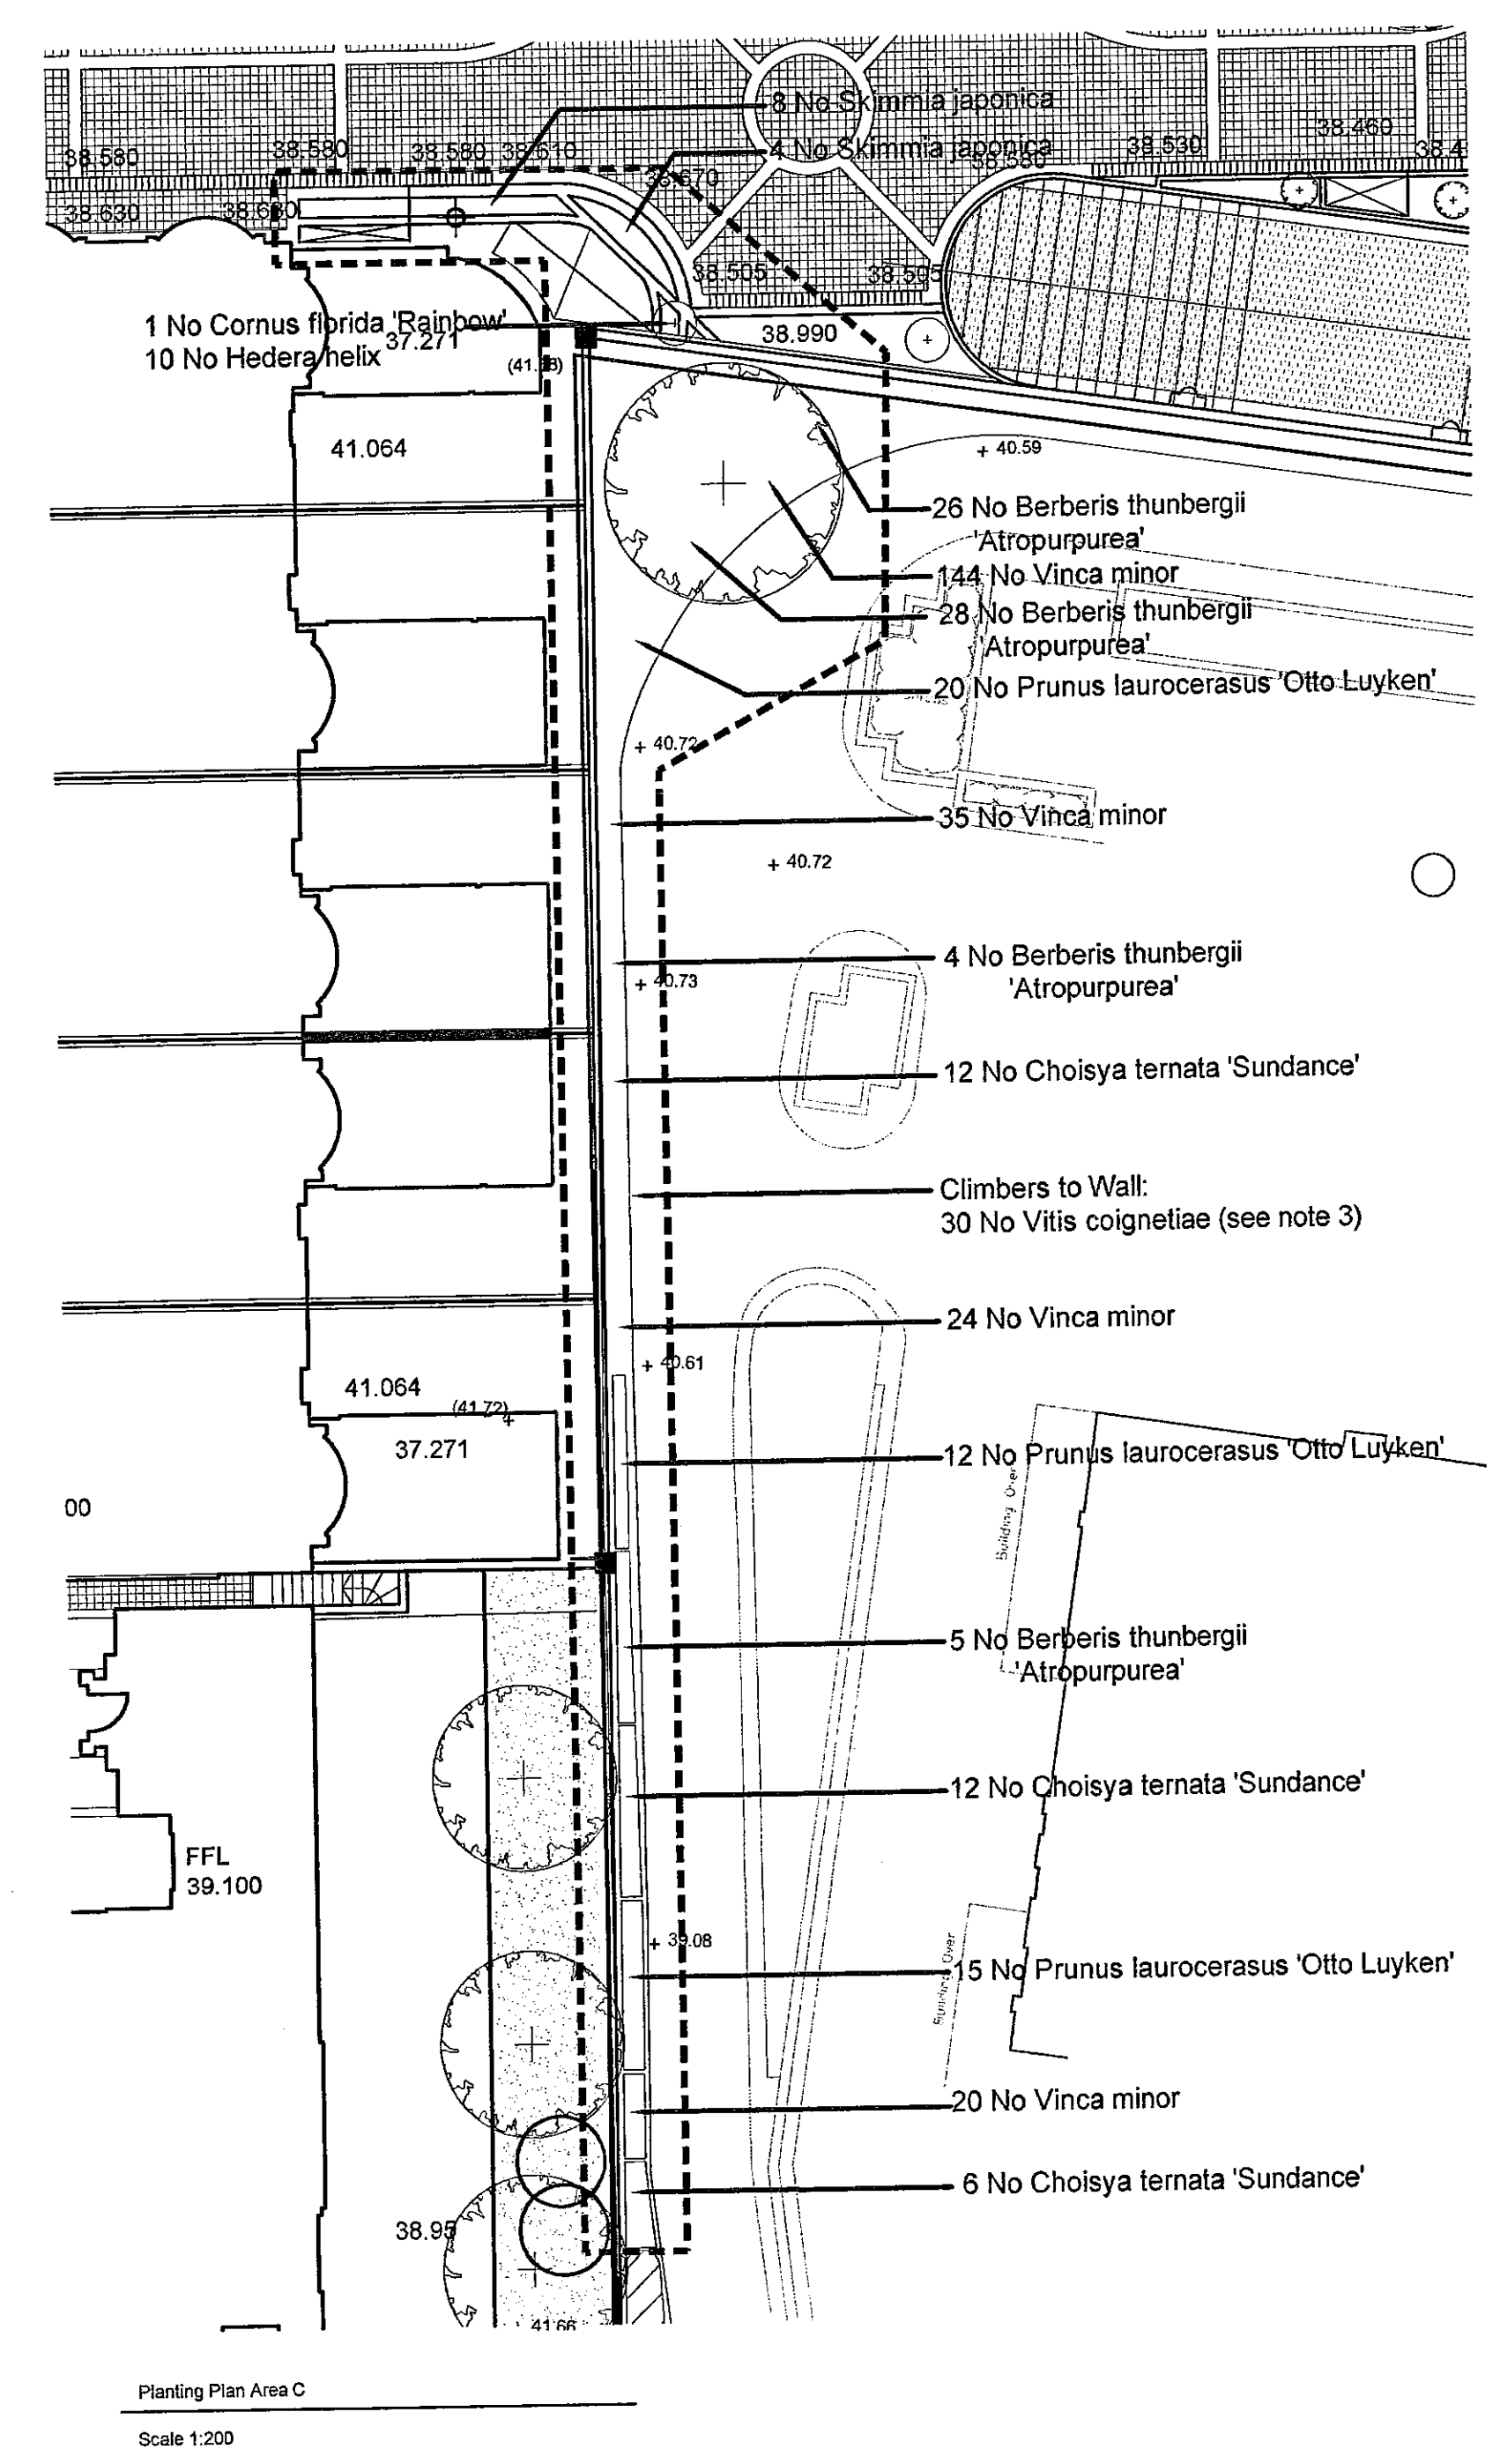

Planting Plan Area C
Scale 1:200

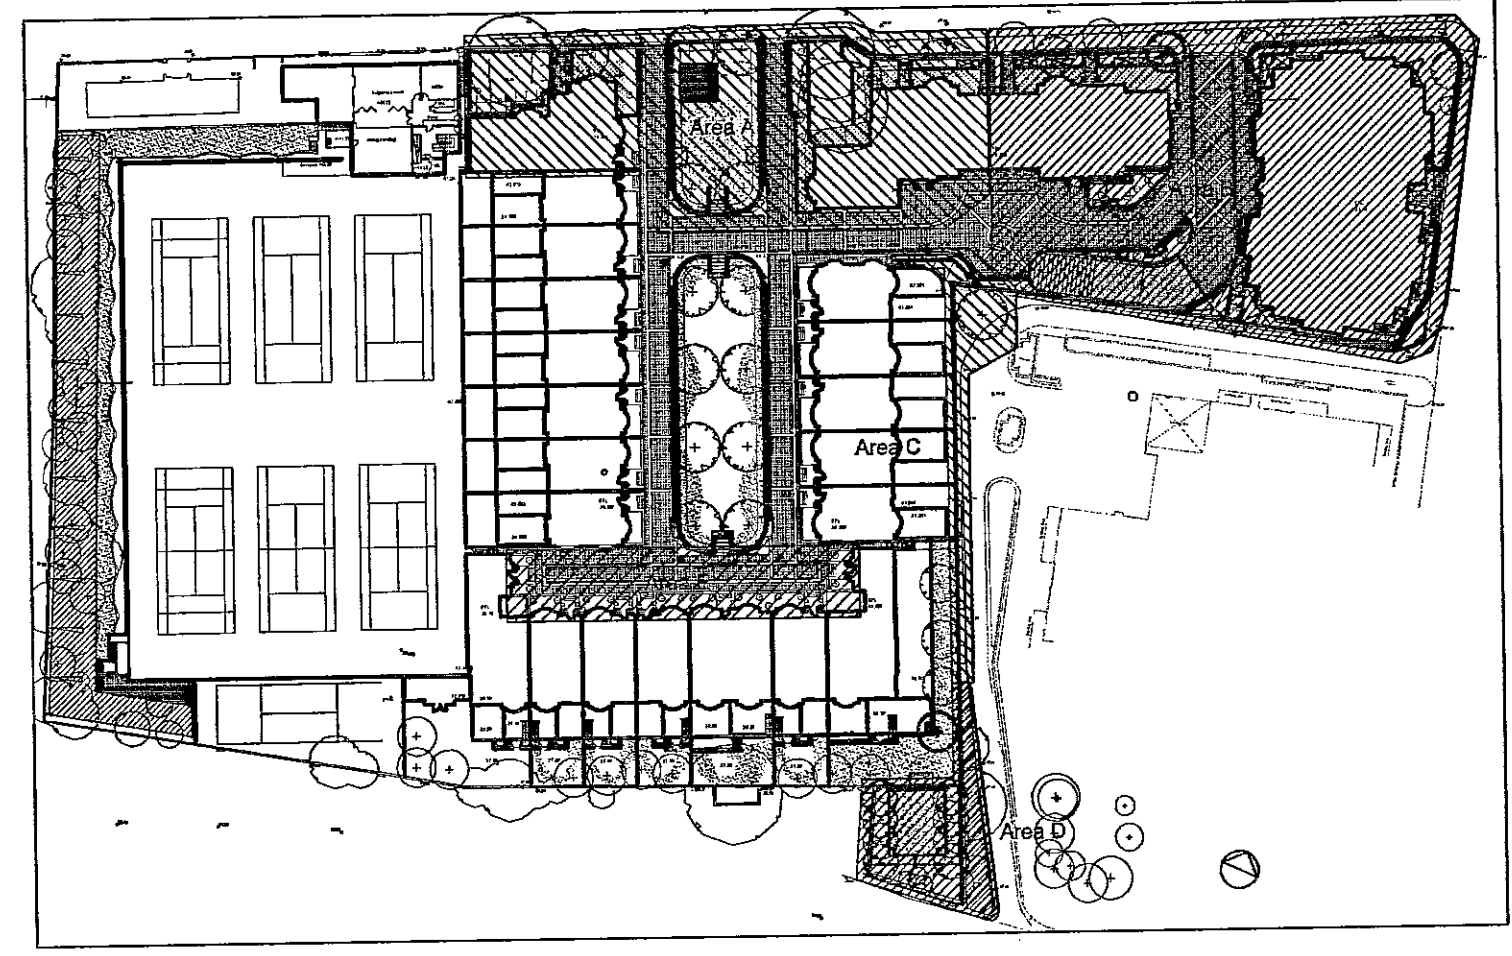

Key to Planting Plan Area Locations

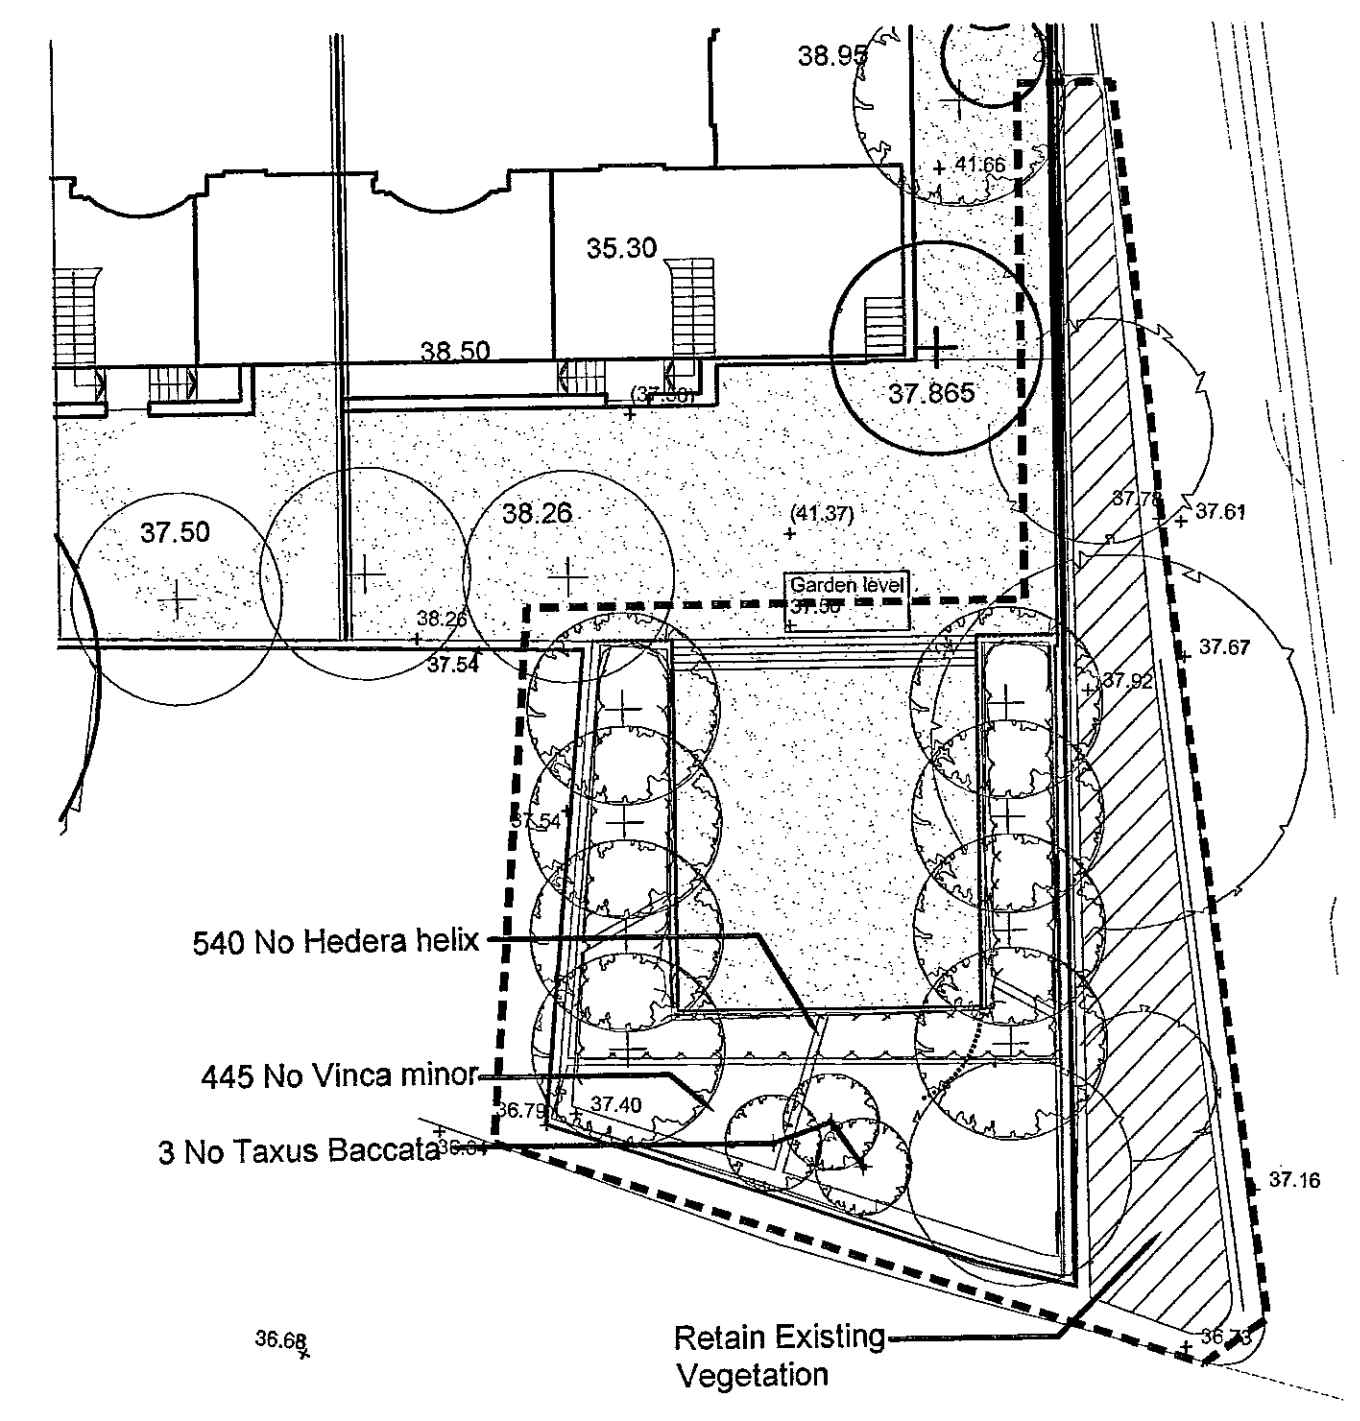

Planting Plan Area D
Scale 1:200

PLANT SCHEDULE

Species	Form/Notes	Girth (cm)	Height (cm)	Condition	Container	Clear Stem (cm)	Breaks	Quantity
Aralia elata	Multi-Stem, min 3 Leaders	-	300-350	RB	-	-	5	6
Alnus incana	EHS	14-18	425-600	RB	-	175-200	-	1
Betula pendula	-	18-20	-	RB	-	-	5	4
Betula pubescens	-	18-20	-	RB	-	-	6	6
Betula utilis	Multi-Stem, min 3 Leaders	-	250-300	RB	-	Multi Stem	-	1
Betula utilis 'Jaquemonii'	-	20-25	-	RB	-	-	-	6
Cercis siliquastrum	Multi-Stem, min 3 Leaders	-	300-350	RB	-	Multi Stem	-	1
Cupressus sempervirens	-	-	200-250	C	To be approved	-	-	4
Fraxinus angustifolia 'Raywood'	-	20-25	-	RB	-	-	-	9
Fraxinus excelsior	-	18-20	-	RB	-	-	-	3
Ginkgo biloba	Existing - stored off site	-	-	-	-	-	-	5
Robinia pseudoacacia	-	20-25	-	RB	-	-	-	2
Robinia pseudoacacia 'Frisia'	-	25-30	-	RB	-	-	-	1
Tilia cordata	-	20-25	-	RB	-	-	-	4
Tilia pallida	2m Square Crown	40-45	450-500	RB	-	220	-	12

Species	Height (cm)	Root	Container	Form / Notes	Density (Spot)	Breaks	Quantity
Aralia elata	150	C	25L	Multi-Stem, 3 Leaders	2	10	87
Berberis thunbergii 'Atrorpurea'	60-80	C	15L	Bushy	3	5	42
Choisya ternata 'Sundance'	40-60	C	7.5L	Bushy	Spot	-	4
Cornus florida 'Rainbow'	175-200	D	50L	Specimen	2	9	37
Hebe 'Mrs Winder'	40-60	C	15L	Bushy	1	15	10
Hydrangea aspera	100	C	15L	Bushy	3	-	16
Hydrangea serrata 'Bluebird'	40-60	C	2.5L	-	Spot	18	20
Laurus nobilis	120	C	20L	Ball Form, Spiral Stem, Standard	1	4	3
Lavandula stoechas	30-40	C	3L	Bushy	8	5	332
Mahonia x media 'Charity'	60-80	C	15L	3-4 Leaders	3	7	42
Pieris japonica	40x40	C	7.5L	-	1	4	3
Prunus laurocerasus 'Otto Luyken'	30-40	C	7.5L	-	3	5	47
Rhododendron yakushimanum	40-60	C	5L	Pink Flowers	3	-	14
Rosmarinus officinalis	40-60	C	7.5L	-	4	6	24
Santolina chamaecyparissus	20-30	C	2L	-	8	-	195
Sarcococca confusa	20-30	C	3L	-	8	7	141
Sierimtia japonica	40-60	C	15L	-	2	10	54
Taxus baccata	100-125	C	25L	Pyramid Specimen	Spot	-	19
Viburnum davidii	20-30	C	3L	-	5	3	75
Viburnum tinus 'Eve Price'	60x40	C	15L	-	1.5	8	38


Species	Height (cm)	Root	Container	Form / Notes	Density (Linear m)	Breaks	Quantity
Buxus sempervirens	50x30	C	15L	singles - clipped after planting	3	-	384
Prunus laurocerasus 'Otto Luyken'	30-40	C	7.5L	singles - clipped after planting	3	-	18
Taxus baccata	90-100x50	C	15L	Hedging	2.5	-	405

Species	Density (m2)	Condition	Container	Notes	Quantity of
Acanthus spinosus	8	C	3L	-	38
Aralia x arandifolia 'Rainland'	12	C	2L	-	18
Chamaemelum nobile	16	C	2L	-	104
Dianthus spectabilis	8	C	2L	-	146
Luzula nivea	12	C	2L	-	9
Lychnis coronaria	8	C	2L	-	128
Pachysandra terminalis	8	C	2L	-	50
Polystichum seiffertianum	8	C	3L	-	118
Primula bulleyana	12	C	2L	-	12
Stachys byzantium	12	C	2L	-	18
Stachys lanata	12	C	2L	-	72
Tiarella cordifolia	12	C	2L	-	75
Vinca minor	12	C	3L	-	944

Species	Height (cm)	Root	Container	Form / Notes	Density (m2)	Breaks	Quantity
Hedera helix	40-60	C	3L	Ground cover	12	3	2695
Hedera helix 'Glacier'	40-60	C	2L	Ground cover	12	3	100
Vitis colignatae	60-80	C	2L	Grown against wall	1.1m	2	30



Species	Form / Notes	Density (m2)	Quantity
Tulipa 'Purple Queen'	Flowering alba bulbs	16	16

LEGEND

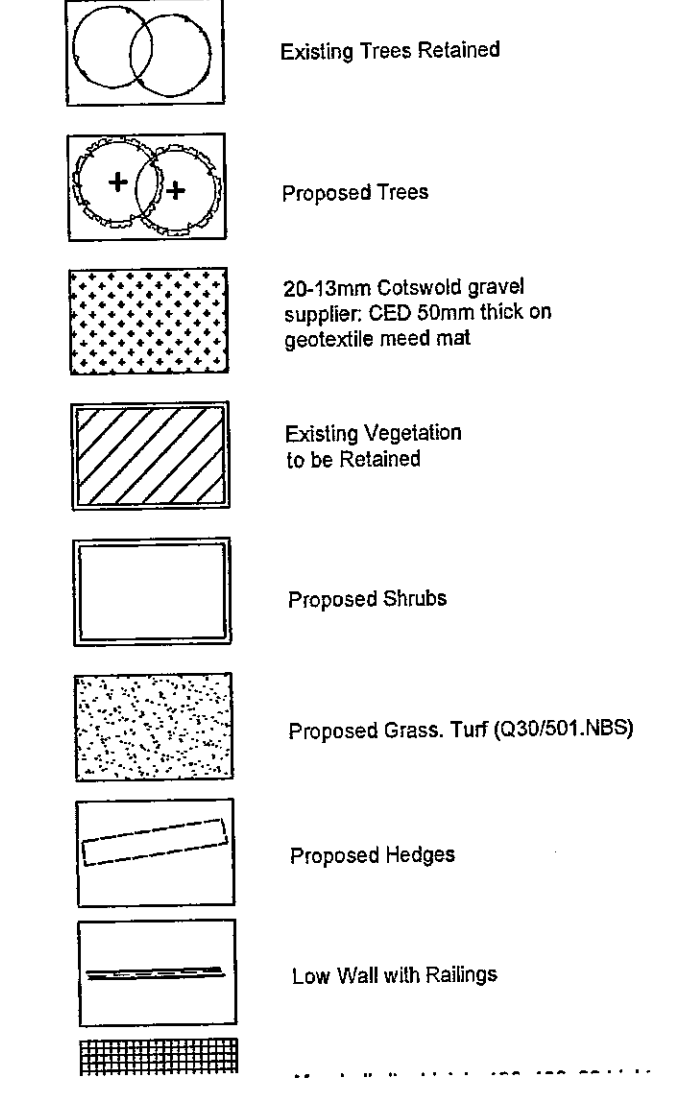

Notes:

- Refer to Drawing 10337/175 for details of trees and grass areas.
- Refer to Drawings 10337/172 and 173 for details of planting areas A and B.
- The Vitis in Area C is to be sited by the Landscape Architect at time of planting.
- Premium grade bark mulch to be applied to planting areas - applicable to drawings 10337/172, 173, 174, 175.

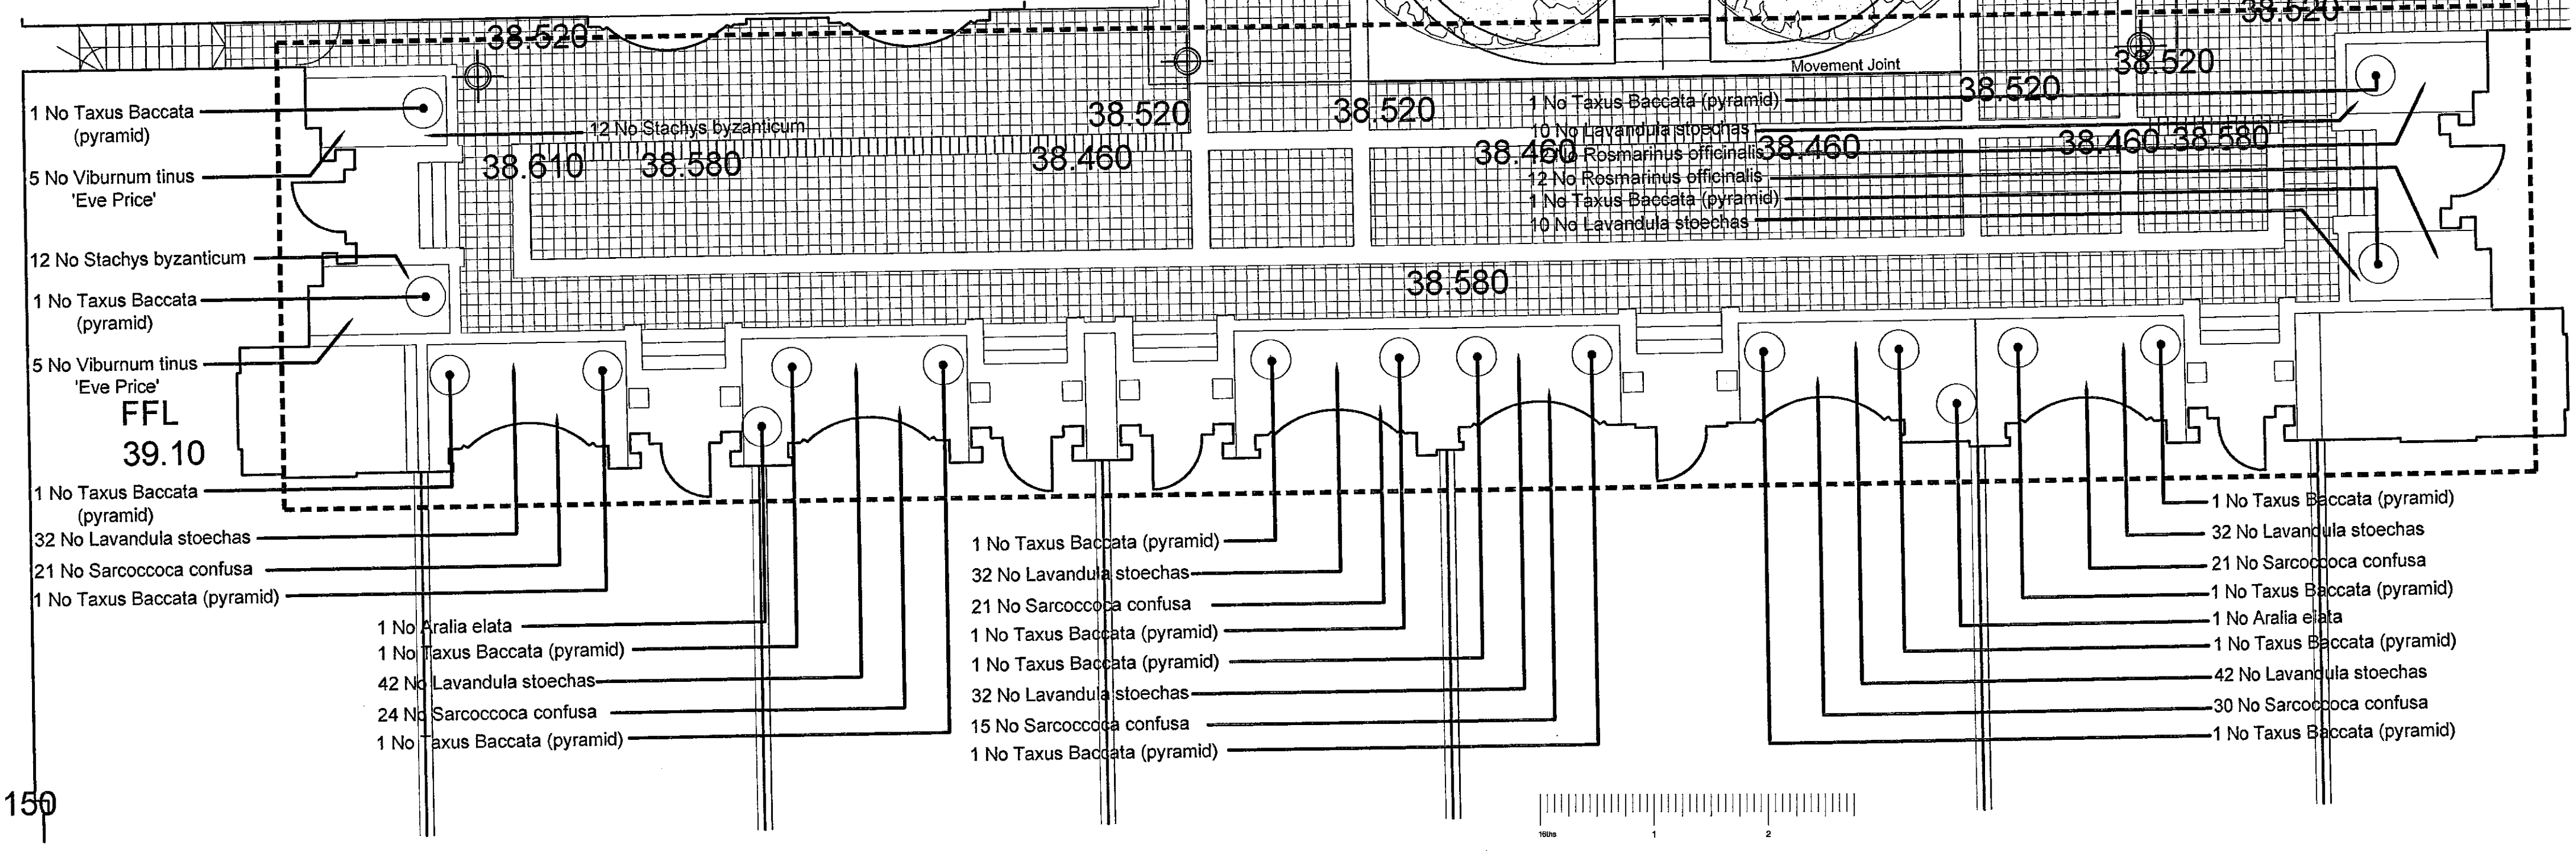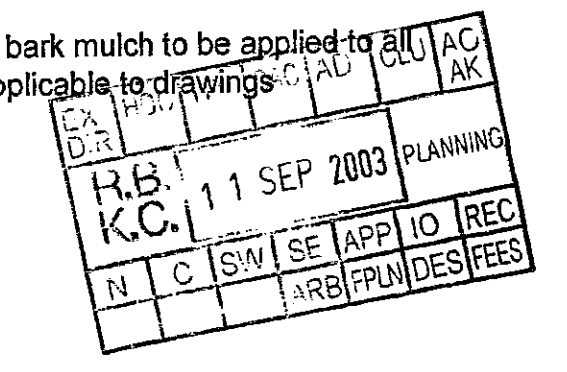

Planting Plan Area E
Scale 1:100

BroadwayMalyan Landscape

Unit 3 Weybridge Business Park
 Addlestone Road
 Weybridge, Surrey KT15 2BW
 T: +44(0)1932 845599
 F: +44(0)1932 846043
 E: bml@broadwaymalyan.com

Client

ST JAMES HOMES

Project

Aubrey Walk Campden Hill Res.

Description

**Planting Plan 3 of 4
 Areas C, D, E**

Status

CONSTRUCTION

Scale

Noted@A1

10337

Drawn

CPJ

174

Date

Sept 2003

Revision

B


Original size 100mm

Copyright Broadway Malyan Limited

NOTE on Drainage
 Refer to Whitty Bird and Partners drawing 16460/C/005/C2
 External works to include all drainage outlets in soft and hard areas at SSL level, including interface with waterproofing and mezzanine connections as well as road drainage at grade and on podium.
 All field drainage in soft areas to be varied out by soil contractor.

Contractors are not to scale dimensions from this drawing

Revision _____ Date _____

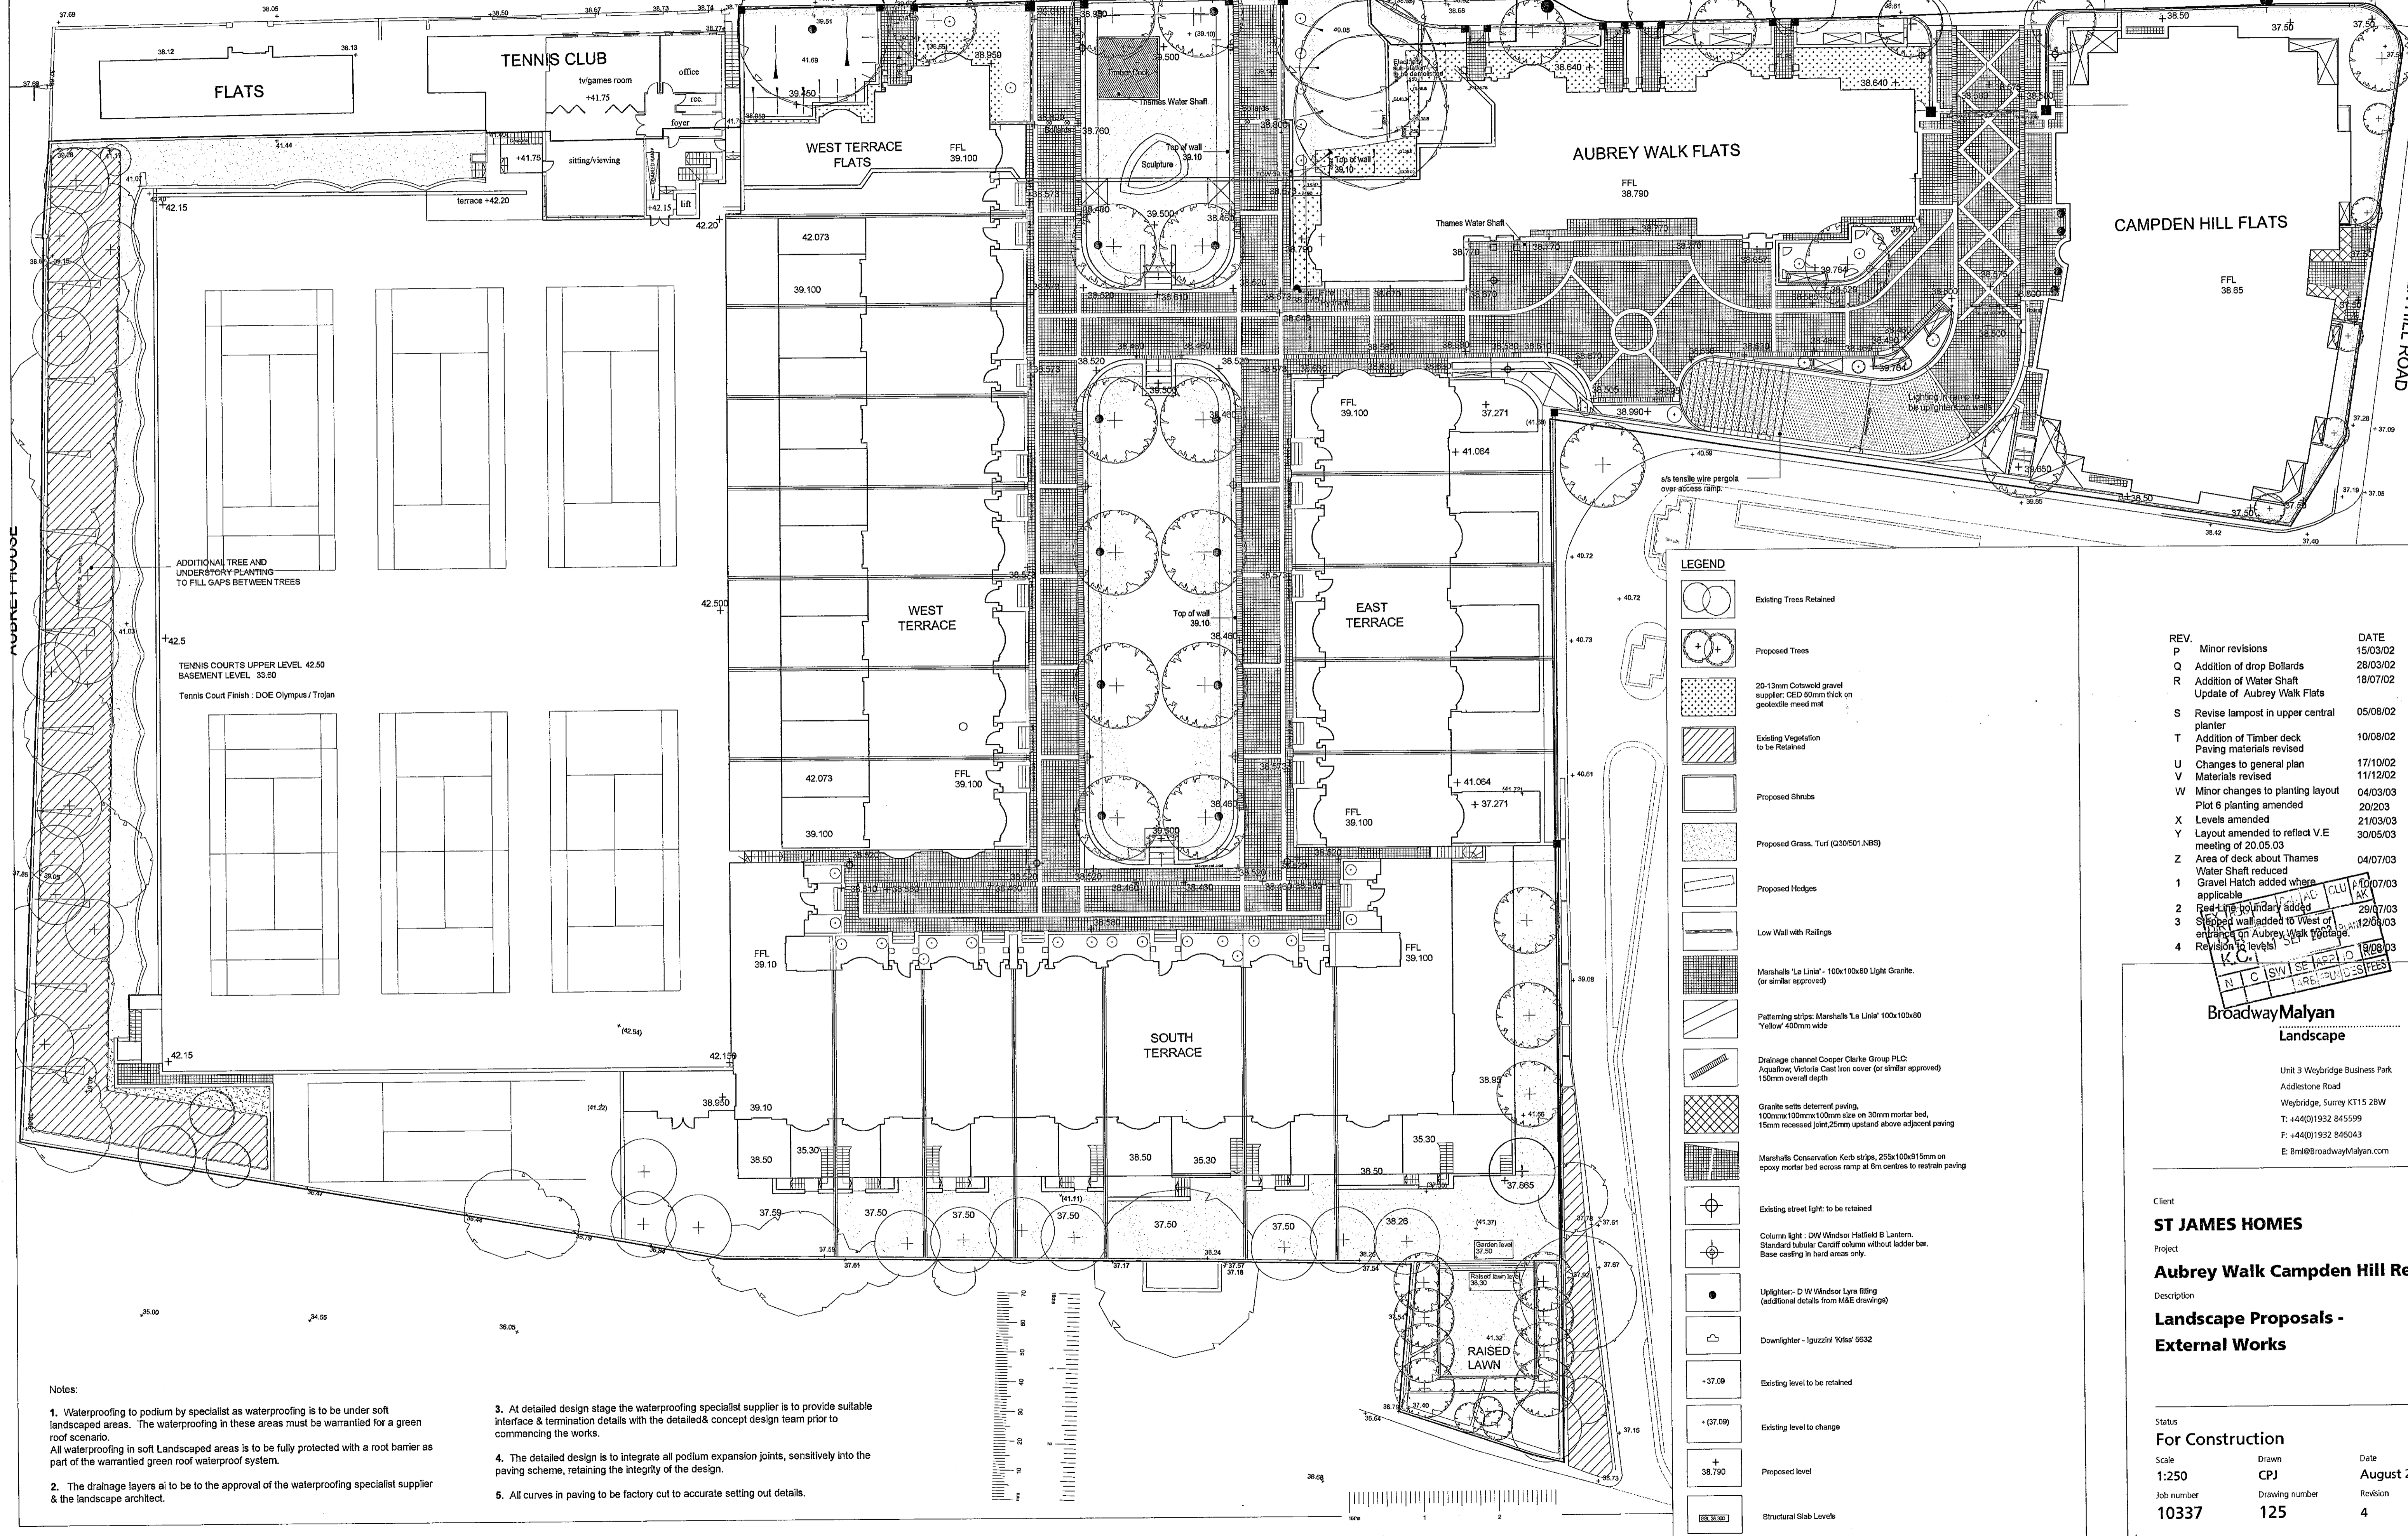

Notes:

1. Waterproofing to podium by specialist as waterproofing is to be under soft landscaped areas. The waterproofing in these areas must be warranted for a green roof scenario. All waterproofing in soft landscaped areas is to be fully protected with a root barrier as part of the warranted green roof waterproof system.
2. The drainage layers are to be to the approval of the waterproofing specialist supplier & the landscape architect.
3. At detailed design stage the waterproofing specialist supplier is to provide suitable interface & termination details with the detailed concept design team prior to commencing the works.
4. The detailed design is to integrate all podium expansion joints, sensitively into the paving scheme, retaining the integrity of the design.
5. All curves in paving to be factory cut to accurate setting out details.

- LEGEND**
- Existing Trees Retained
 - Proposed Trees
 - 20-30mm Coloured gravel supplier: CED 50mm thick on geotextile weed mat
 - Existing Vegetation to be Retained
 - Proposed Shrubs
 - Proposed Grass: Turf (G30501-2485)
 - Proposed Hedges
 - Low Wall with Railings
 - Marshall's 'La Lina' - 100x100x60 Light Granite (or similar approved)
 - Patterning strips: Marshall's 'La Lina' 100x100x60 'Yellow' 400mm wide
 - Drainage channel Cooper Clarke Group PLC: Aquaflo, Vitrified Cast Iron cover (or similar approved) 100mm overall depth
 - Granite setts deterring paving, 100mmx100mmx100mm size on 30mm mortar bed, 15mm recessed joint, 25mm upstand above adjacent paving
 - Marshall's Conservation Kerb strips, 255x100x15mm on epoxy mortar bed across ramp at 5m centres to restrict paving
 - Existing street light to be retained
 - Column light - DW Windsor Hatfield B Lantern. Standard tubular Cardiff column without ladder bar. Base casting in hard areas only.
 - Uplighter - DW Windsor Lyma fitting (additional details from M&E drawings)
 - Downlighter - Iguzzini 'Kite' 5632
 - Existing level to be retained
 - Existing level to change
 - Proposed level
 - Structural Slab Levels

REV.	Description	DATE
P	Minor revisions	15/03/02
Q	Addition of drop Bollards	28/03/02
R	Addition of Water Shaft Update of Aubrey Walk Flats	18/07/02
S	Revise lamppost in upper central planter	05/08/02
T	Addition of Timber deck Paving materials revised	10/08/02
U	Changes to general plan	17/10/02
V	Materials revised	11/12/02
W	Minor changes to planting layout Plot 6 planting amended	04/03/03
X	Levels amended	20/20/03
Y	Layout amended to reflect V.E meeting of 20.05.03	21/03/03
Z	Area of deck about Thames Water Shaft reduced	04/07/03
1	Gravel Hatch added where applicable	29/07/03
2	Red Line boundary added	29/07/03
3	Slashed wall added to West of entrance on Aubrey Walk Footage	12/08/03
4	Revision to levels	12/08/03

BroadwayMalyan
 Landscape

Unit 3 Weybridge Business Park
 Addlestone Road
 Weybridge, Surrey KT15 2BW
 T: +44(0)1932 845599
 F: +44(0)1932 845043
 E: EMail@broadwaymalyan.com

Client
ST JAMES HOMES

Project
Aubrey Walk Campden Hill Res.

Description
Landscape Proposals - External Works

Status
For Construction

Scale 1:250
 Job number 10337

Drawn CPJ
 Drawing number 125


Date August 2003
 Revision 4

Original size 100mm Copyright Broadway Malyan Limited

Contractors are not to scale dimensions from this drawing

Revision	Date
A Issued for Tender	16.12.02
B Amendments to walls and railings to reflect VE meetings	18.06.03
C Note added referencing Whiby Bird retaining wall details	03.07.03
1 Trellis to ramp amended, note regarding stepped wall added.	10.07.03


NOTE:
 Refer to BML-10337-90-520 for wall coping and capping unit details.
 Refer to BML-10337-90-525 for railing details.
 Refer to BML-10337-90-522 for section and details location plan.
 Refer to BML-10337-90-530 for tensile wire trellis details.
 Refer to Whiby Bird Drwg 16460/S/401 for retaining walls construction details.

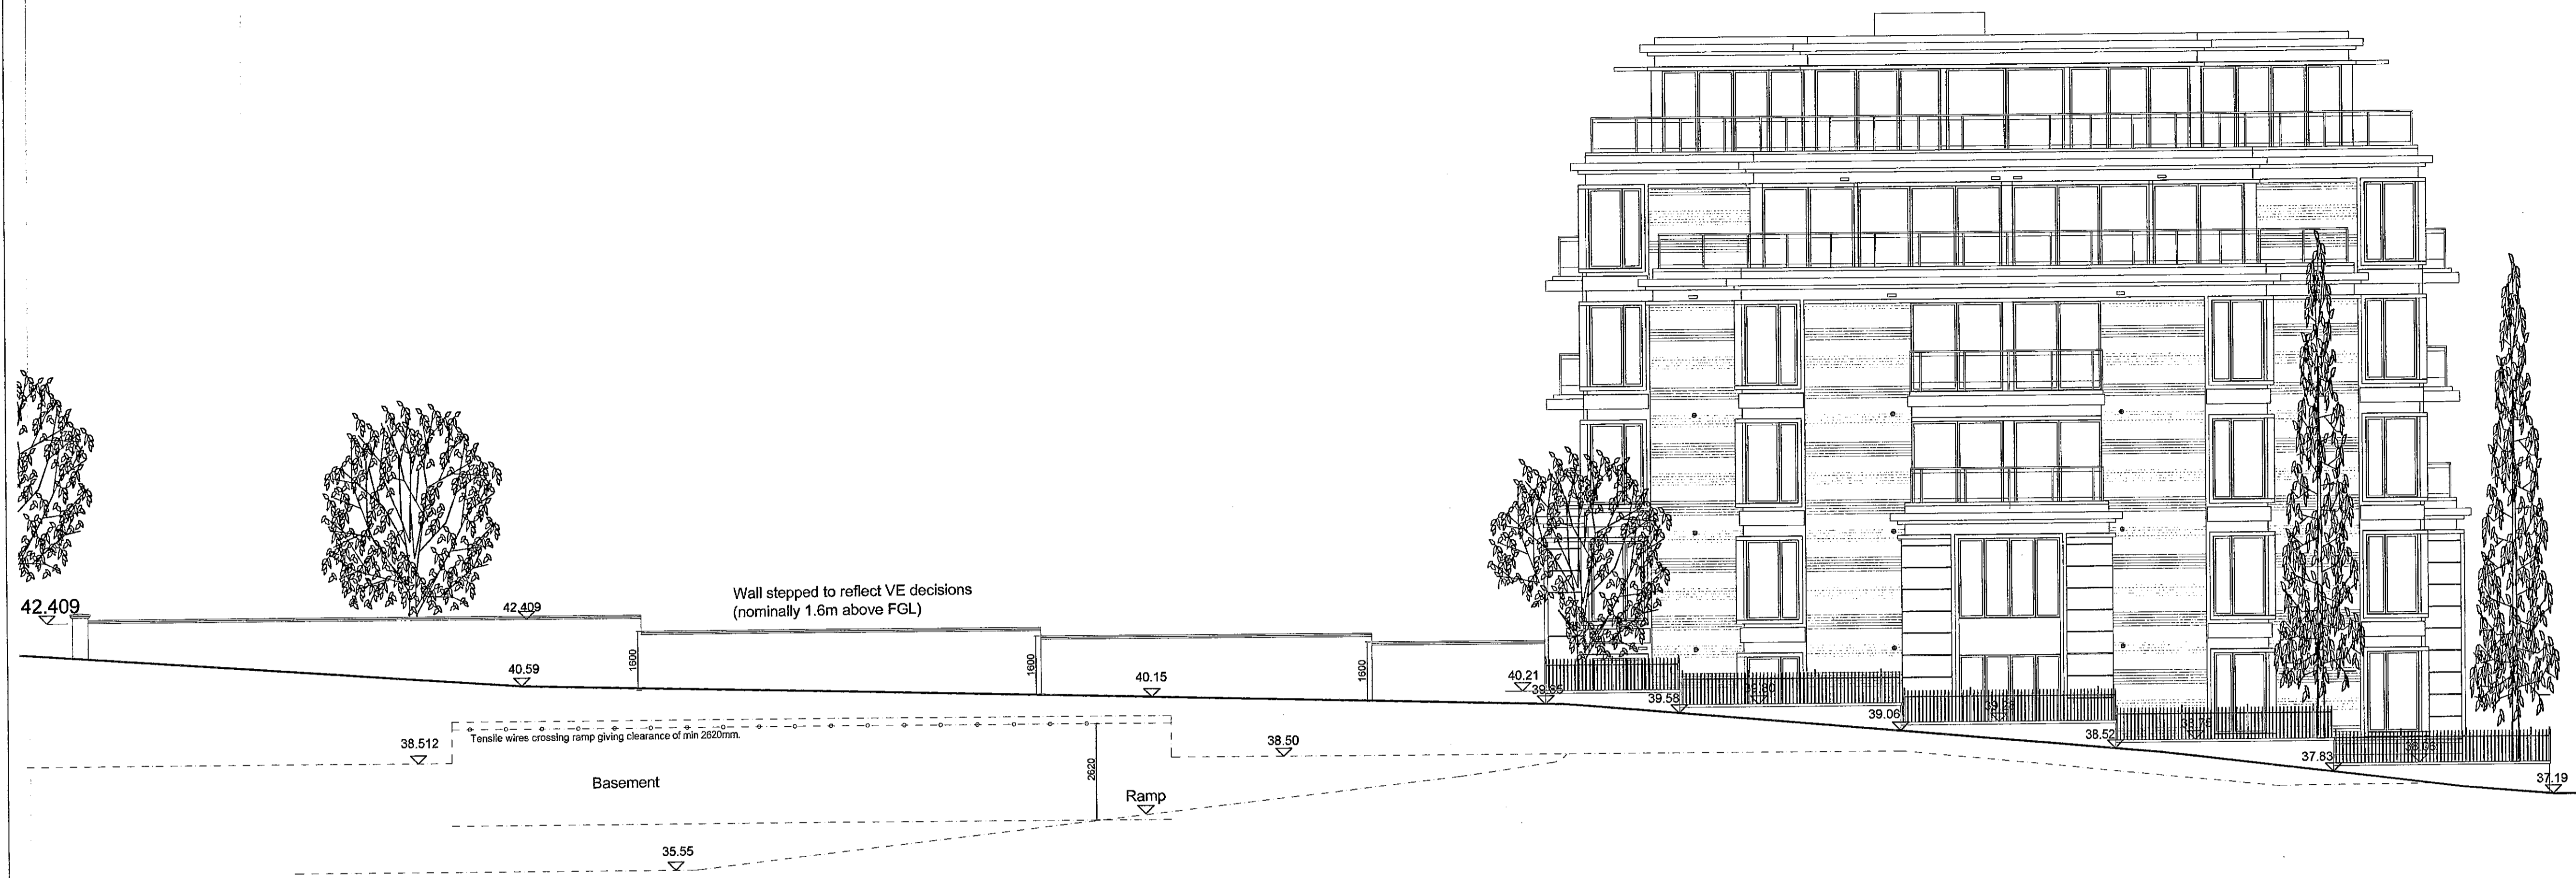

South elevation B-B from Kensington Heights
 Scale 1:100



East elevation C-C from Campden Hill Road
 Scale 1:100

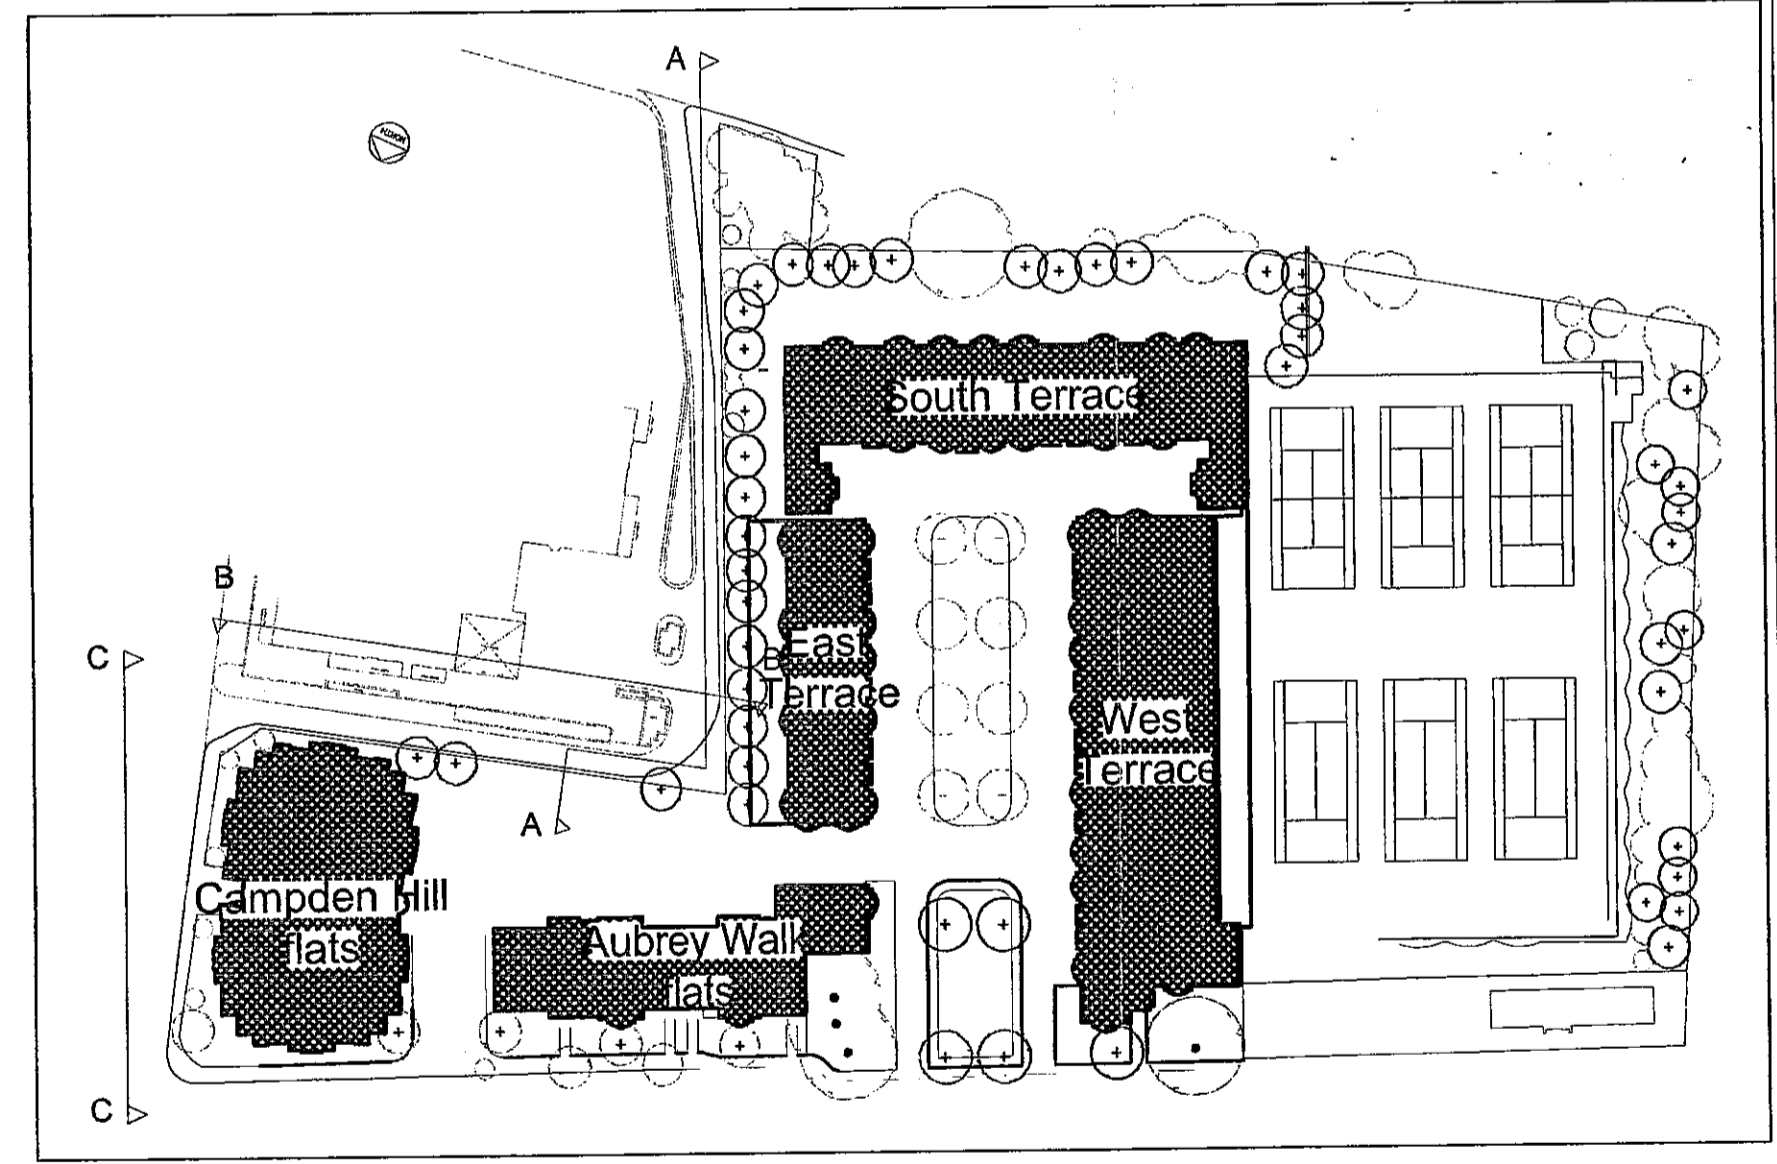

Siteplan
 Scale 1:1000

EX	DIR	TF	CON	PL	AG	PL
R.B. 11 SEP 2003						PLANNING
K.C.						
N	C	SW	SE	APP	NO	REC

BroadwayMalyan
 Landscape

Unit 3 Weybridge Business Park
 Addlestone Road
 Weybridge, Surrey KT15 2BW
 T: +44(0)1932 845599
 F: +44(0)1932 846043
 E: Bmrl@broadwaymalyan.com

Client
ST. JAMES HOMES


Project
Aubrey Walk Campden Hill Res.

Description
**Boundary Elevations
 Kensington Heights
 to Campden Hill Road**


Status
For Construction

Scale	Drawn	Date
Asshown(A1)	CPJ	July 2003
Job number	Drawing number	Revision
10337	151	1


Original size 100mm Copyright Broadway Malyan Limited

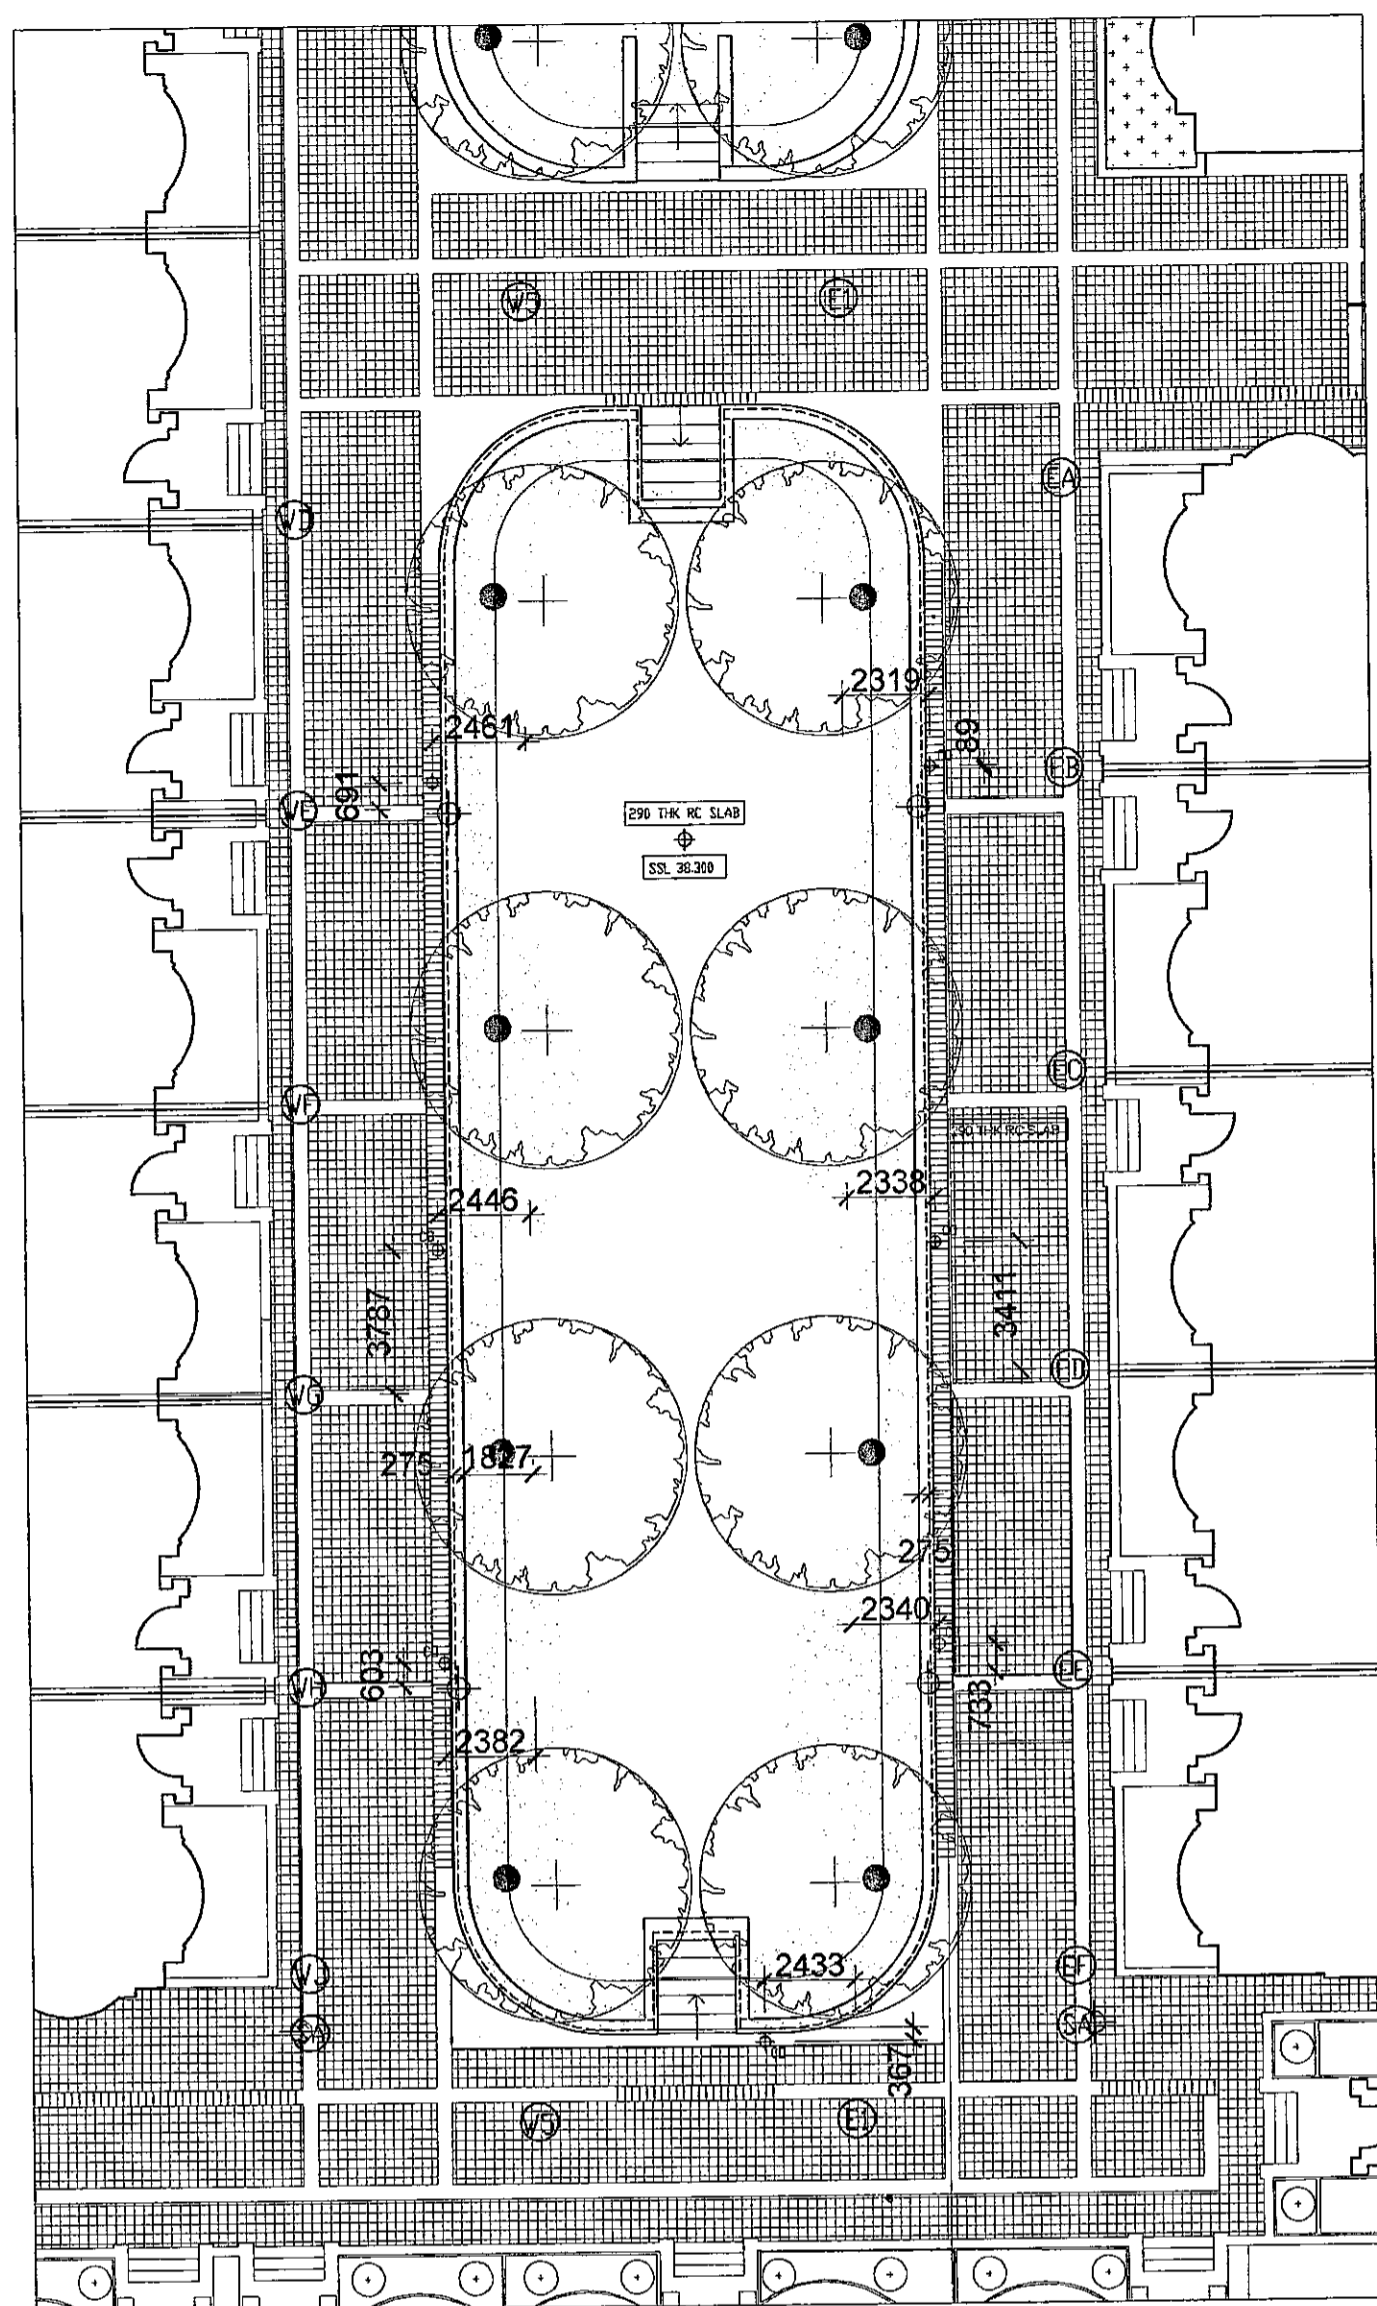


PLAN
Central planter
Scale 1:200

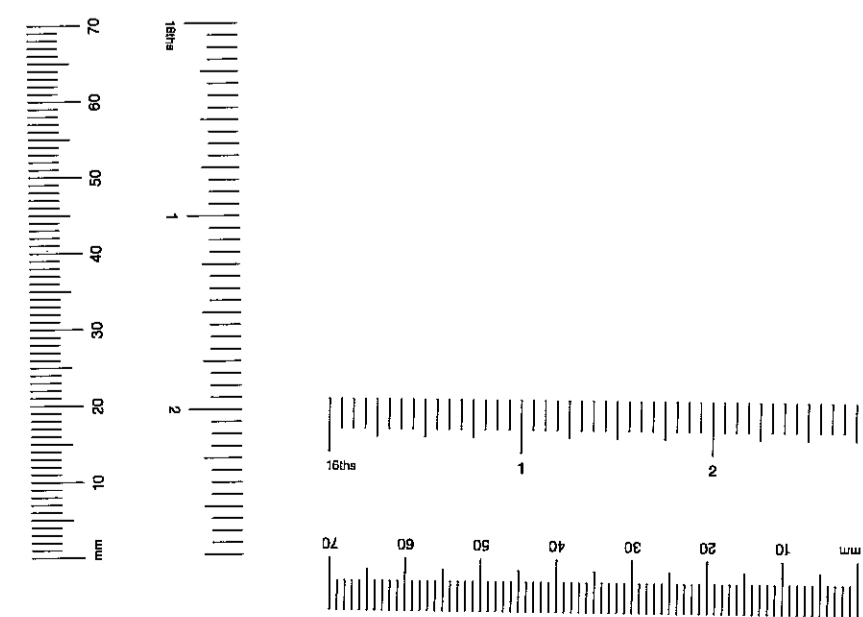

PLAN: Extended part of planter wall for Light column fixing Scale 1:10

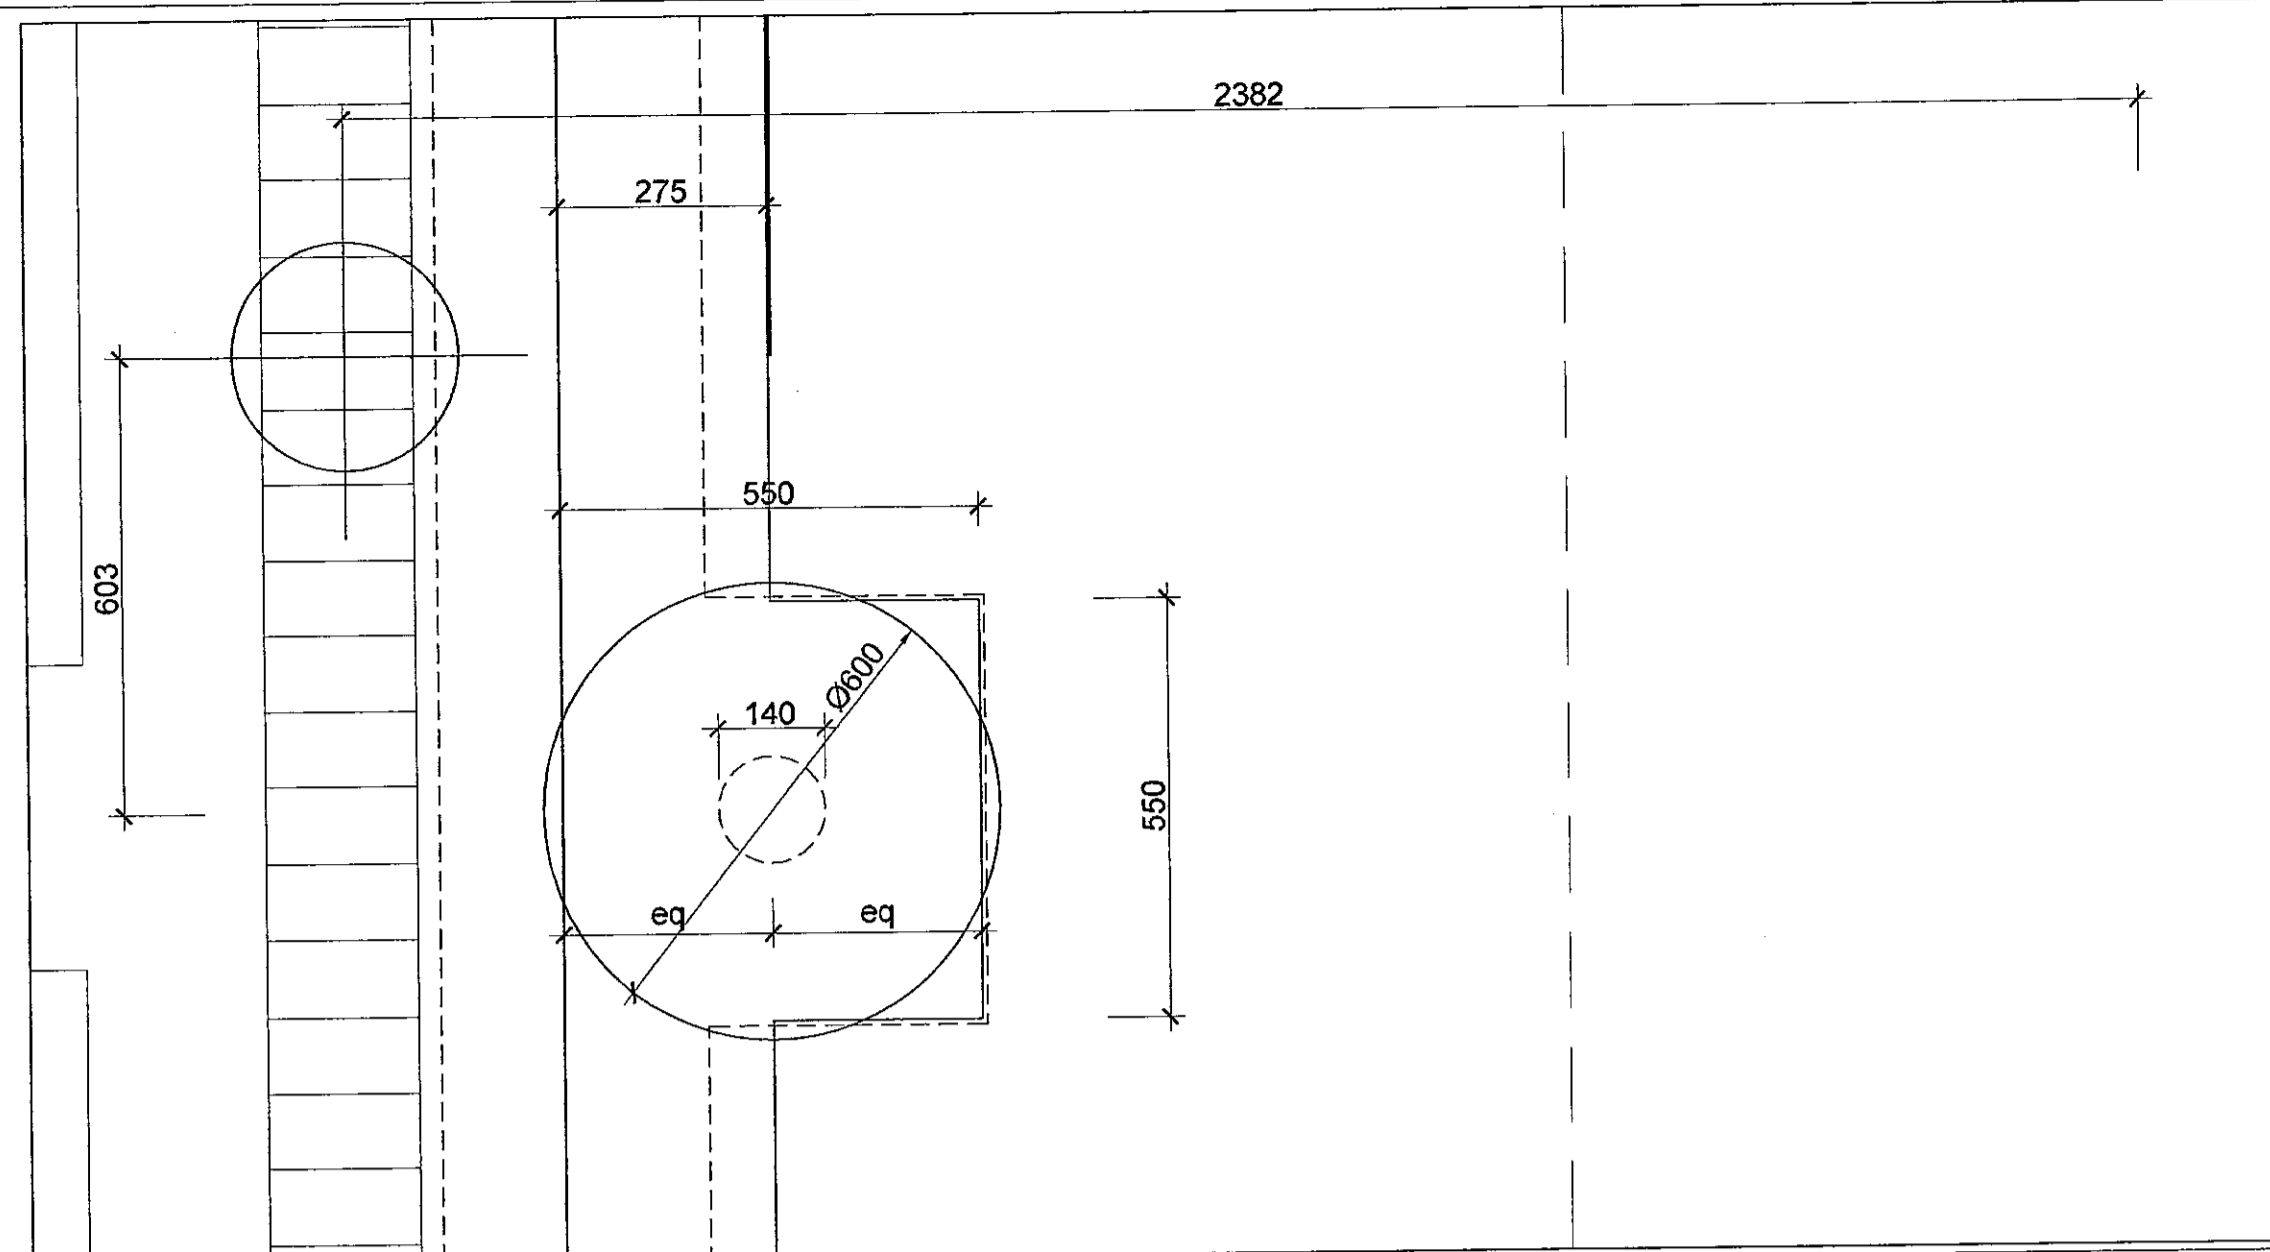


SECTION: Extended part of planter wall for Light column fixing Scale 1:10

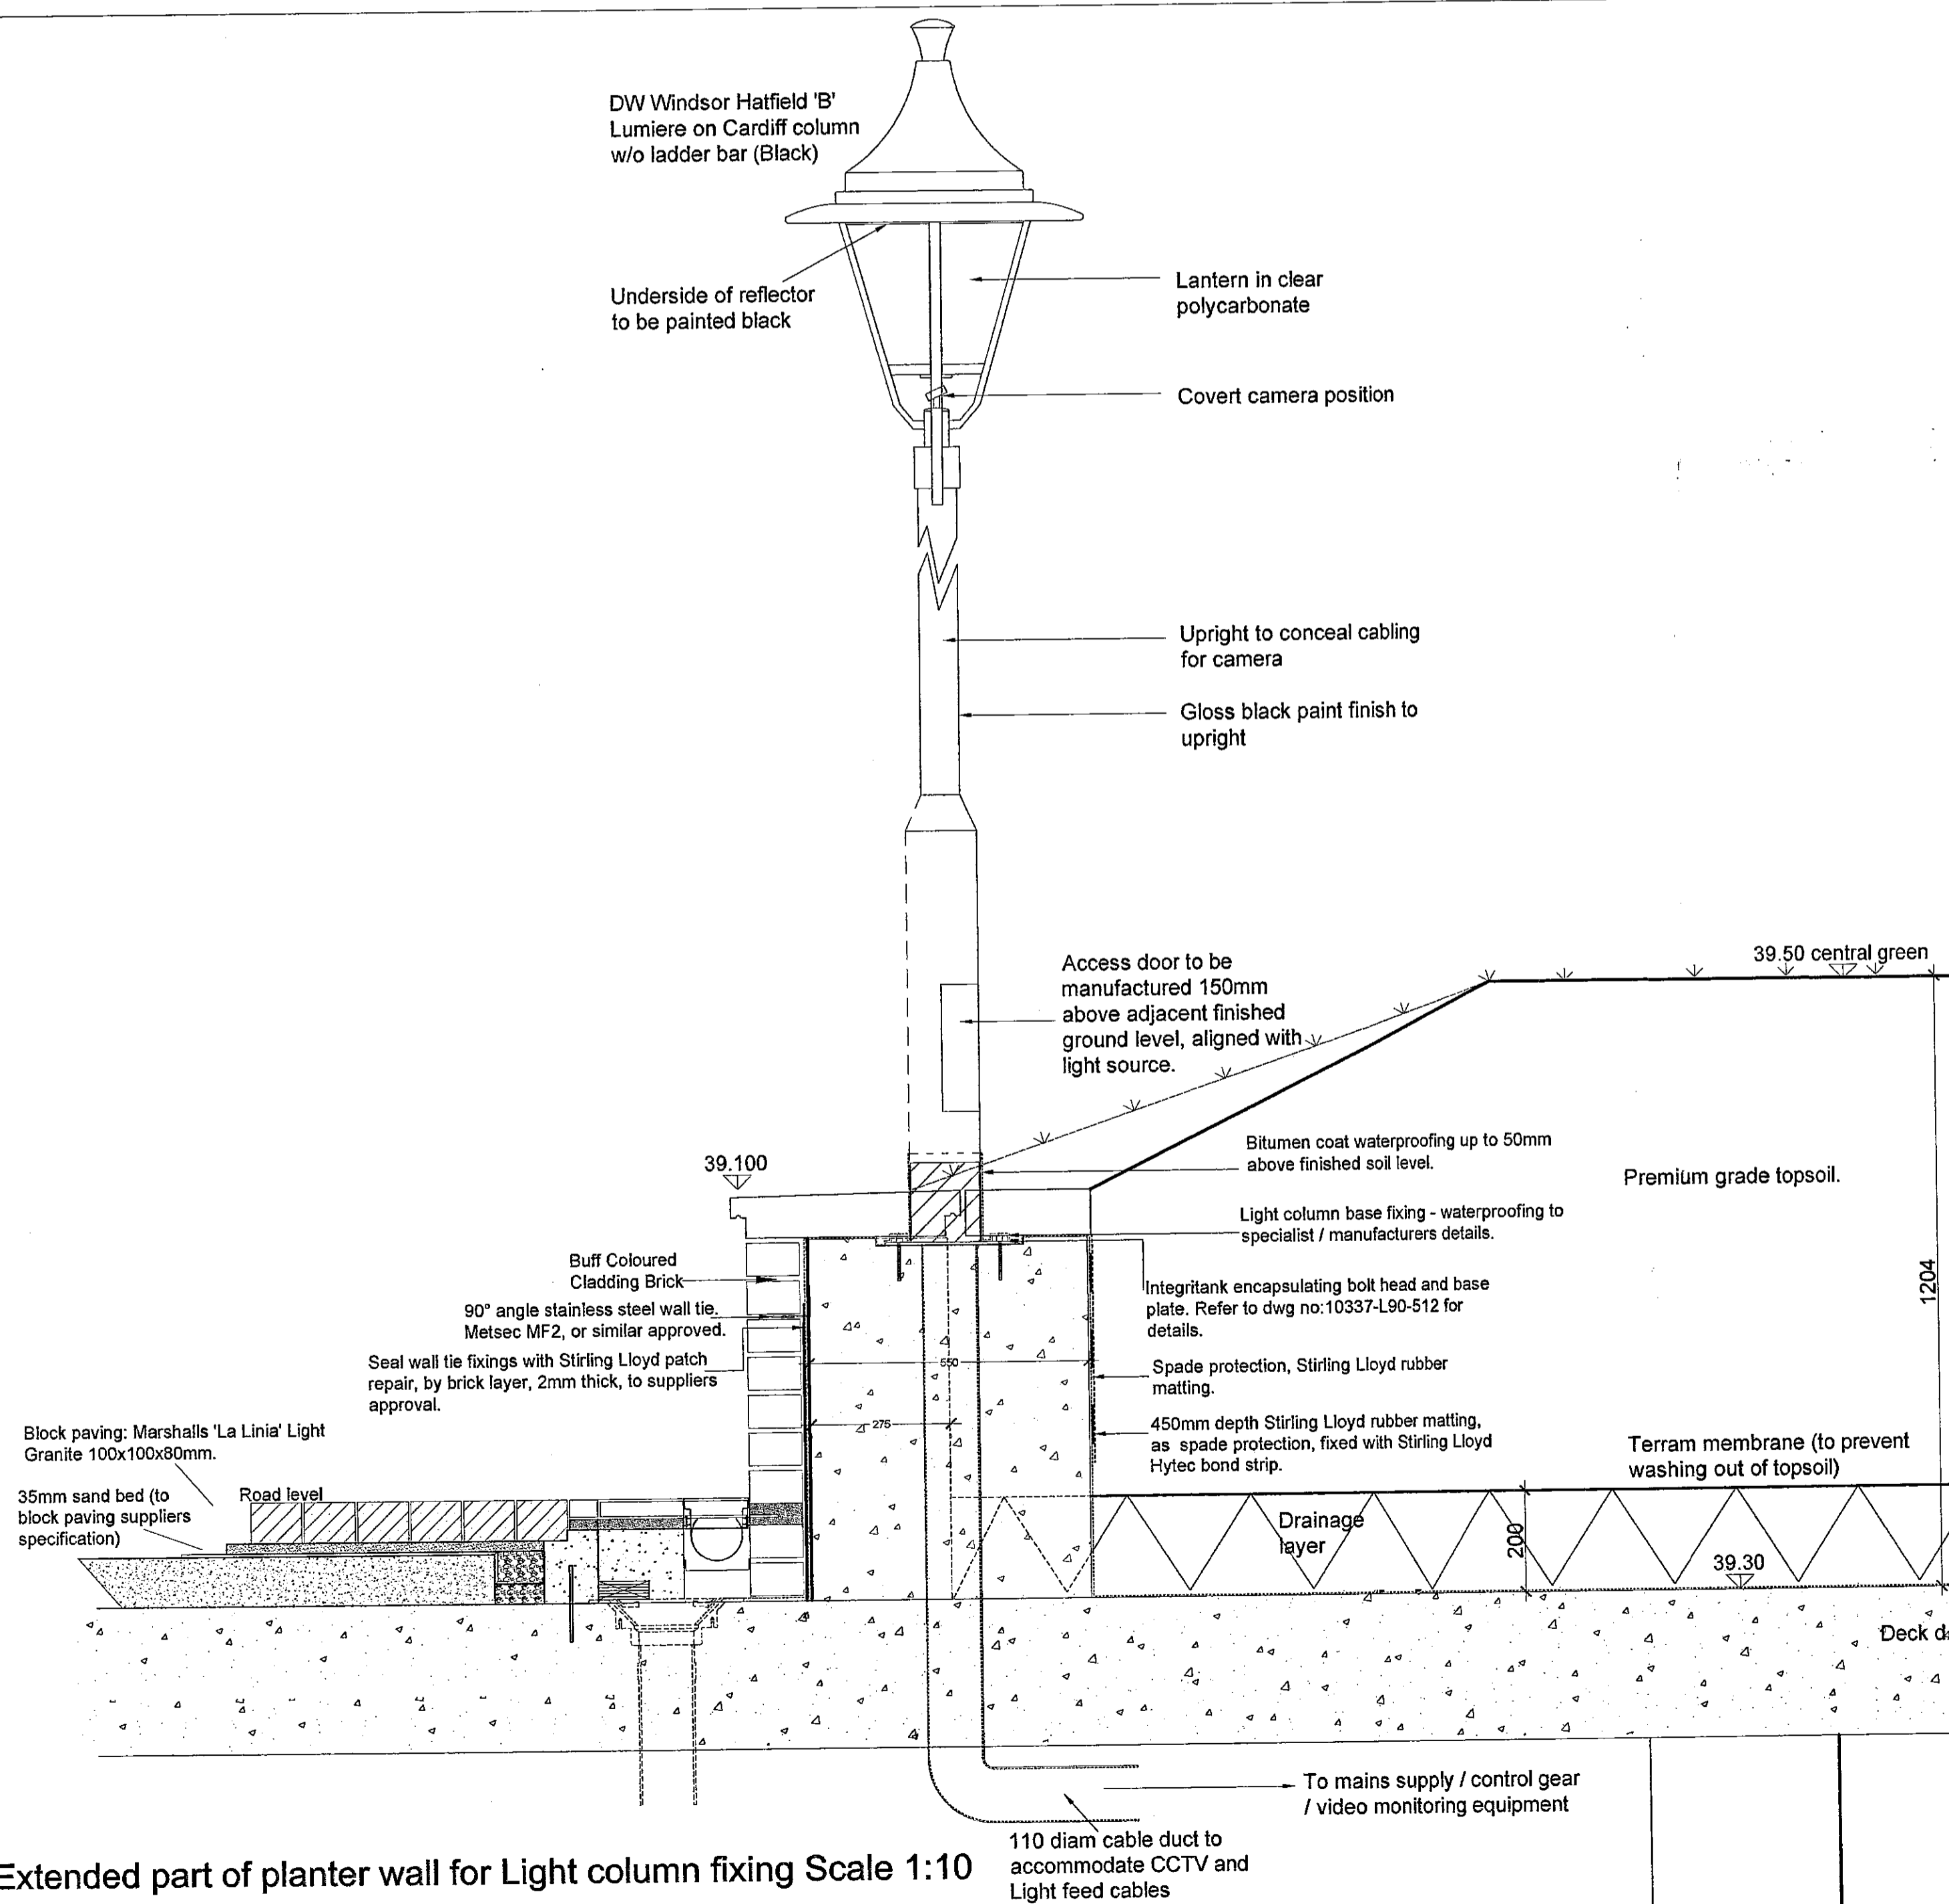

Contractors are not to scale dimensions from this drawing

Revision	Date
A : Information updated	16.12.99
B : Column position added	17.12.99
Information updated	
C : General revisions	20.01.00
D : Update to coping detail, land drainage omitted	22.02.00
E : Podium deck straightened, copings amended	14.03.00
F : Levels updated, minor amendments	12.4.00
G : Waterproof revision	12.4.00
H : Issue for Tender	15.3.02
J : Drainage revised	17.07.02
K : Material moved, lighting added	06.08.02
L : Lighting column height revised	14.10.02
M : Revisions to reflect VE meetings	18.06.03
N : Top soil spec. removed, refer to full spec.01.07.03	
O : Lighting columns amended to reflect VE meetings, Note added referencing Whitby Bird retaining wall details.	03.07.03
1: For Construction	
Drawing amended to include DPC on planter wall and revised planter drainage and topsoil spec.	10.07.03
2: For Construction	
Drawing amended to include Integritank on lighting duct and rubber matting, spade protection.	13.08.03
3: For Construction	
Drawing sheet simplified, drainage details updated.	29.08.03

NOTE:
Refer to BML-10337-L-90-125 for latest scheme layout.
Refer to BML-10337-90-520 for wall coping and capping unit details.
Refer to BML-10337-90-525 for railing details.
Refer to BML-10337-90-522 for section and details location plan.
Refer to Whitby Bird Drwg 16460/S/401 for retaining walls construction details.
Refer to BML - 10337-L-90-512 for Light fixing details.
Refer to BML-10337-L-90-533 for wall expansion joints and wall tie details.
Waterproofing details to meet with Stirling Lloyd approval.

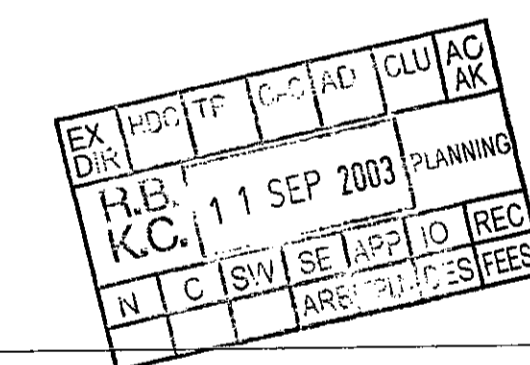

BroadwayMalyan
Landscape

Woburn Hill, Addlestone
Weybridge, Surrey KT15 2QA
T: +44(0)1932 845599
F: +44(0)1932 846043
E: Bml@broadwaymalyan.com

Client

St.James Homes

Project

Aubrey Walk Campden Res.

Description

**Landscape Proposals
Raised Planter Details
Planter Wall at Light Column**

Status

For Construction

Scale	Drawn	Date
As shown @ A1	JMS	Aug. 2003
Job number	Drawing number	Revision
10337	160	3


Original size 100mm Copyright Broadway Malyan Limited

TP/99/0733(37)


Contractors are not to scale dimensions from this drawing

Revision	Date
A Note added	GK 29.05.03


- Note:**
- All plants to comply with N.P.S. criteria.
 - Existing walls based on BML site measure. Levels and setting out to be confirmed by as built survey prior to construction.

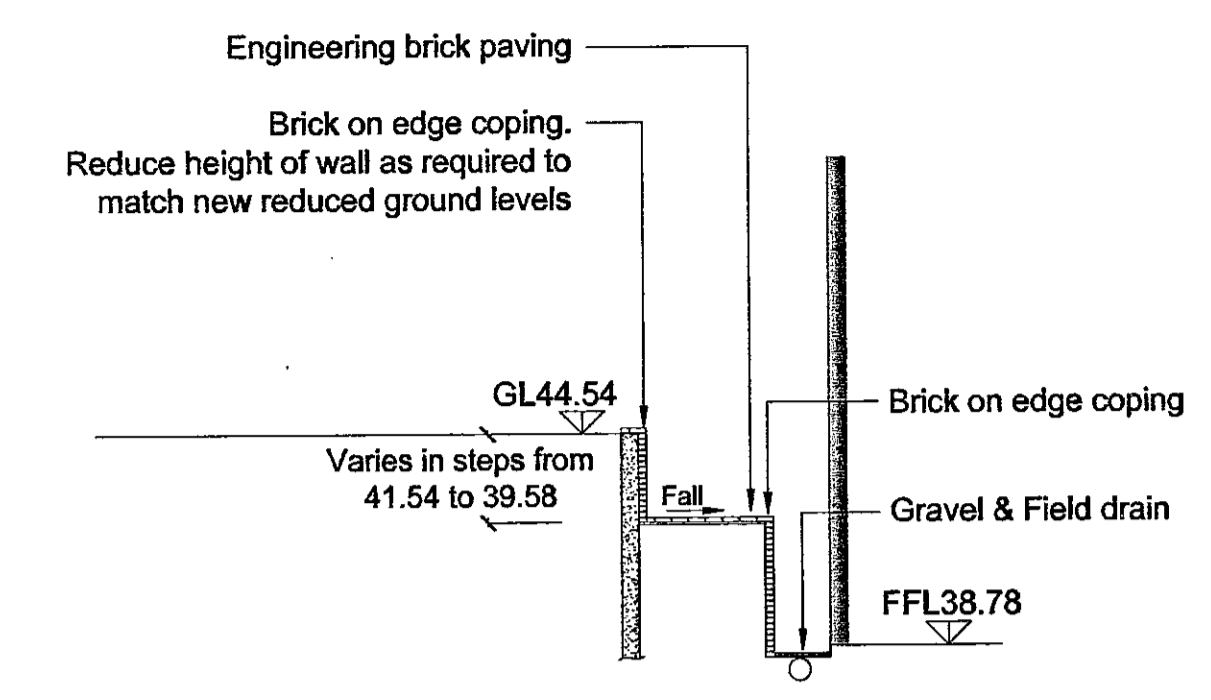


Section A-A' - Proposed
Scale 1:100

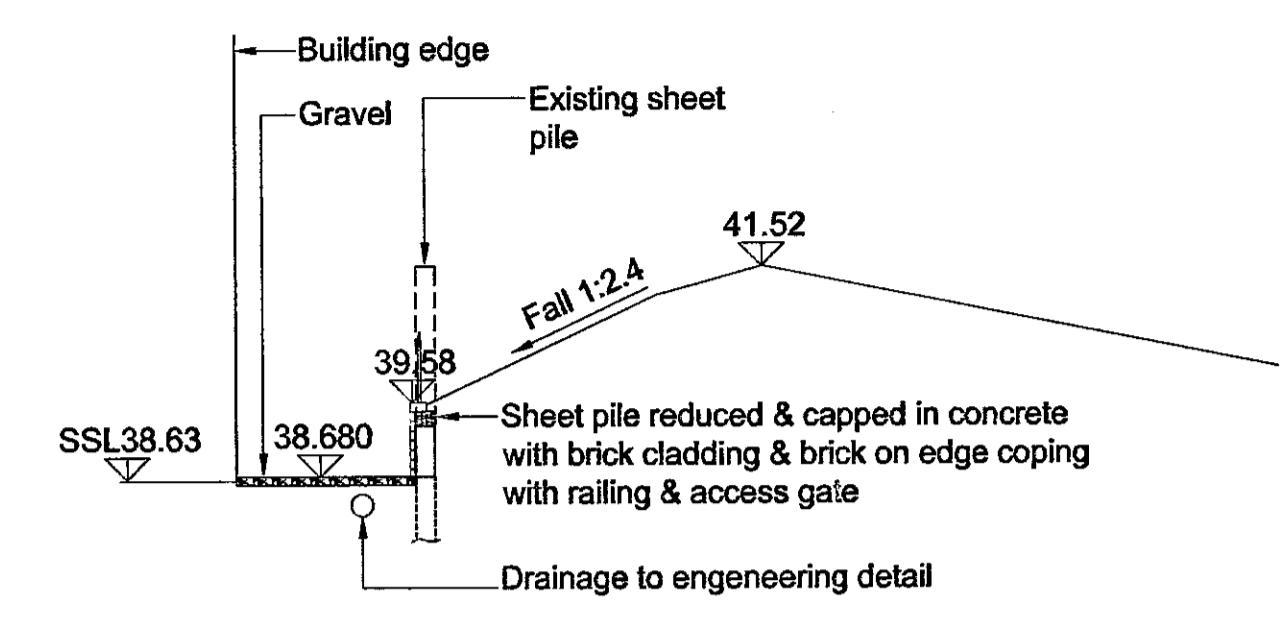


Section B-B' - Proposed
Scale 1:100

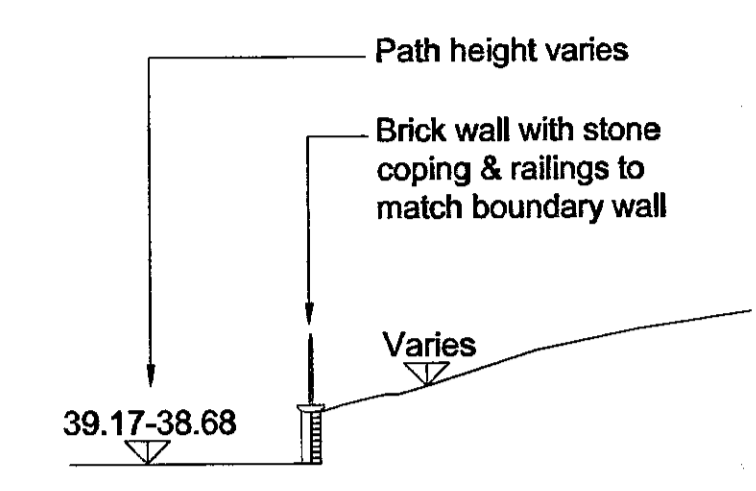


Section C-C' - Proposed
Scale 1:100

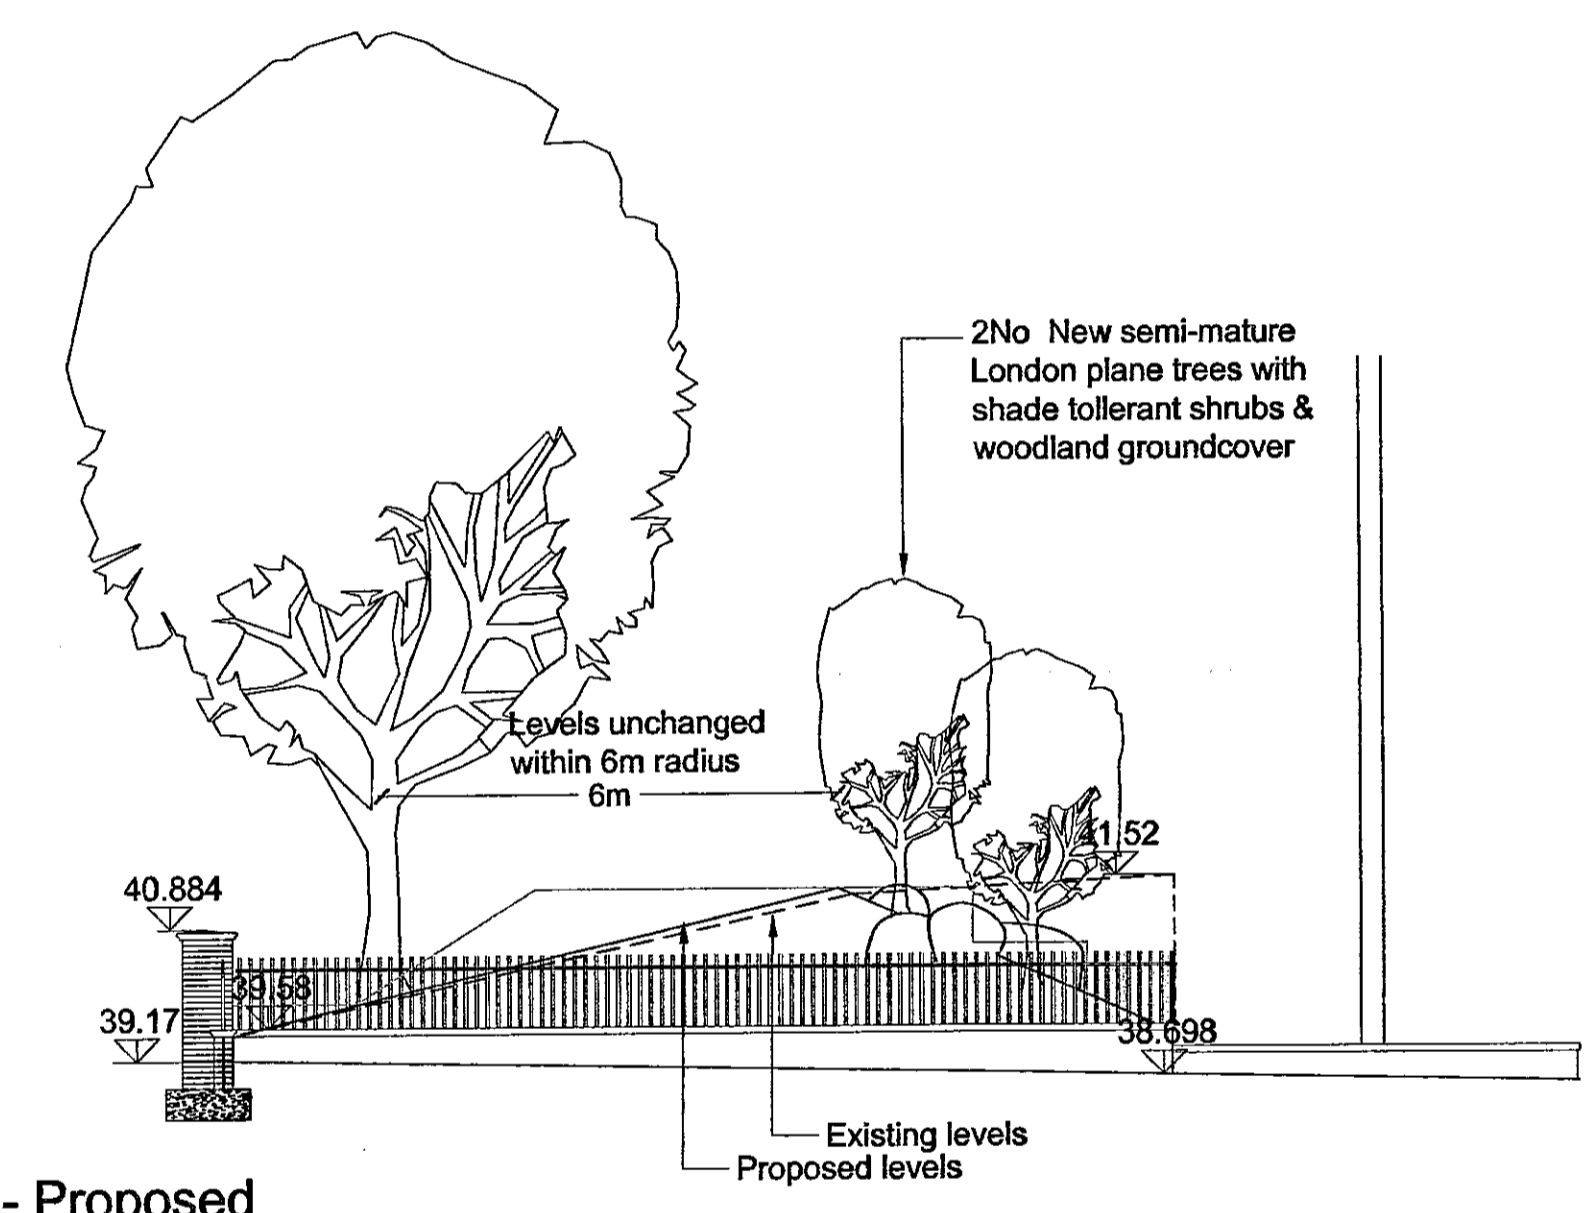



Elevation D-D' - Proposed
Scale 1:100

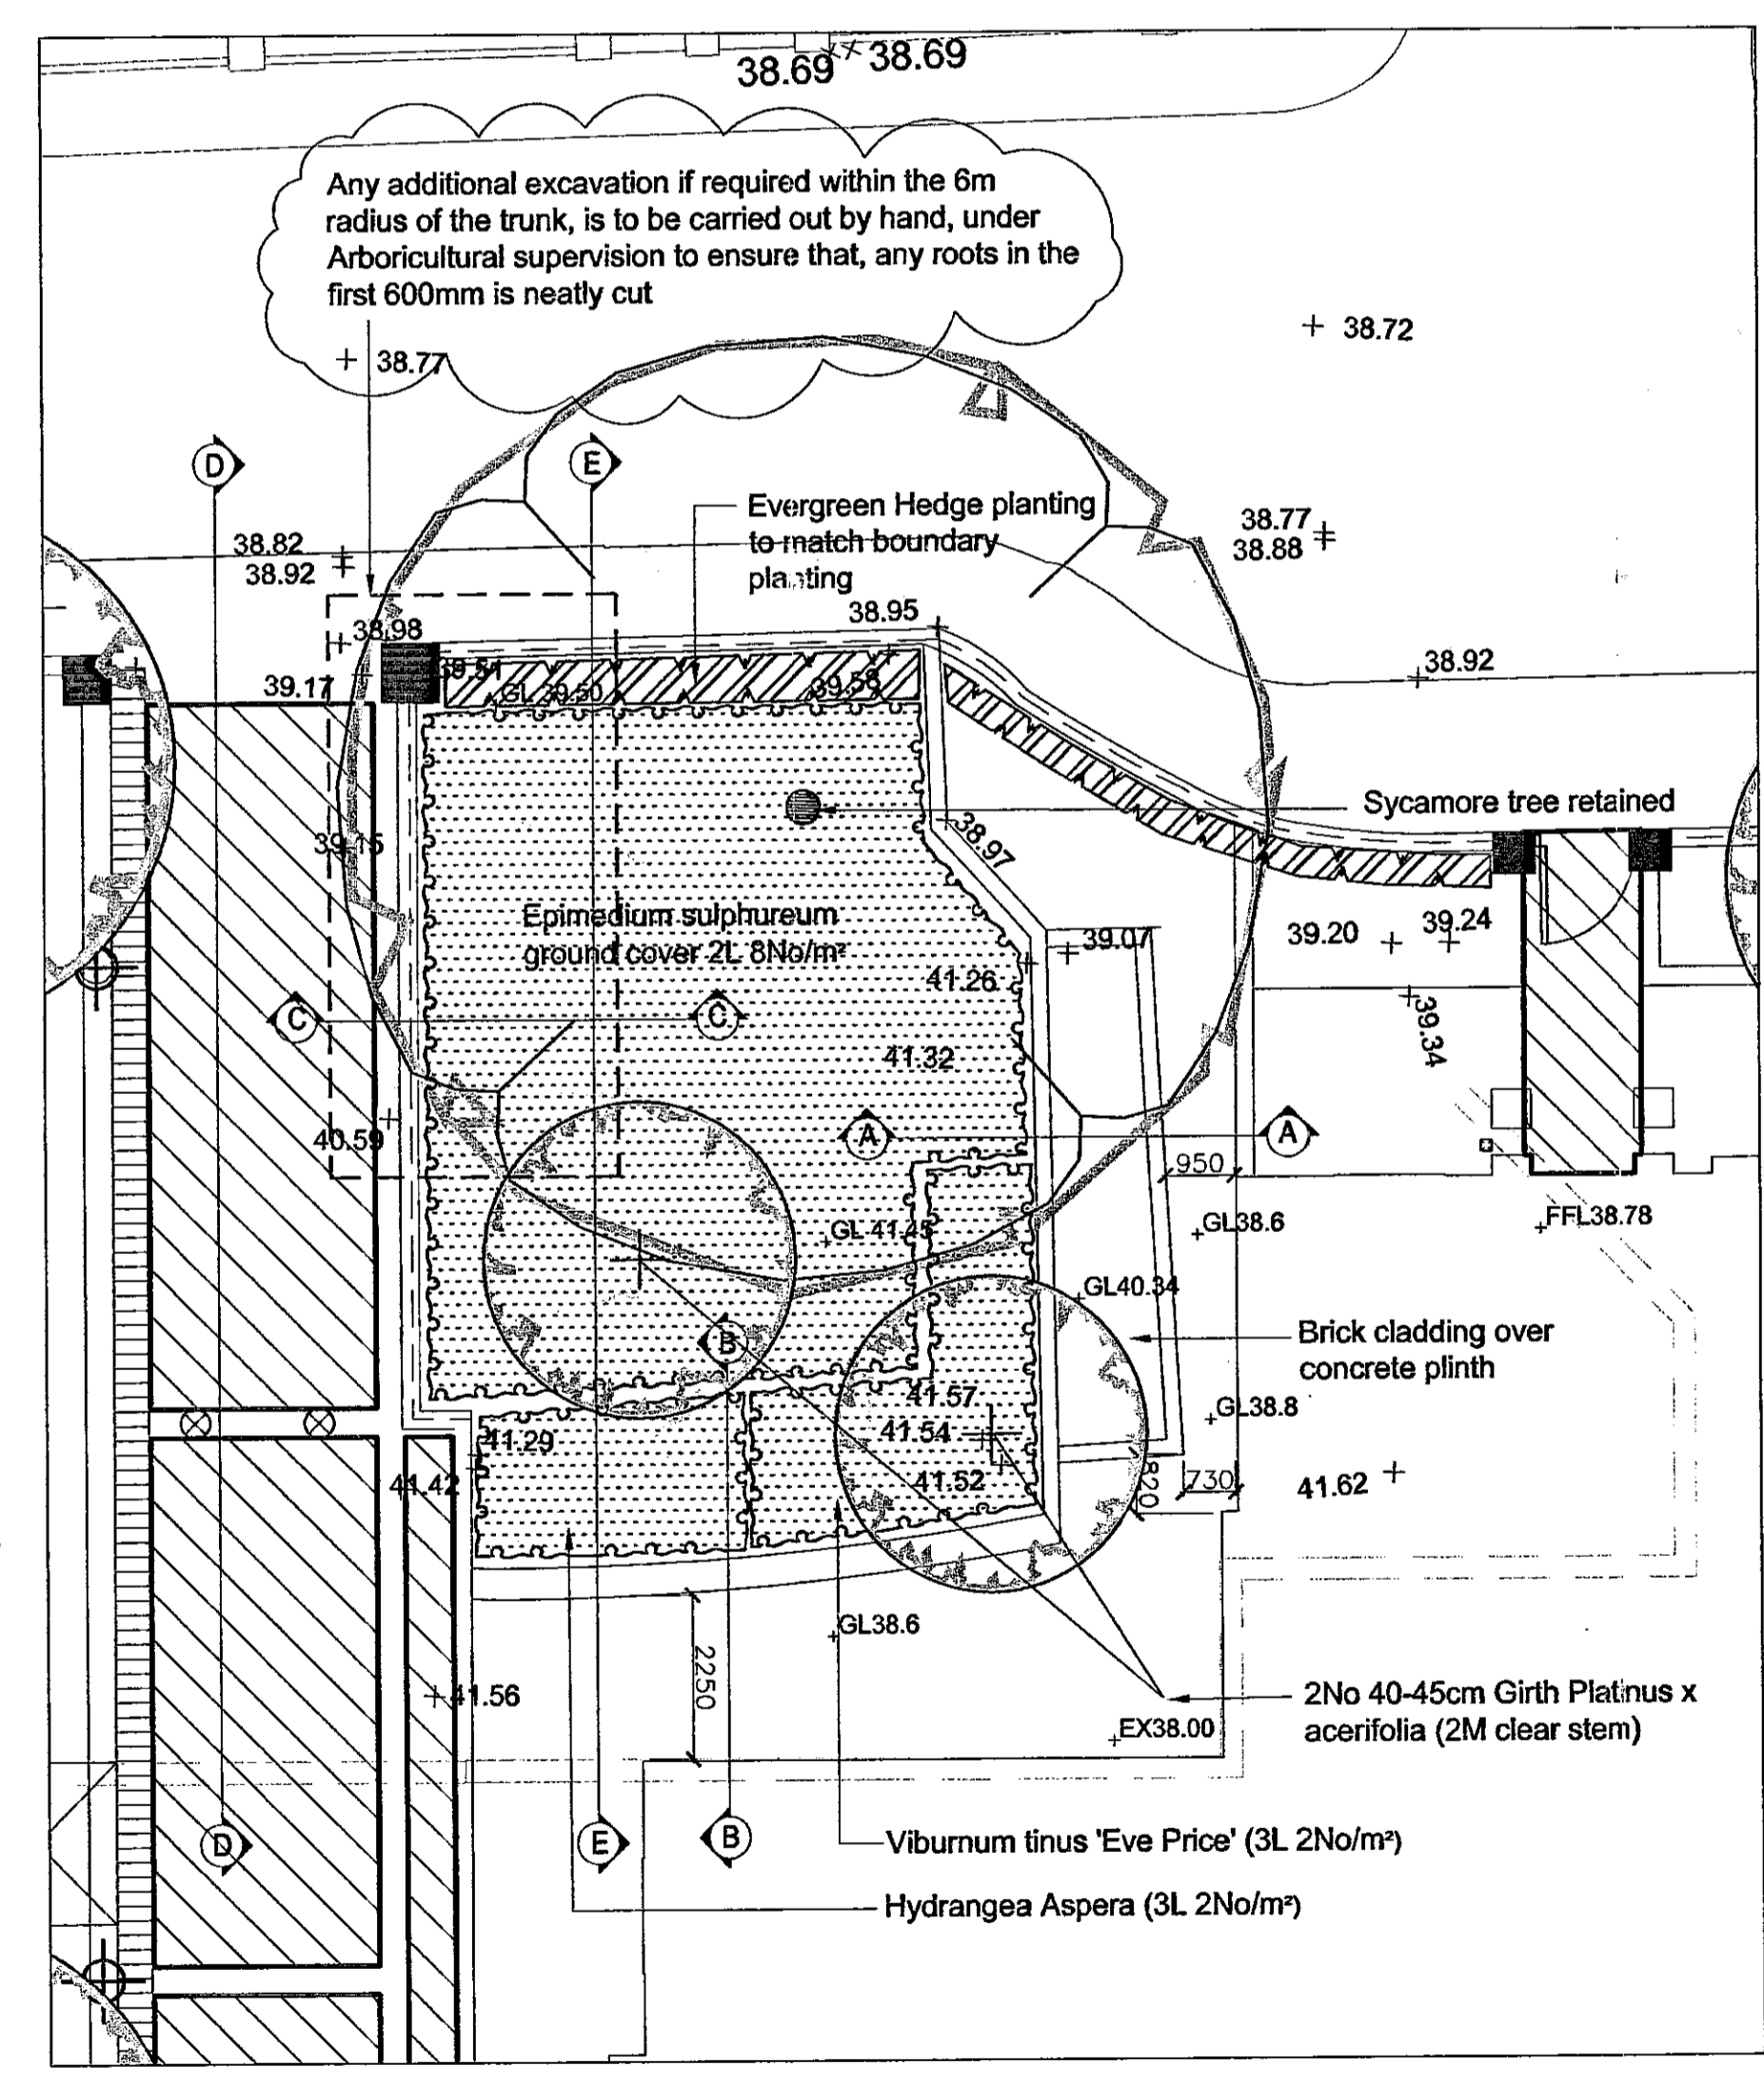

Plan - Proposed Landscape
Scale 1:100

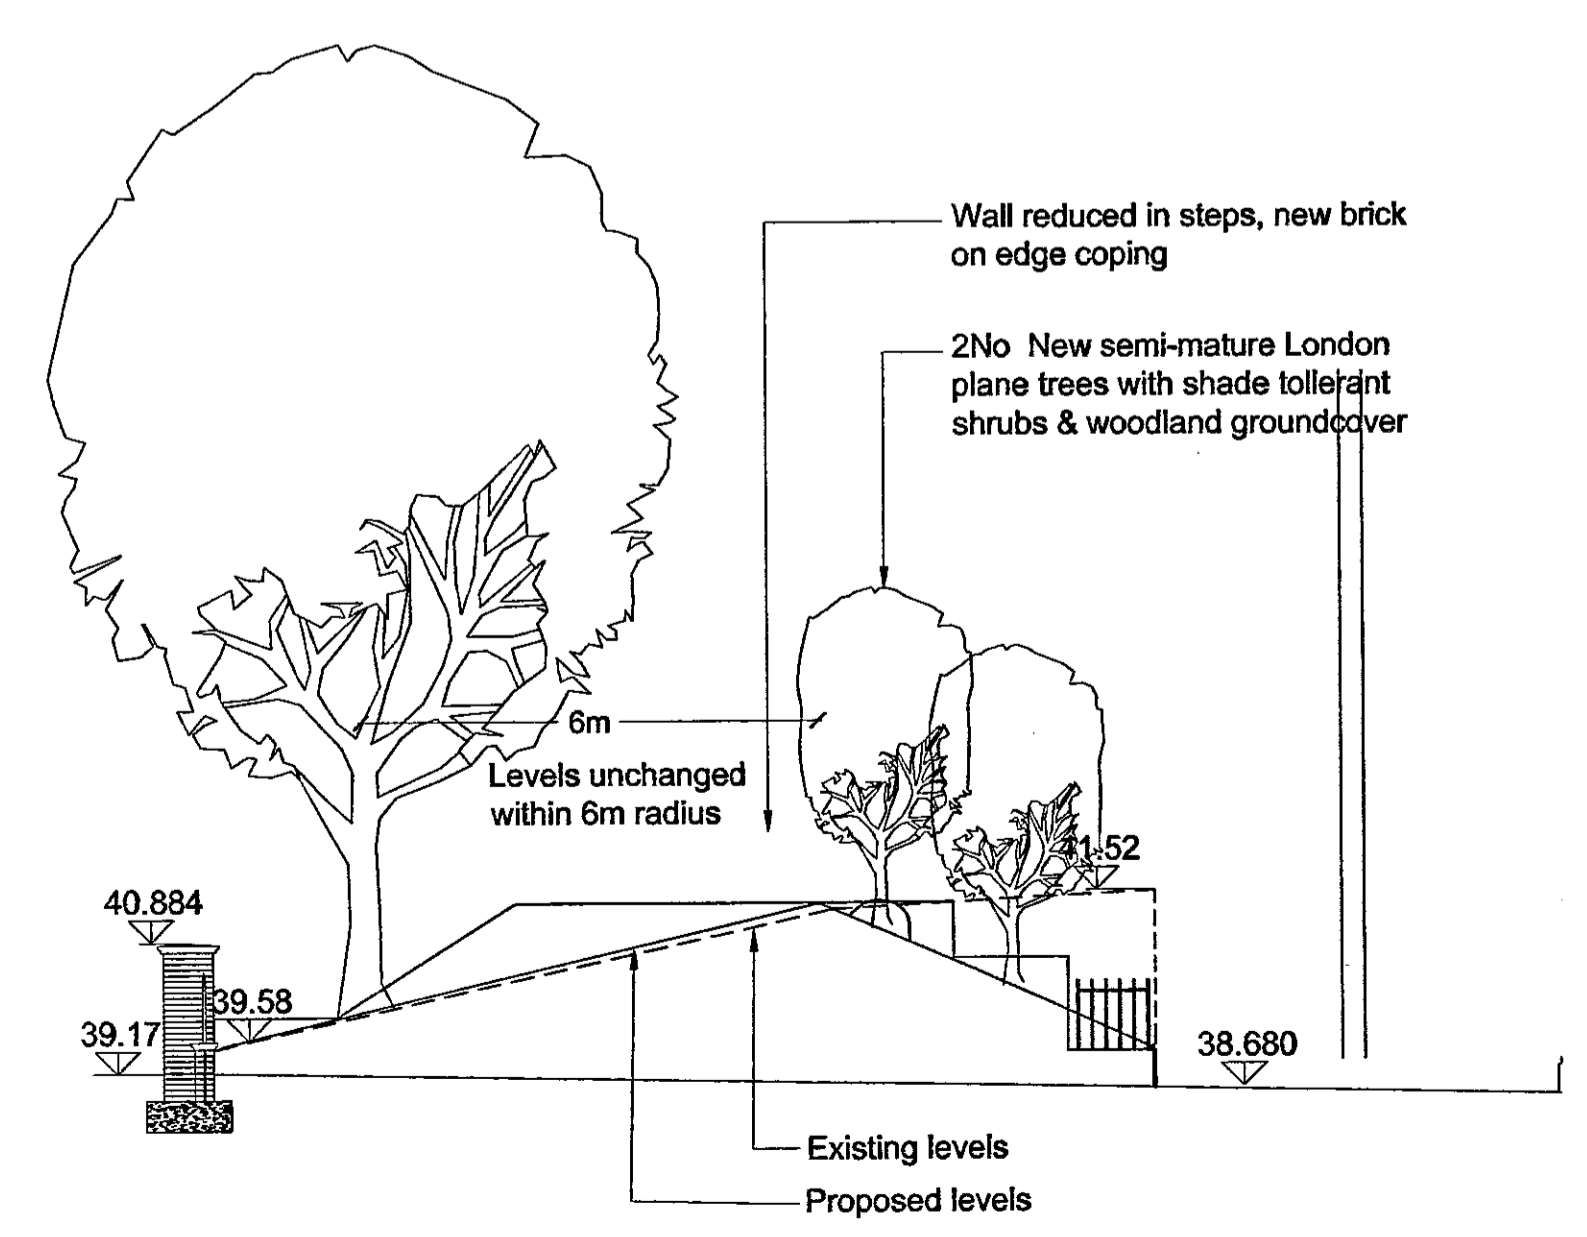

Elevation E-E' - Proposed showing rear wall
Scale 1:100

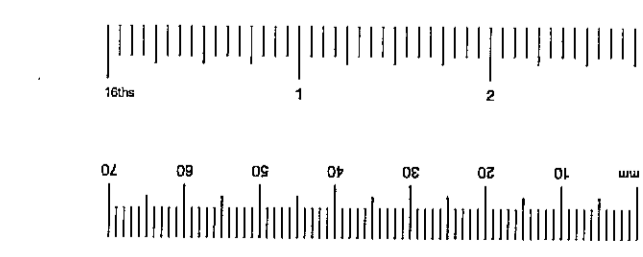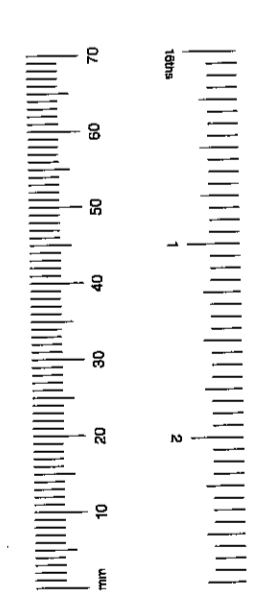

BroadwayMalyan
Landscape
Unit 3 Weybridge Business Park
Addlestone Road
Weybridge, Surrey KT15 2BW
T: +44(0)1932 845599
F: +44(0)1932 846043
E: bml@broadwaymalyan.com

Client
ST JAMES HOMES
Project
Aubrey Walk Campden Hill Res.
Description
**Landscape Proposals -
Proposed Trees & bank by
Aubrey Walk flats**


Status
Planning

Scale	Drawn	Date
1:100	GK	May 2003
Job number	Drawing number	Revision
10337	203	A

Original size 100mm Copyright Broadway Malyan Limited

Contractors are not to scale dimensions from this drawing

Revision Date

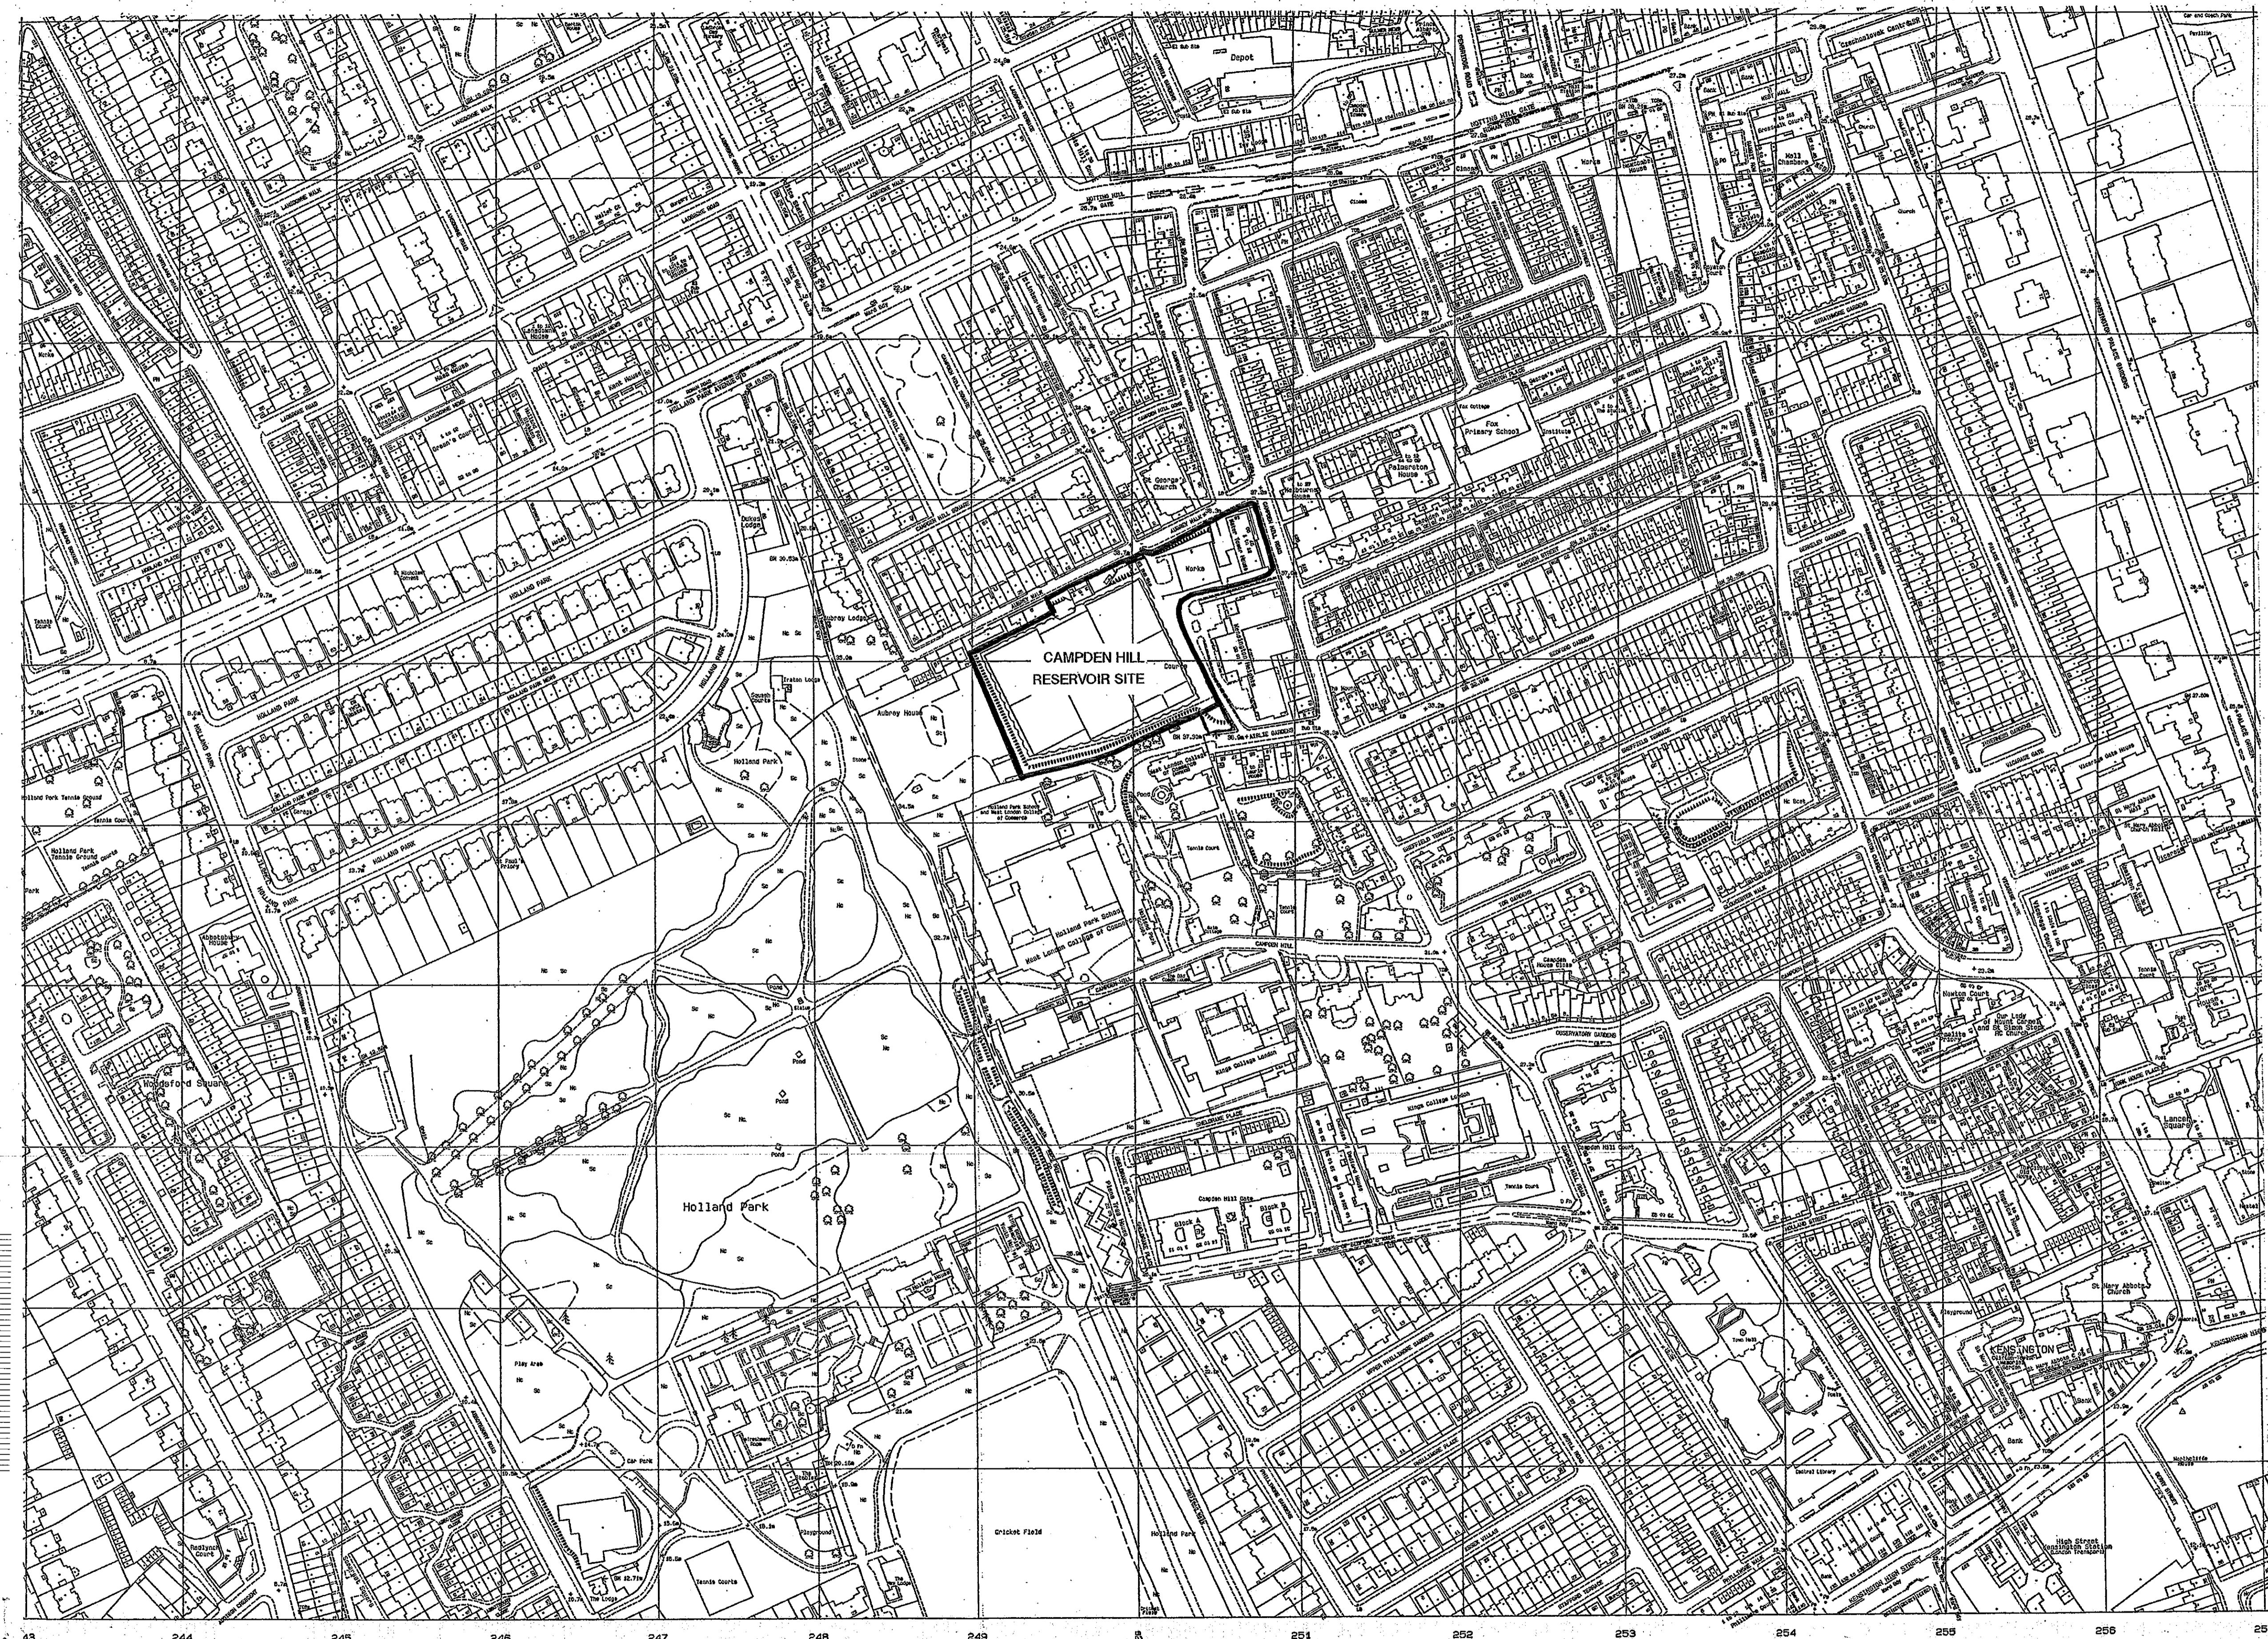

R.B.K. & CO.
TOWN PLANNING
26 OCT 2000
RECEIVED

BroadwayMalyan
Architects & Designers



Woburn Hill, Addlestone
Weybridge, Surrey KT15 2QA
T: +44(0)1932 845599
F: +44(0)1932 856205
E: Wey@broadwaymalyan.com

Client
St. James Homes Ltd
Project
Campden Hill Reservoir
Description
**Ordnance Survey
Site Location Plan**

Status
Planning
Scale 1:2500
Job number 7650
Drawn MJD
Drawing number P099
Date 23/12/99
Revision

Original size 100mm Copyright Broadway Malyan Limited


Produced 18 Feb 1998 from Ordnance Survey digital data and incorporating surveyed revision available at this date. © Crown Copyright 1998. Reproduction in whole or in part is prohibited without the prior permission of Ordnance Survey. Superplan products are sold subject to Ordnance Survey Terms & Conditions of Sale, available on request

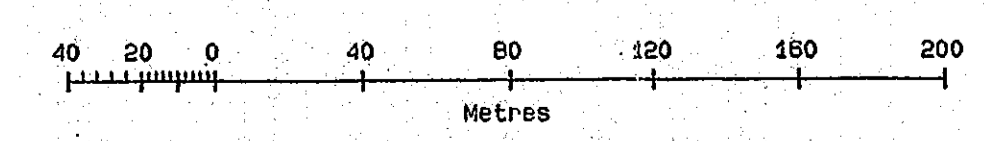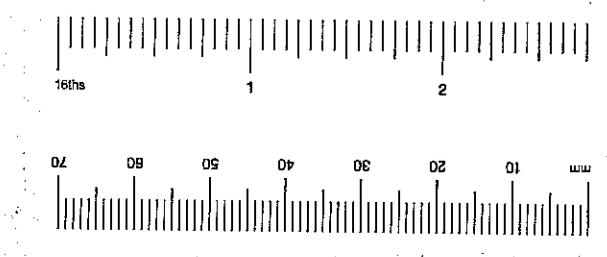

Scale 1:2500

Contractors are not to scale dimensions from this drawing

Revision	Date
A	15.03.99
B	23.12.99
C	27.07.00

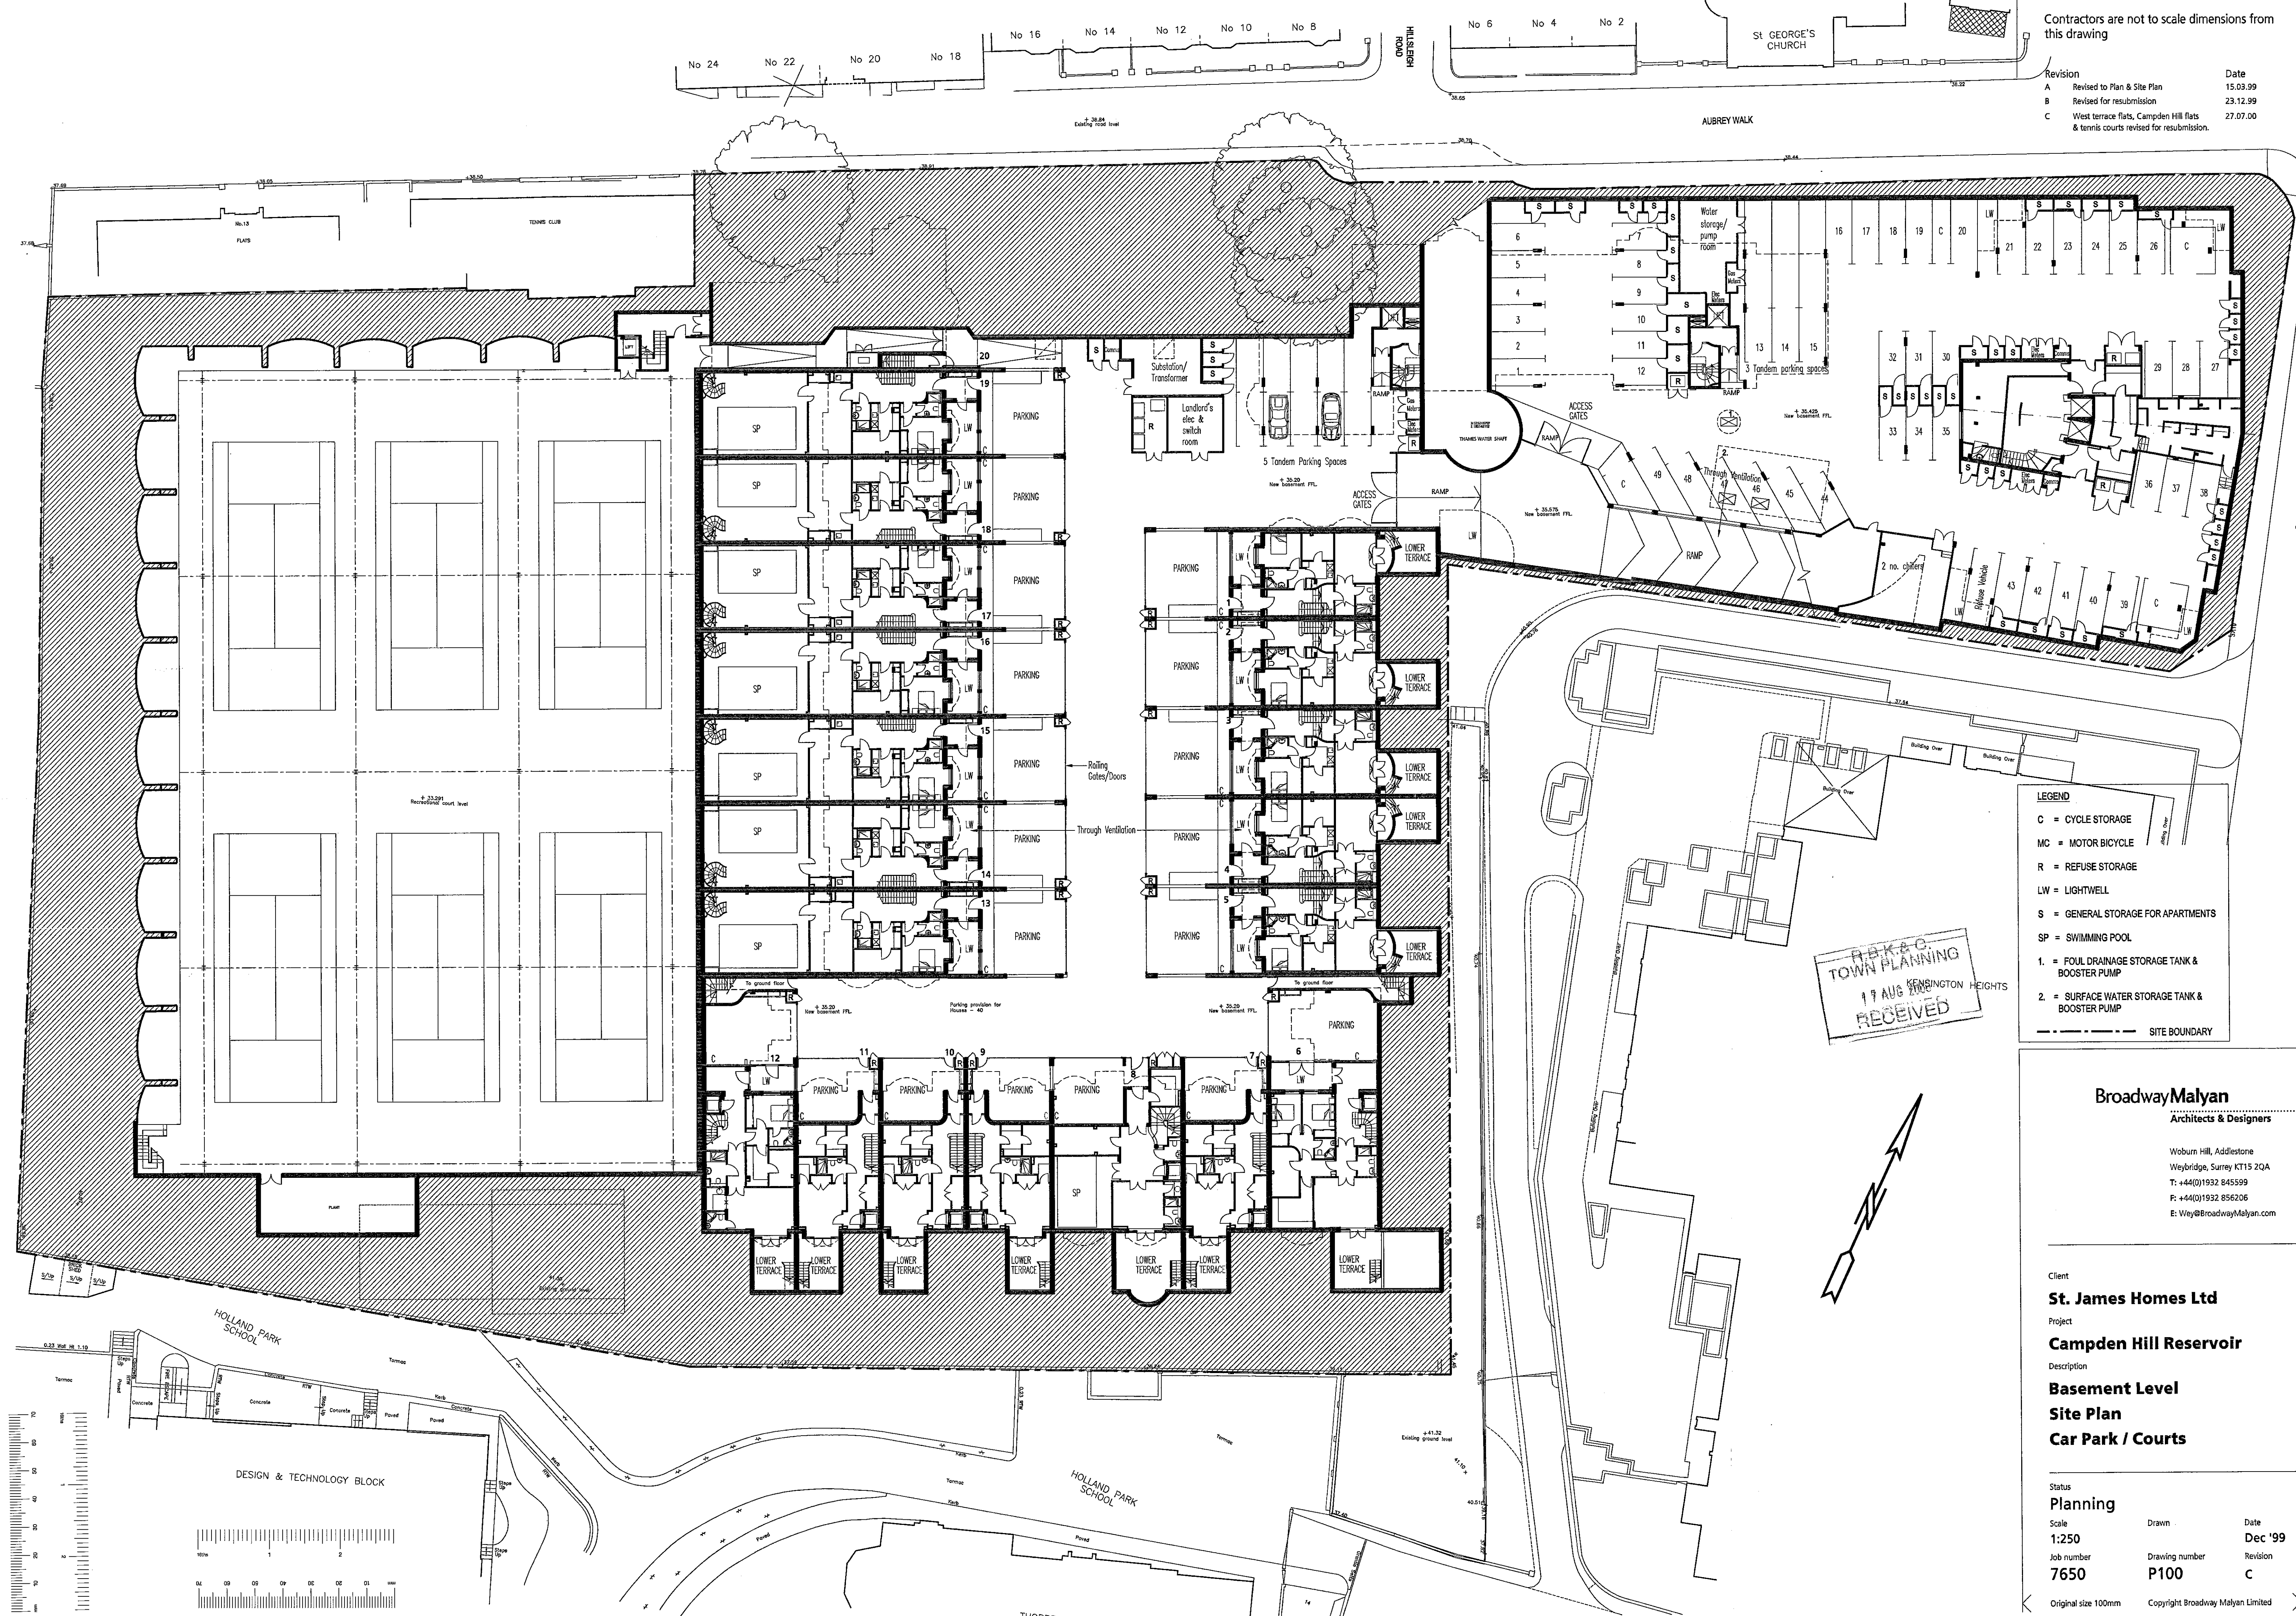

- LEGEND**
- C = CYCLE STORAGE
 - MC = MOTOR BICYCLE
 - R = REFUSE STORAGE
 - LW = LIGHTWELL
 - S = GENERAL STORAGE FOR APARTMENTS
 - SP = SWIMMING POOL
 - 1. = FOUL DRAINAGE STORAGE TANK & BOOSTER PUMP
 - 2. = SURFACE WATER STORAGE TANK & BOOSTER PUMP
- SITE BOUNDARY

BroadwayMalyan
Architects & Designers

Woburn Hill, Addlestone
Weybridge, Surrey KT15 2QA
T: +44(0)1932 845599
F: +44(0)1932 856206
E: Wey@BroadwayMalyan.com

Client
St. James Homes Ltd

Project
Campden Hill Reservoir

Description
**Basement Level
Site Plan
Car Park / Courts**


Status
Planning

Scale	Drawn	Date
1:250		Dec '99
Job number	Drawing number	Revision
7650	P100	C

Original size 100mm Copyright Broadway Malyan Limited

Contractors are not to scale dimensions from this drawing

Revision	Date
A	15.03.99
B	23.12.99
C	27.07.00
D	15.08.00

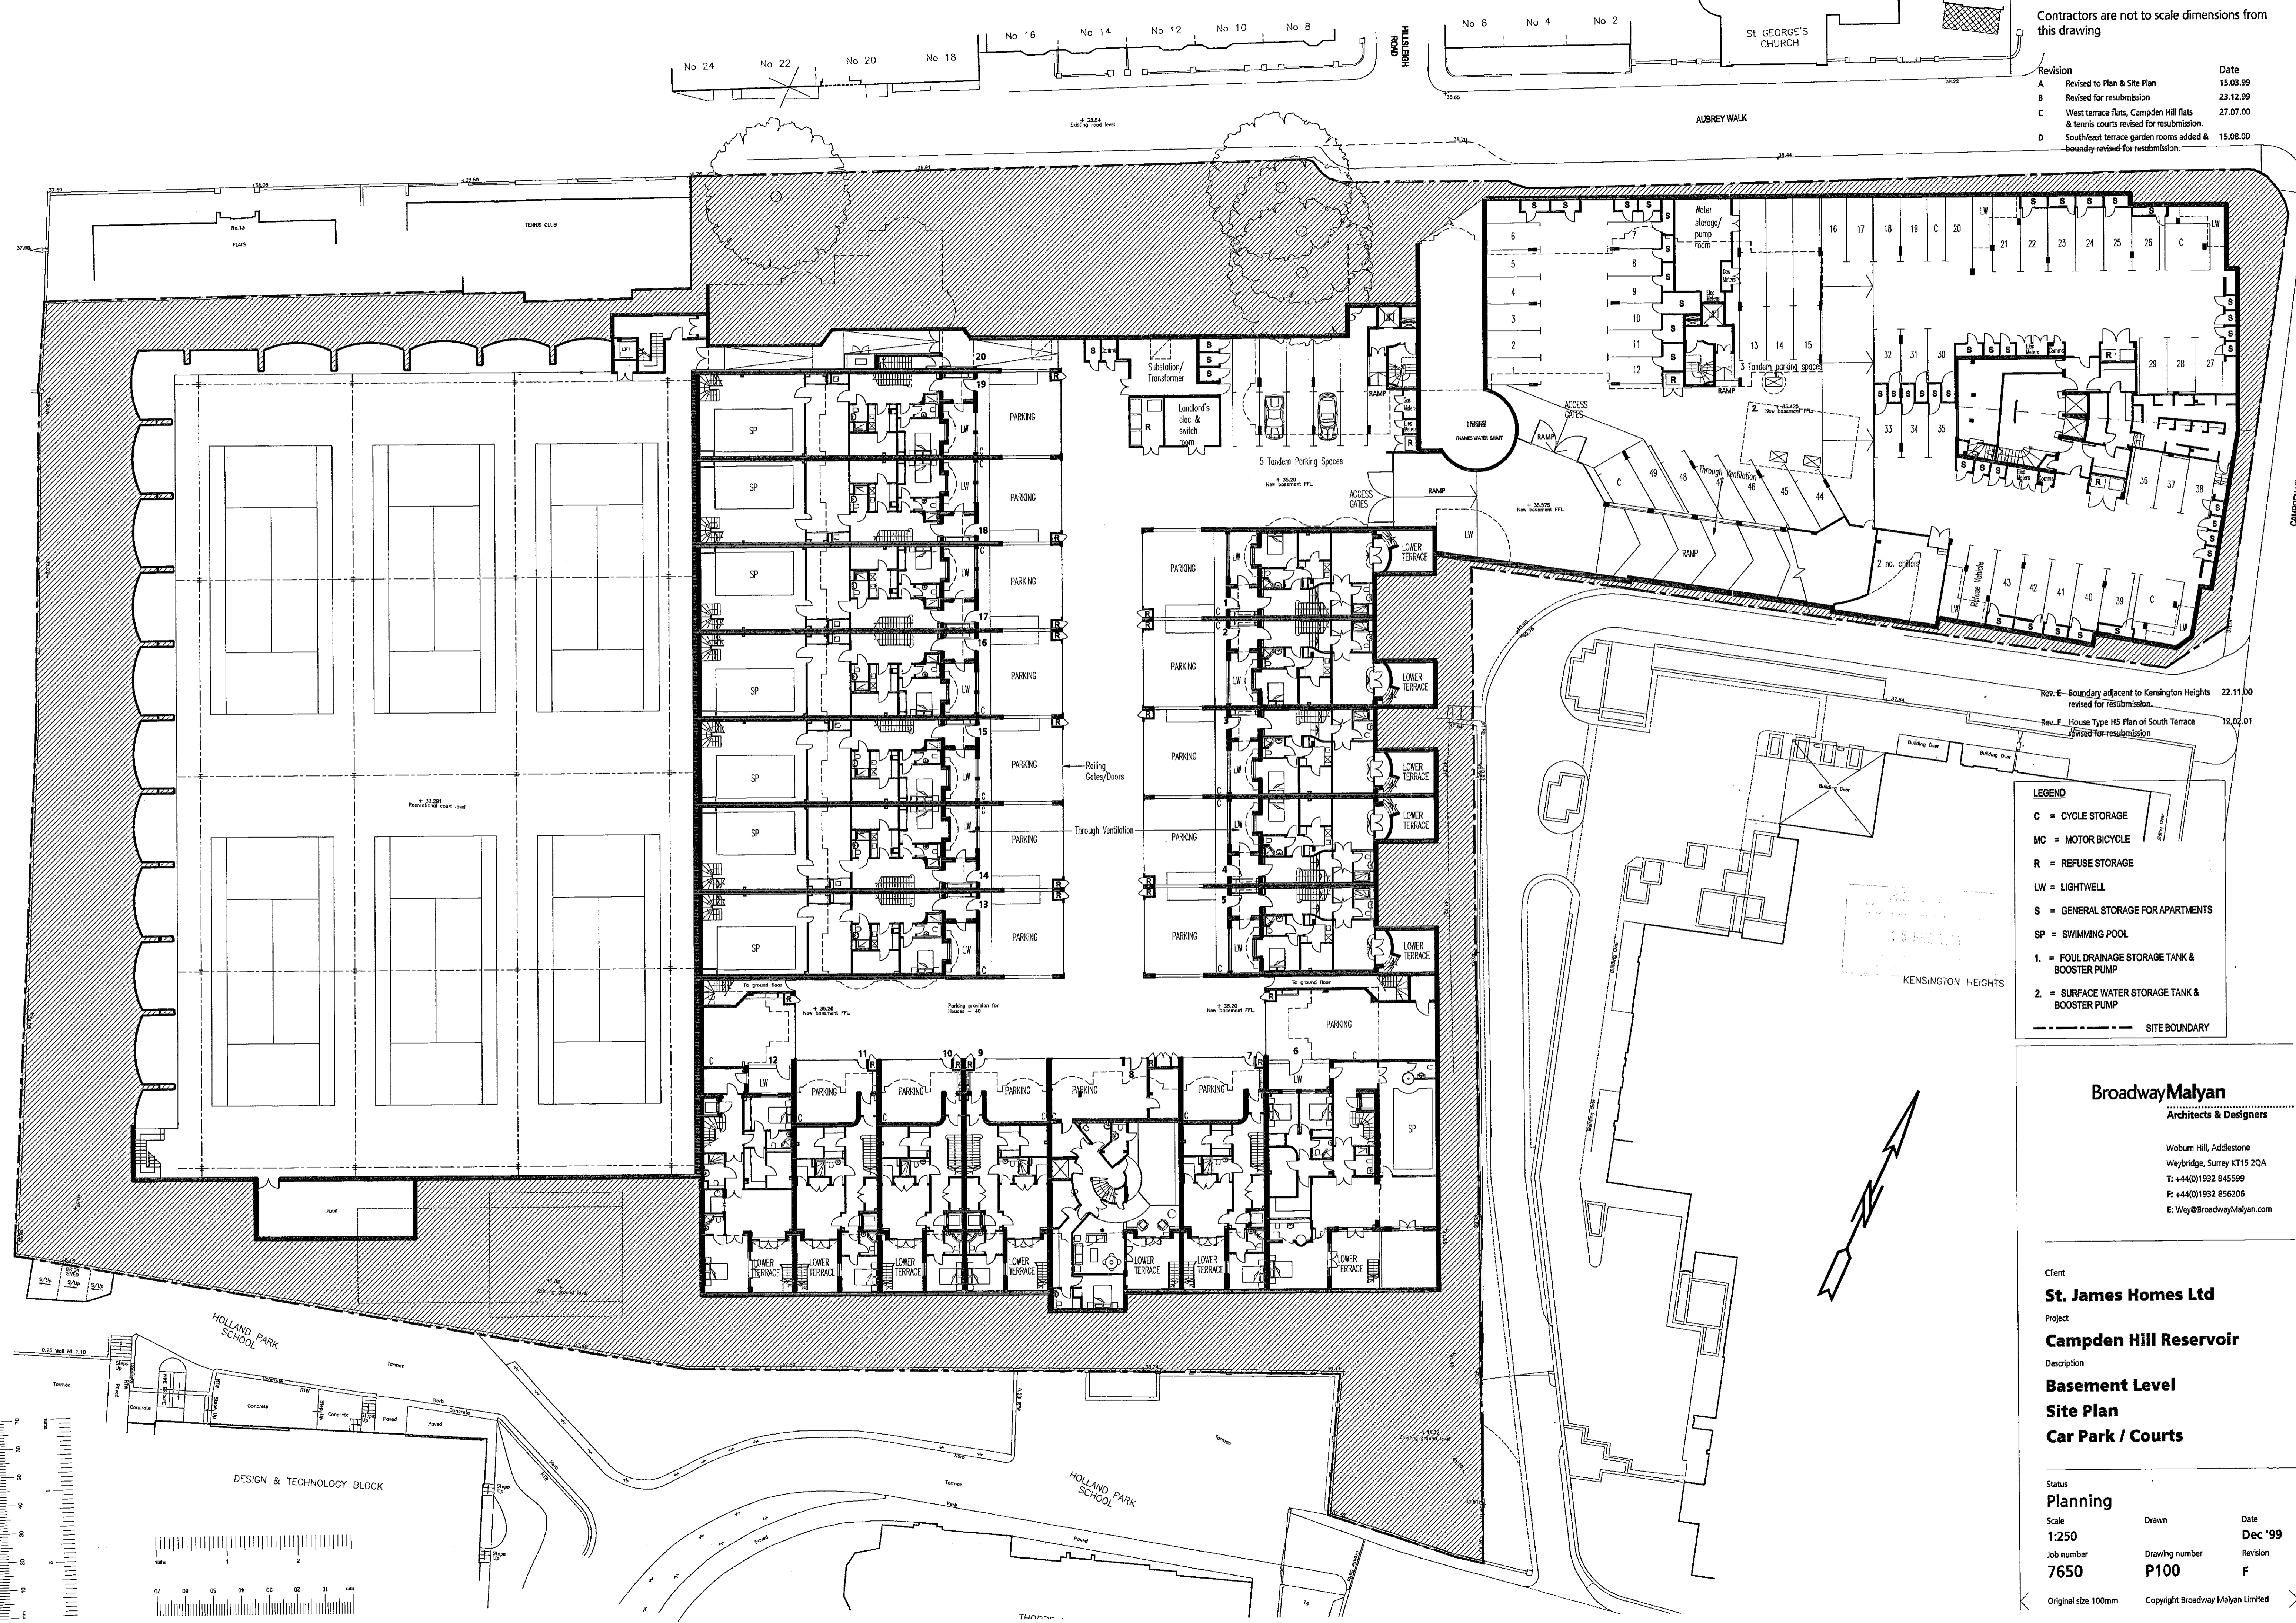

LEGEND

- C = CYCLE STORAGE
- MC = MOTOR BICYCLE
- R = REFUSE STORAGE
- LW = LIGHTWELL
- S = GENERAL STORAGE FOR APARTMENTS
- SP = SWIMMING POOL
- 1. = FOUL DRAINAGE STORAGE TANK & BOOSTER PUMP
- 2. = SURFACE WATER STORAGE TANK & BOOSTER PUMP
- SITE BOUNDARY

BroadwayMalyan
Architects & Designers

Woburn Hill, Addlestone
Weybridge, Surrey KT15 2QA
T: +44(0)1932 845599
F: +44(0)1932 856206
E: Wey@BroadwayMalyan.com

Client
St. James Homes Ltd

Project
Campden Hill Reservoir

Description
**Basement Level
Site Plan
Car Park / Courts**



Status
Planning

Scale	Drawn	Date
1:250		Dec '99
Job number	Drawing number	Revision
7650	P100	F

Original size 100mm Copyright Broadway Malyan Limited

Contractors are not to scale dimensions from this drawing

Revision	Date
A Revised Plan & Site Plan	15.03.99
B Revised for resubmission	23.12.99
C Tennis court glazing added, Campden Hill flats plan & landscape adjacent to Aubrey Walk flats revised for resubmission.	26.07.00

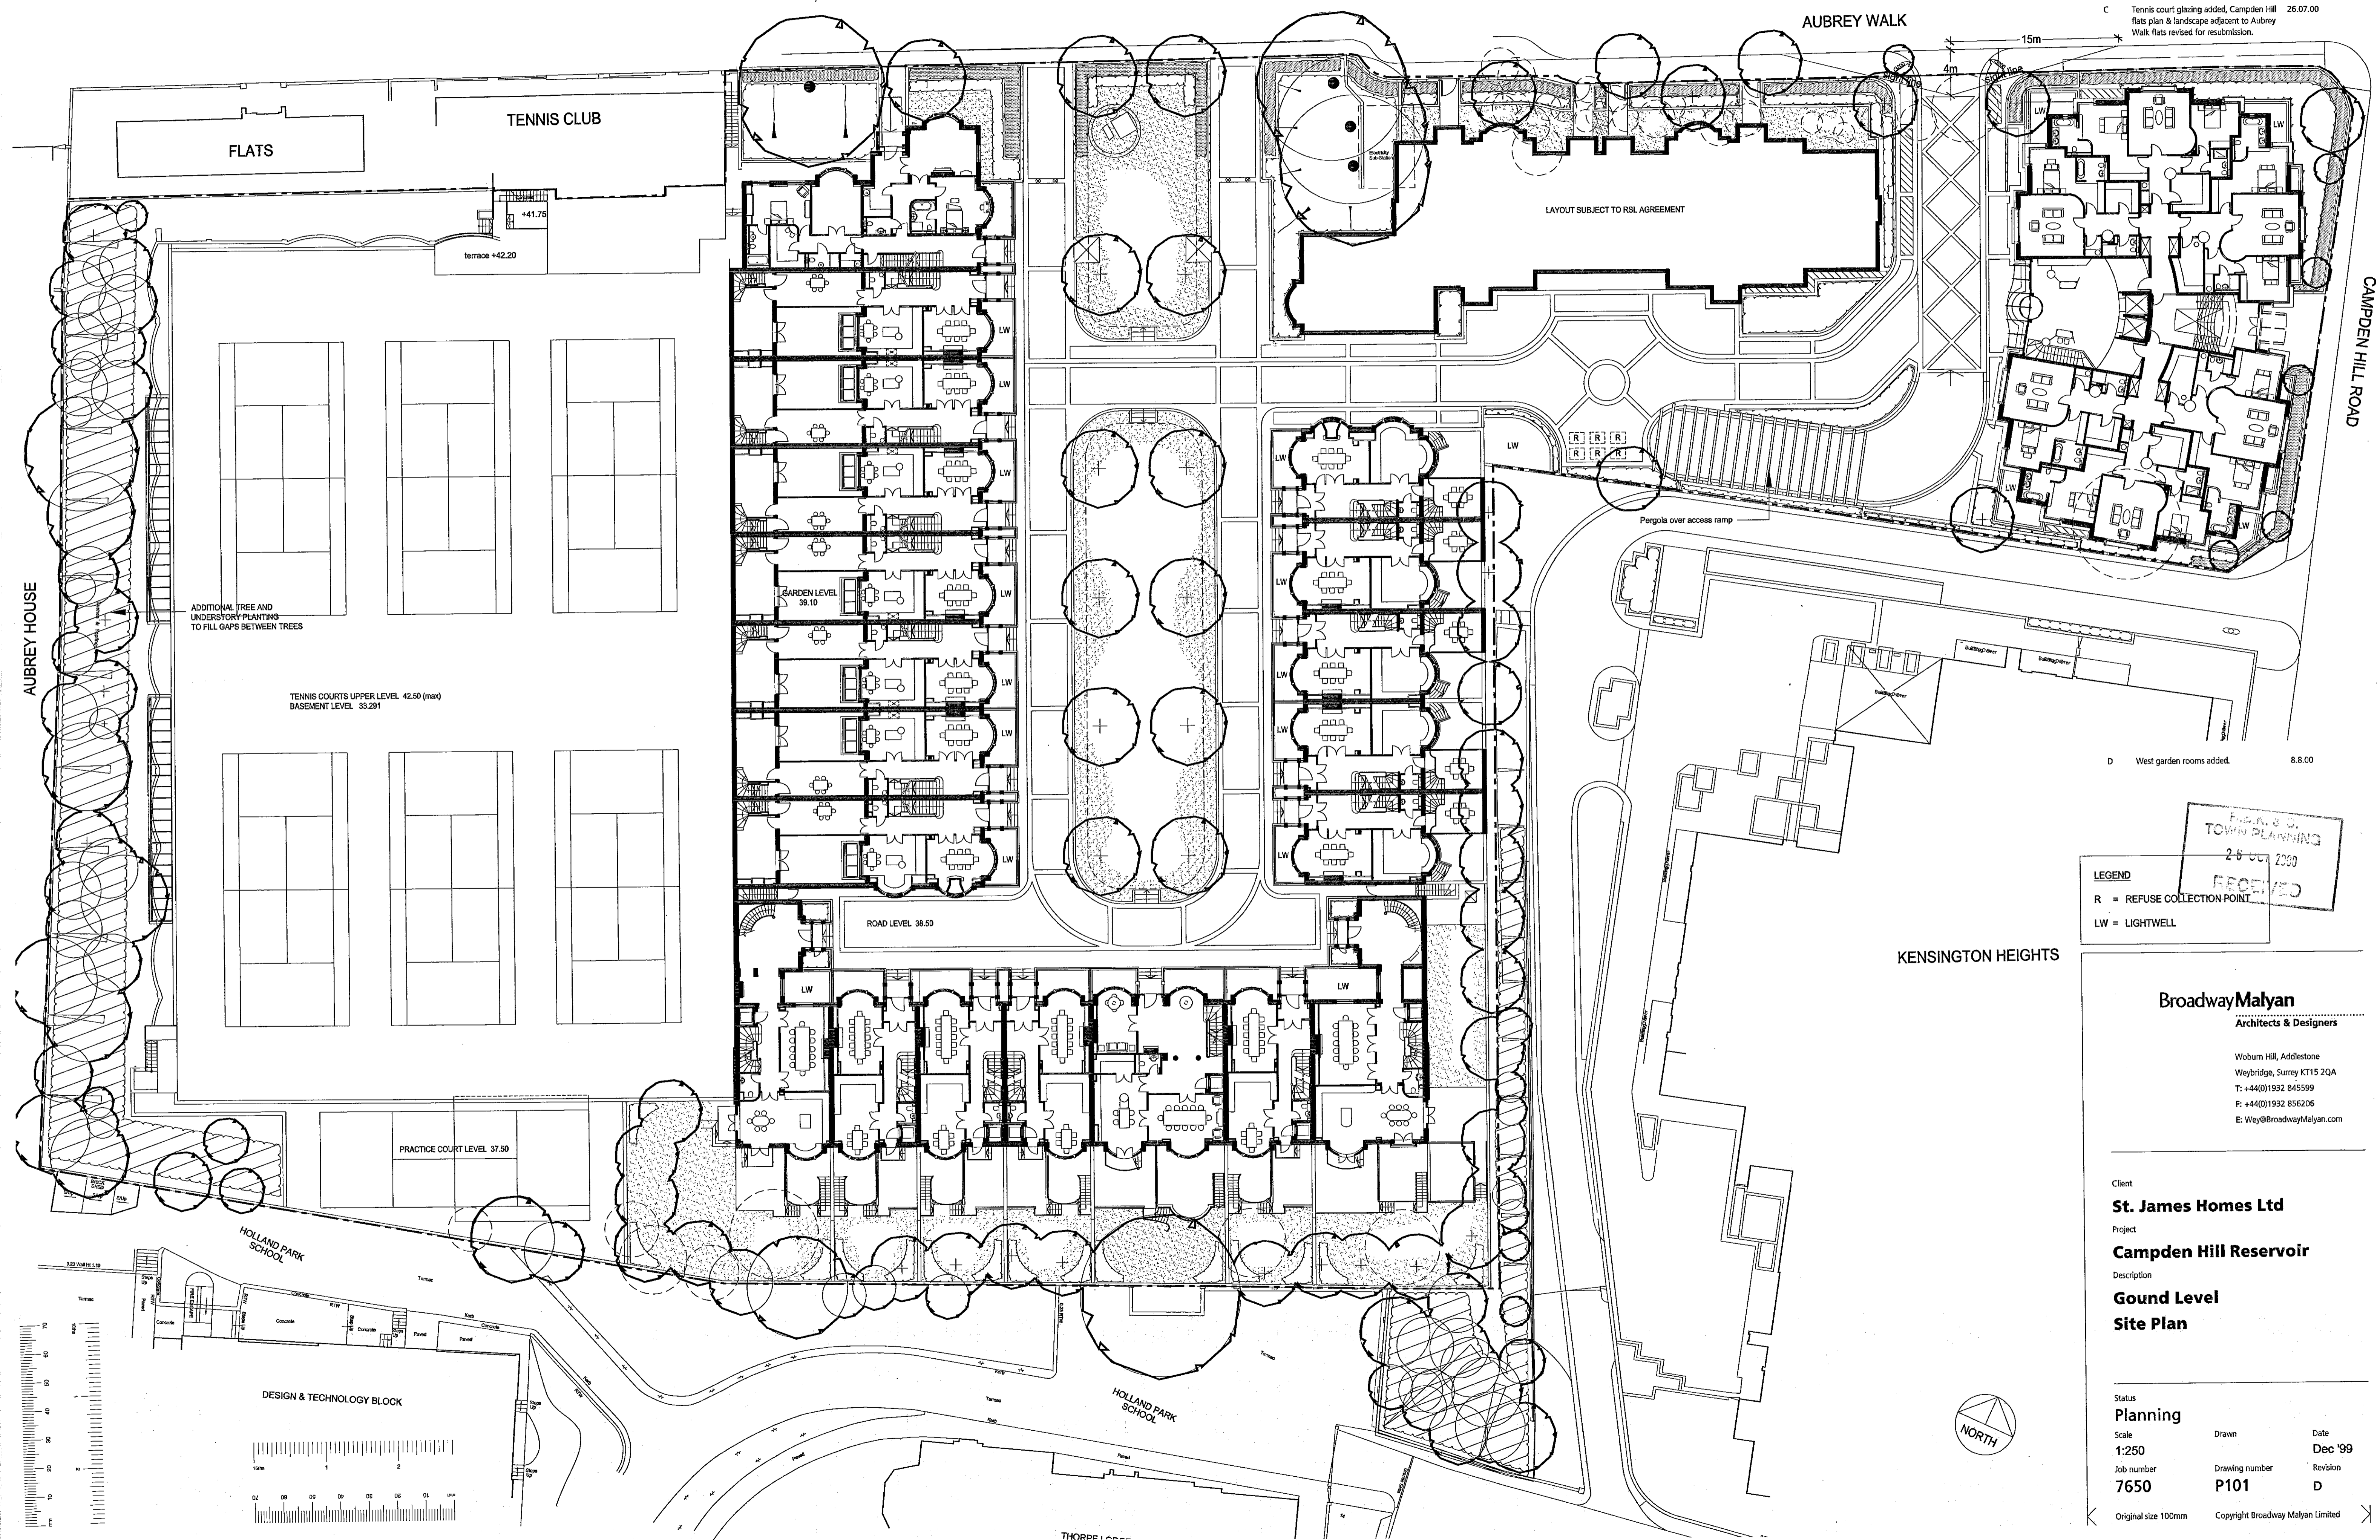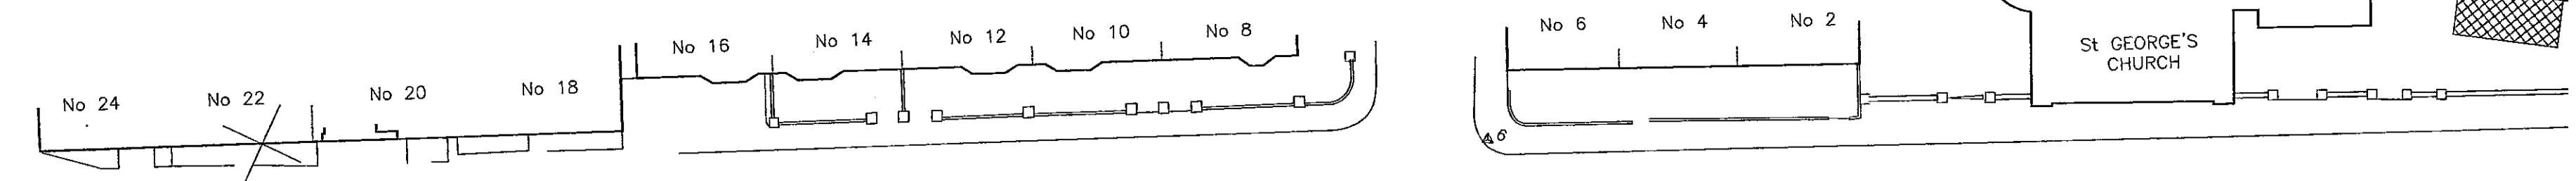

D West garden rooms added. 8.8.00

LEGEND
 R = REFUSE COLLECTION POINT
 LW = LIGHTWELL

RECEIVED
 28 OCT 2000
 TOWN PLANNING

BroadwayMalyan
 Architects & Designers

Woburn Hill, Addlestone
 Weybridge, Surrey KT15 2QA
 T: +44(0)1932 845599
 F: +44(0)1932 856206
 E: Wey@BroadwayMalyan.com

Client
St. James Homes Ltd

Project
Campden Hill Reservoir

Description
Ground Level Site Plan

Status
Planning



Scale
1:250

Job number
7650

Drawn
 Date
Dec '99

Drawing number
 Revision
P101 D

Original size 100mm Copyright Broadway Malyan Limited

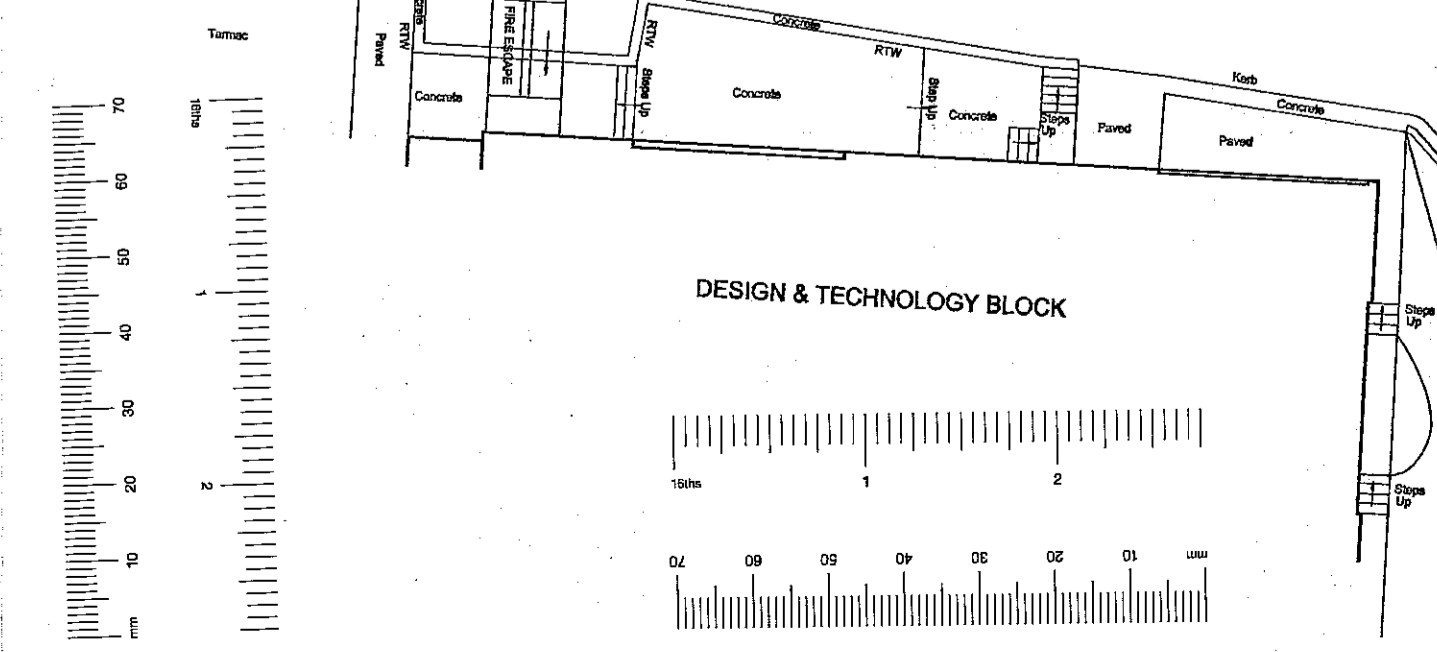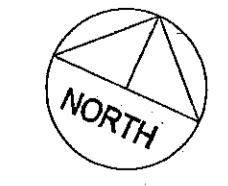


Contractors are not to scale dimensions from this drawing



Revision	Date
B	Revised for resubmission. 01.00
C	West terrace flats roof, Campden Hill flats elevations & Aubrey Walk flats elevation revised for resubmission. 18.07.00



AUBREY WALK ELEVATION

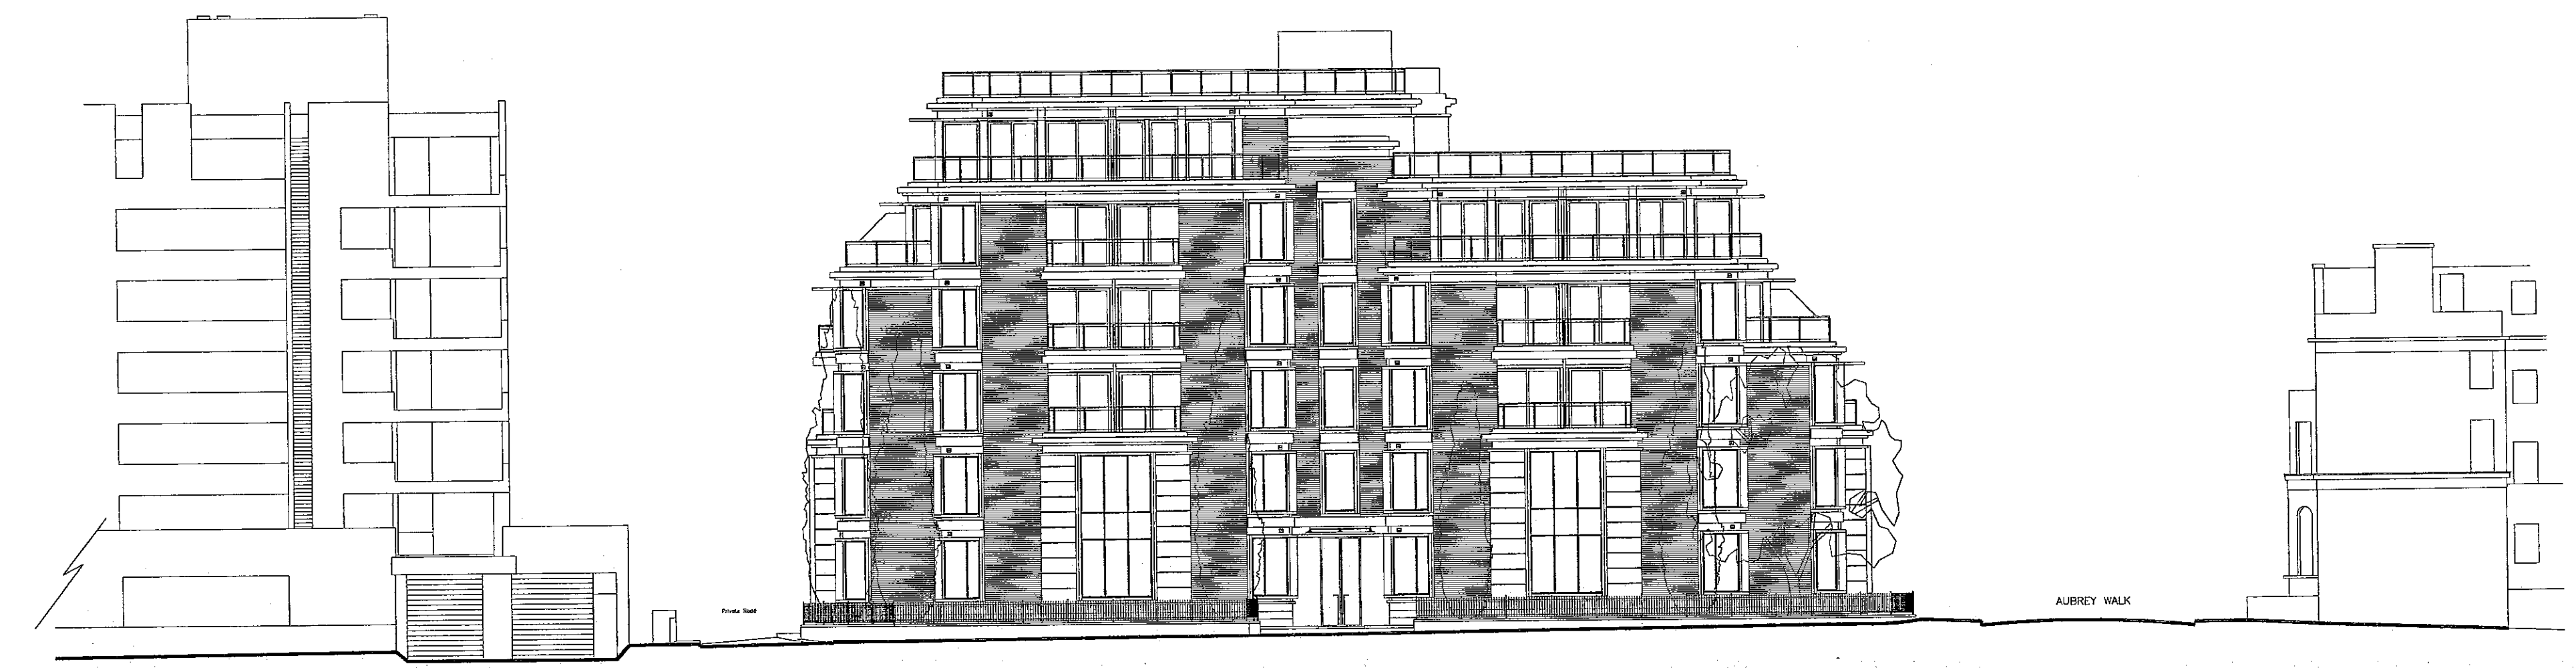

CAMPDEN HILL ROAD ELEVATION

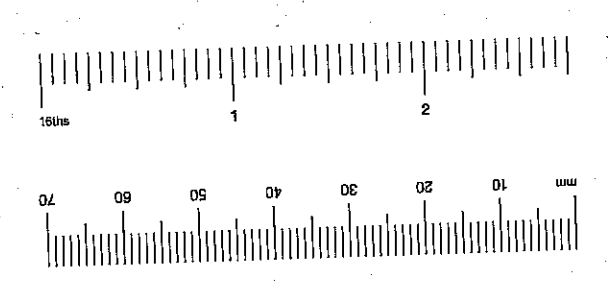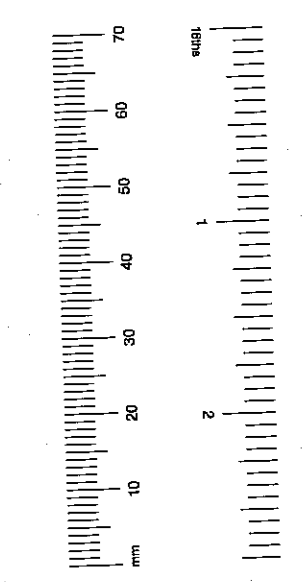

R.B.K. & C.
TOWN PLANNING
26 JULY 2000
RECEIVED

Broadway Malyan
Architects & Designers

Woburn Hill, Addlestone
Weybridge, Surrey KT15 2QA
T: +44(0)1932 845599
F: +44(0)1932 856206
E: Wey@BroadwayMalyan.com

Client
St. James Homes Ltd
Project
Campden Hill Reservoir
Description
Campden Hill & Aubrey Walk Elevations

Status
Planning
Scale
1:200
Job number
7650
Original size 100mm

Drawn
Date
Dec '99
Revision
C

Drawing number
P102
Copyright Broadway Malyan Limited

Contractors are not to scale dimensions from this drawing

Revision	Date
A	Revised Plan & Site Plan 15.03.99
B	Revised for resubmission 23.12.99
C	Tennis court glazing added, Campden Hill flats plan & landscape adjacent to Aubrey Walk flats revised for resubmission. 26.07.00

D	West terrace garden rooms added.	8.8.00
E	Boundary adjacent to Kensington Heights revised for resubmission	22.11.00
F	South Terrace revisions Front elevation to house types H3 & H5 revised. House type H5 plan & elevations revised. Orangerie Room added to House type H3.	8.02.01


LEGEND
 R = REFUSE COLLECTION POINT
 LW = LIGHTWELL

BroadwayMalyan
 Architects & Designers
 Woburn Hill, Addlestone
 Weybridge, Surrey KT15 2QA
 T: +44(0)1932 845399
 F: +44(0)1932 856206
 E: Wey@BroadwayMalyan.com

Client
St. James Homes Ltd
 Project
Campden Hill Reservoir
 Description
Ground Level Site Plan


Status
Planning
 Scale
1:250
 Job number
7650
 Original size 100mm

Drawn
 Date
Dec '99
 Drawing number
P101
 Revision
F
 Copyright Broadway Malyan Limited

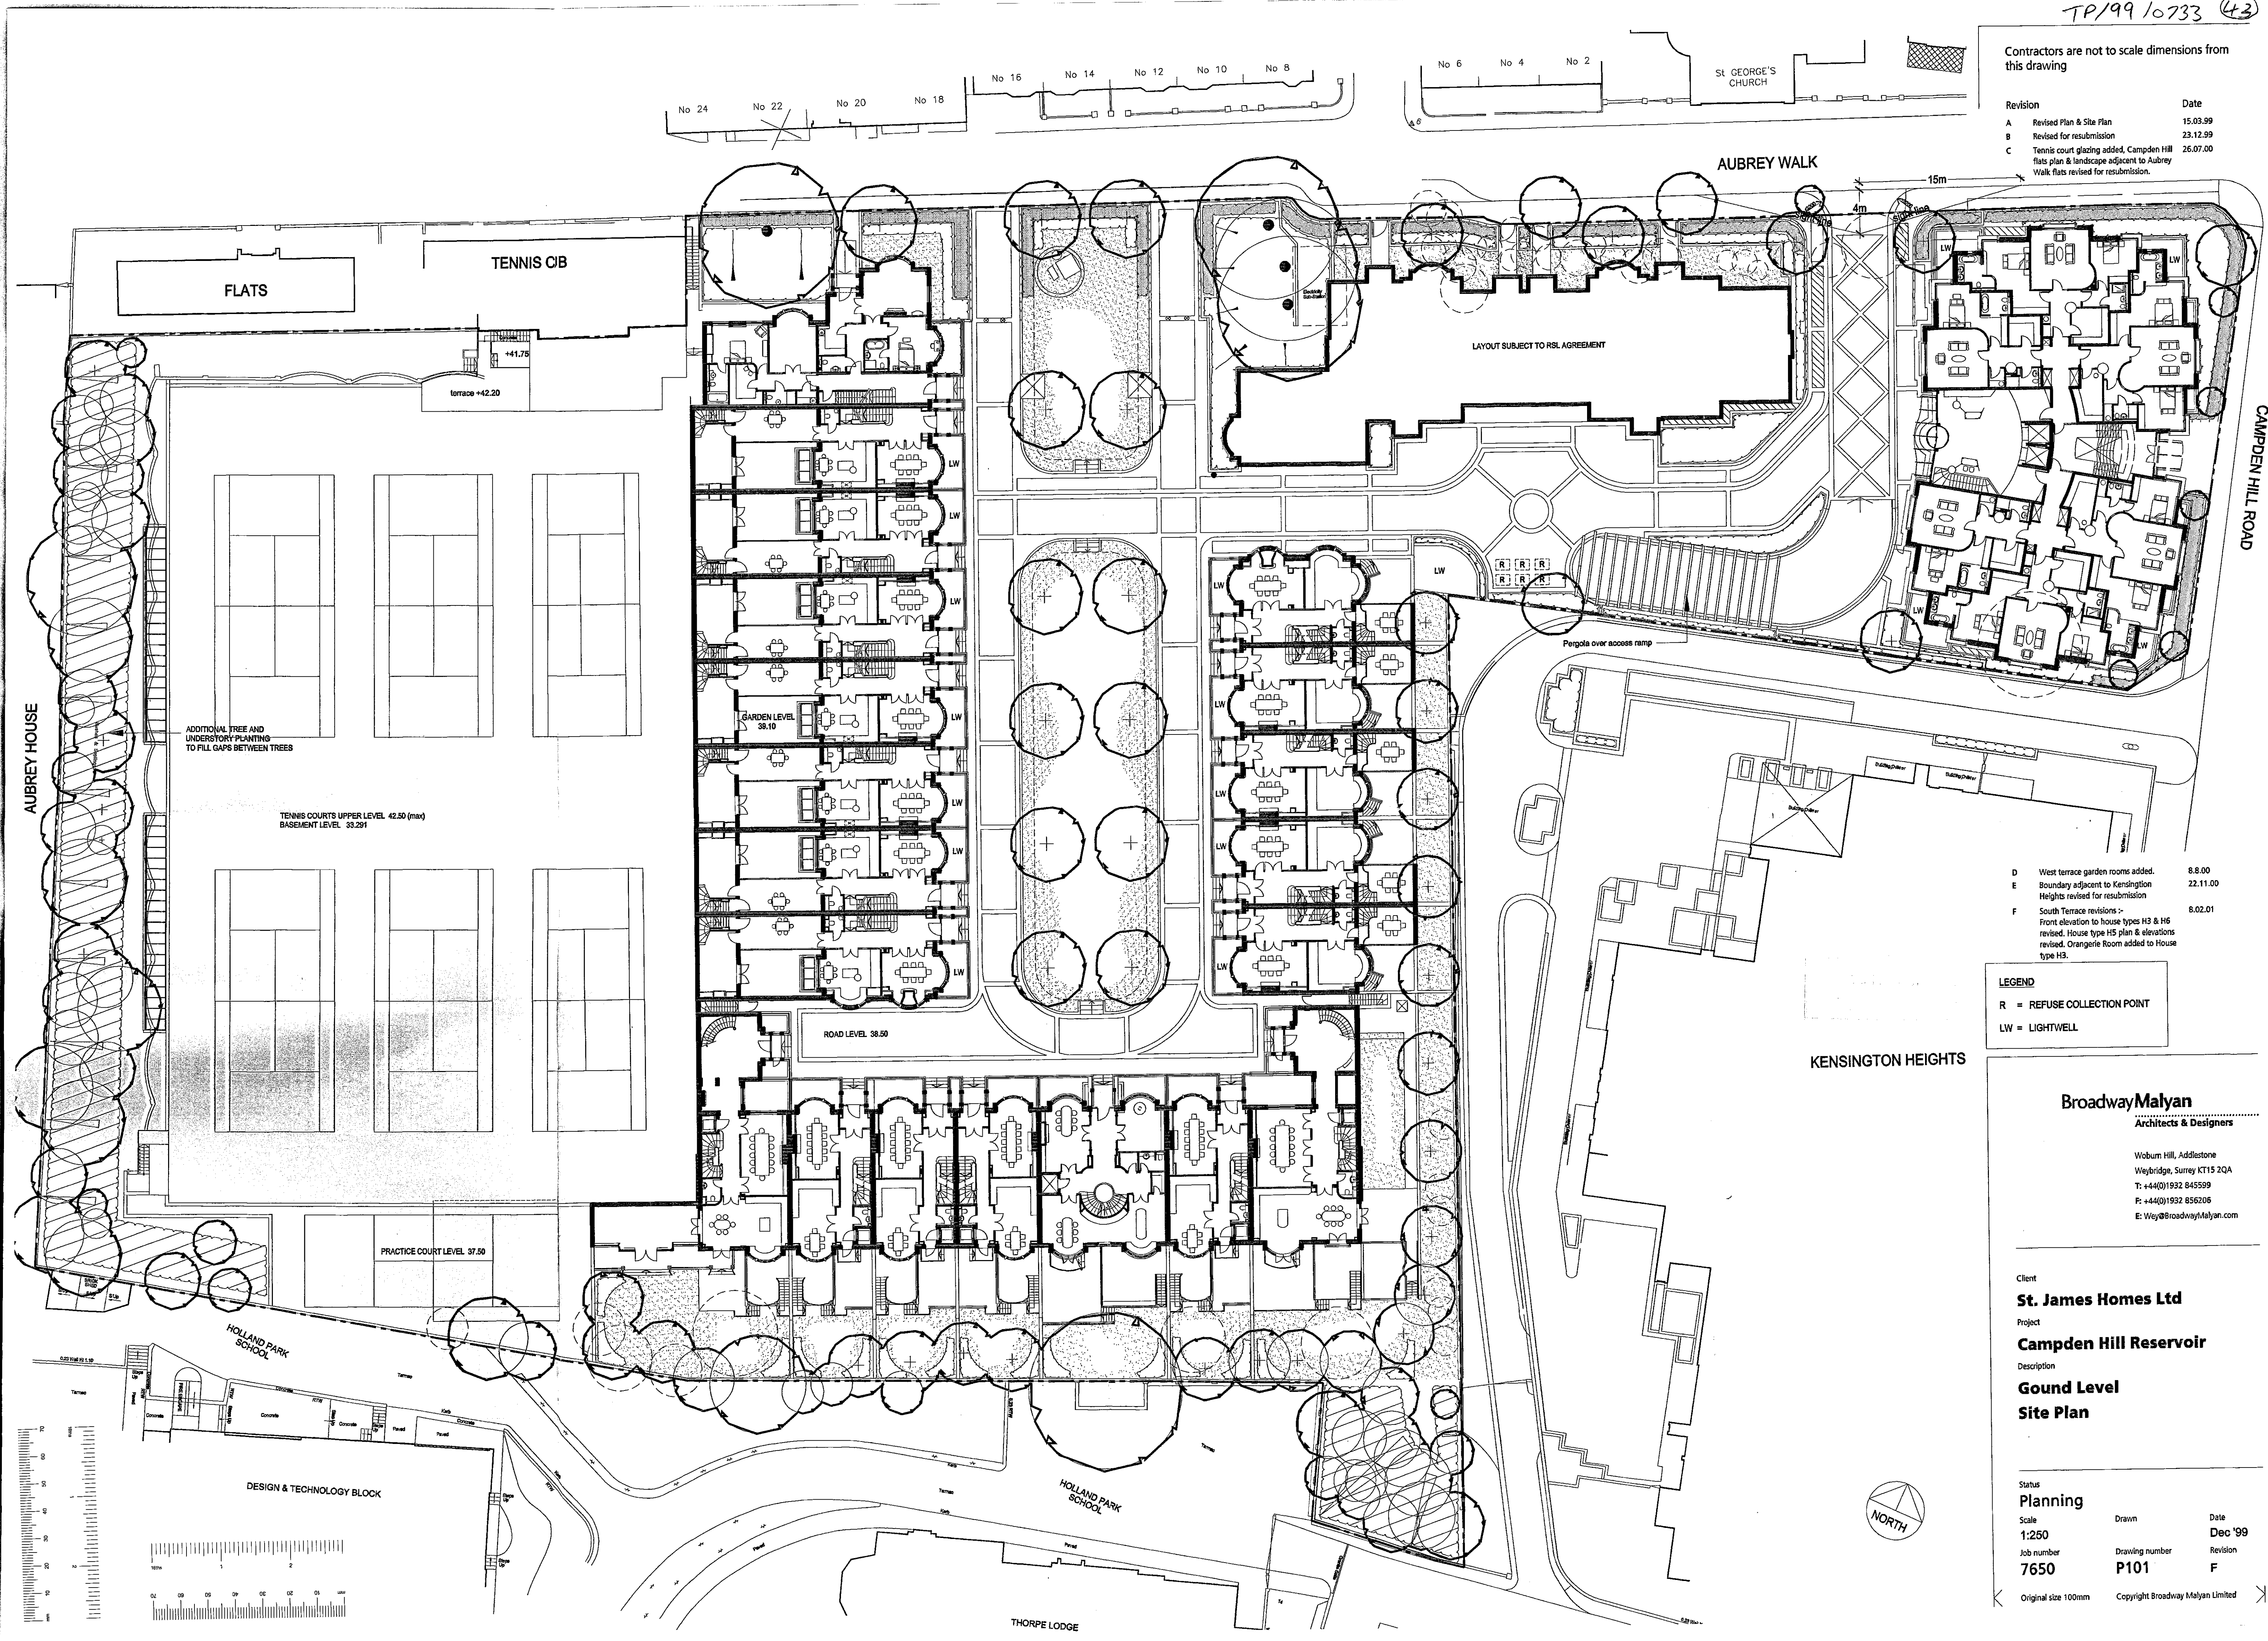

Contractors are not to scale dimensions from this drawing

Revision	Date
A Elevations and key plan updated.	16.03.99
B Revised for resubmission	01.00

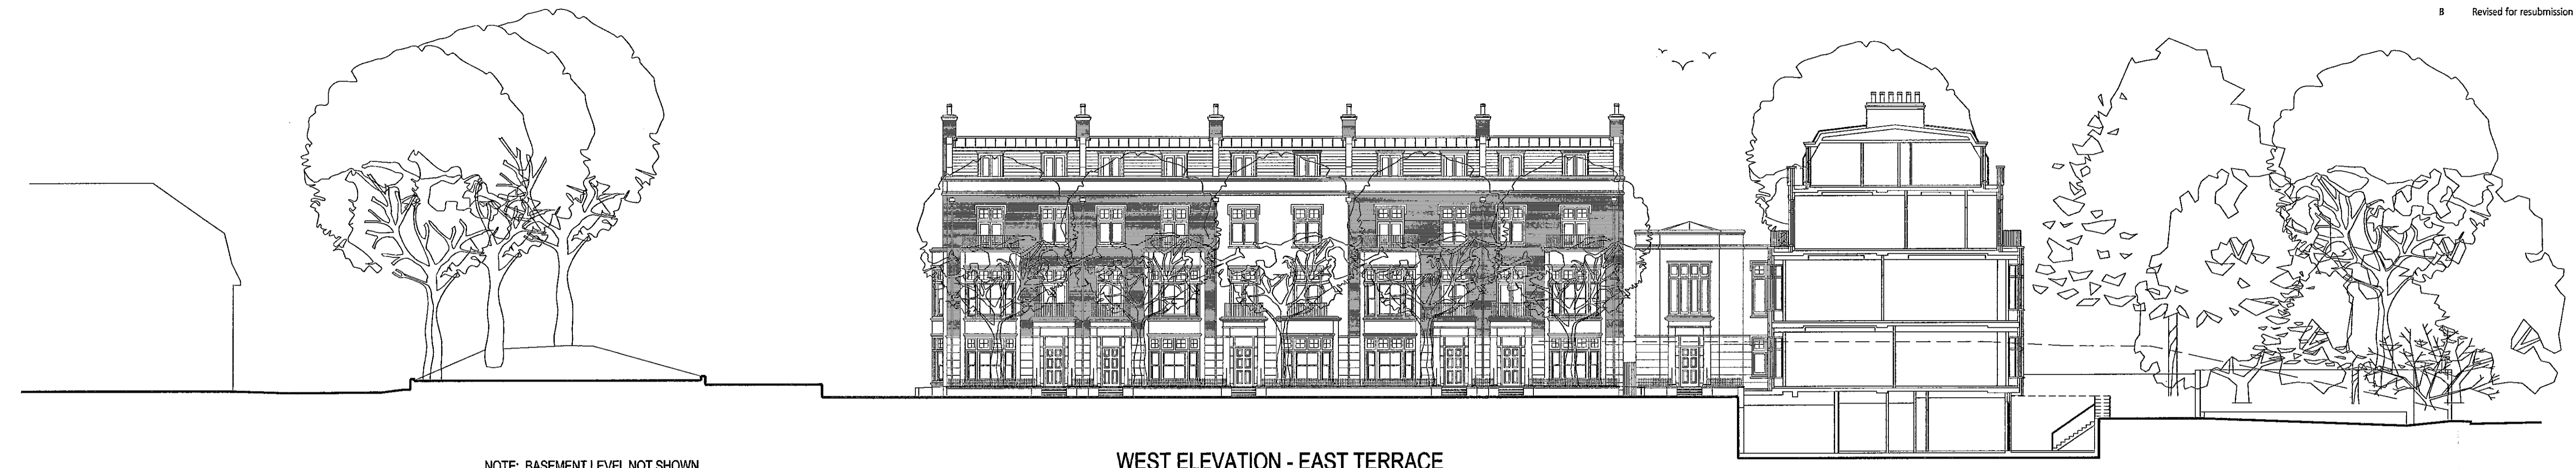


NOTE: BASEMENT LEVEL NOT SHOWN

WEST ELEVATION - EAST TERRACE
SECTION A-A



EAST ELEVATION - EAST TERRACE
SECTION B-B

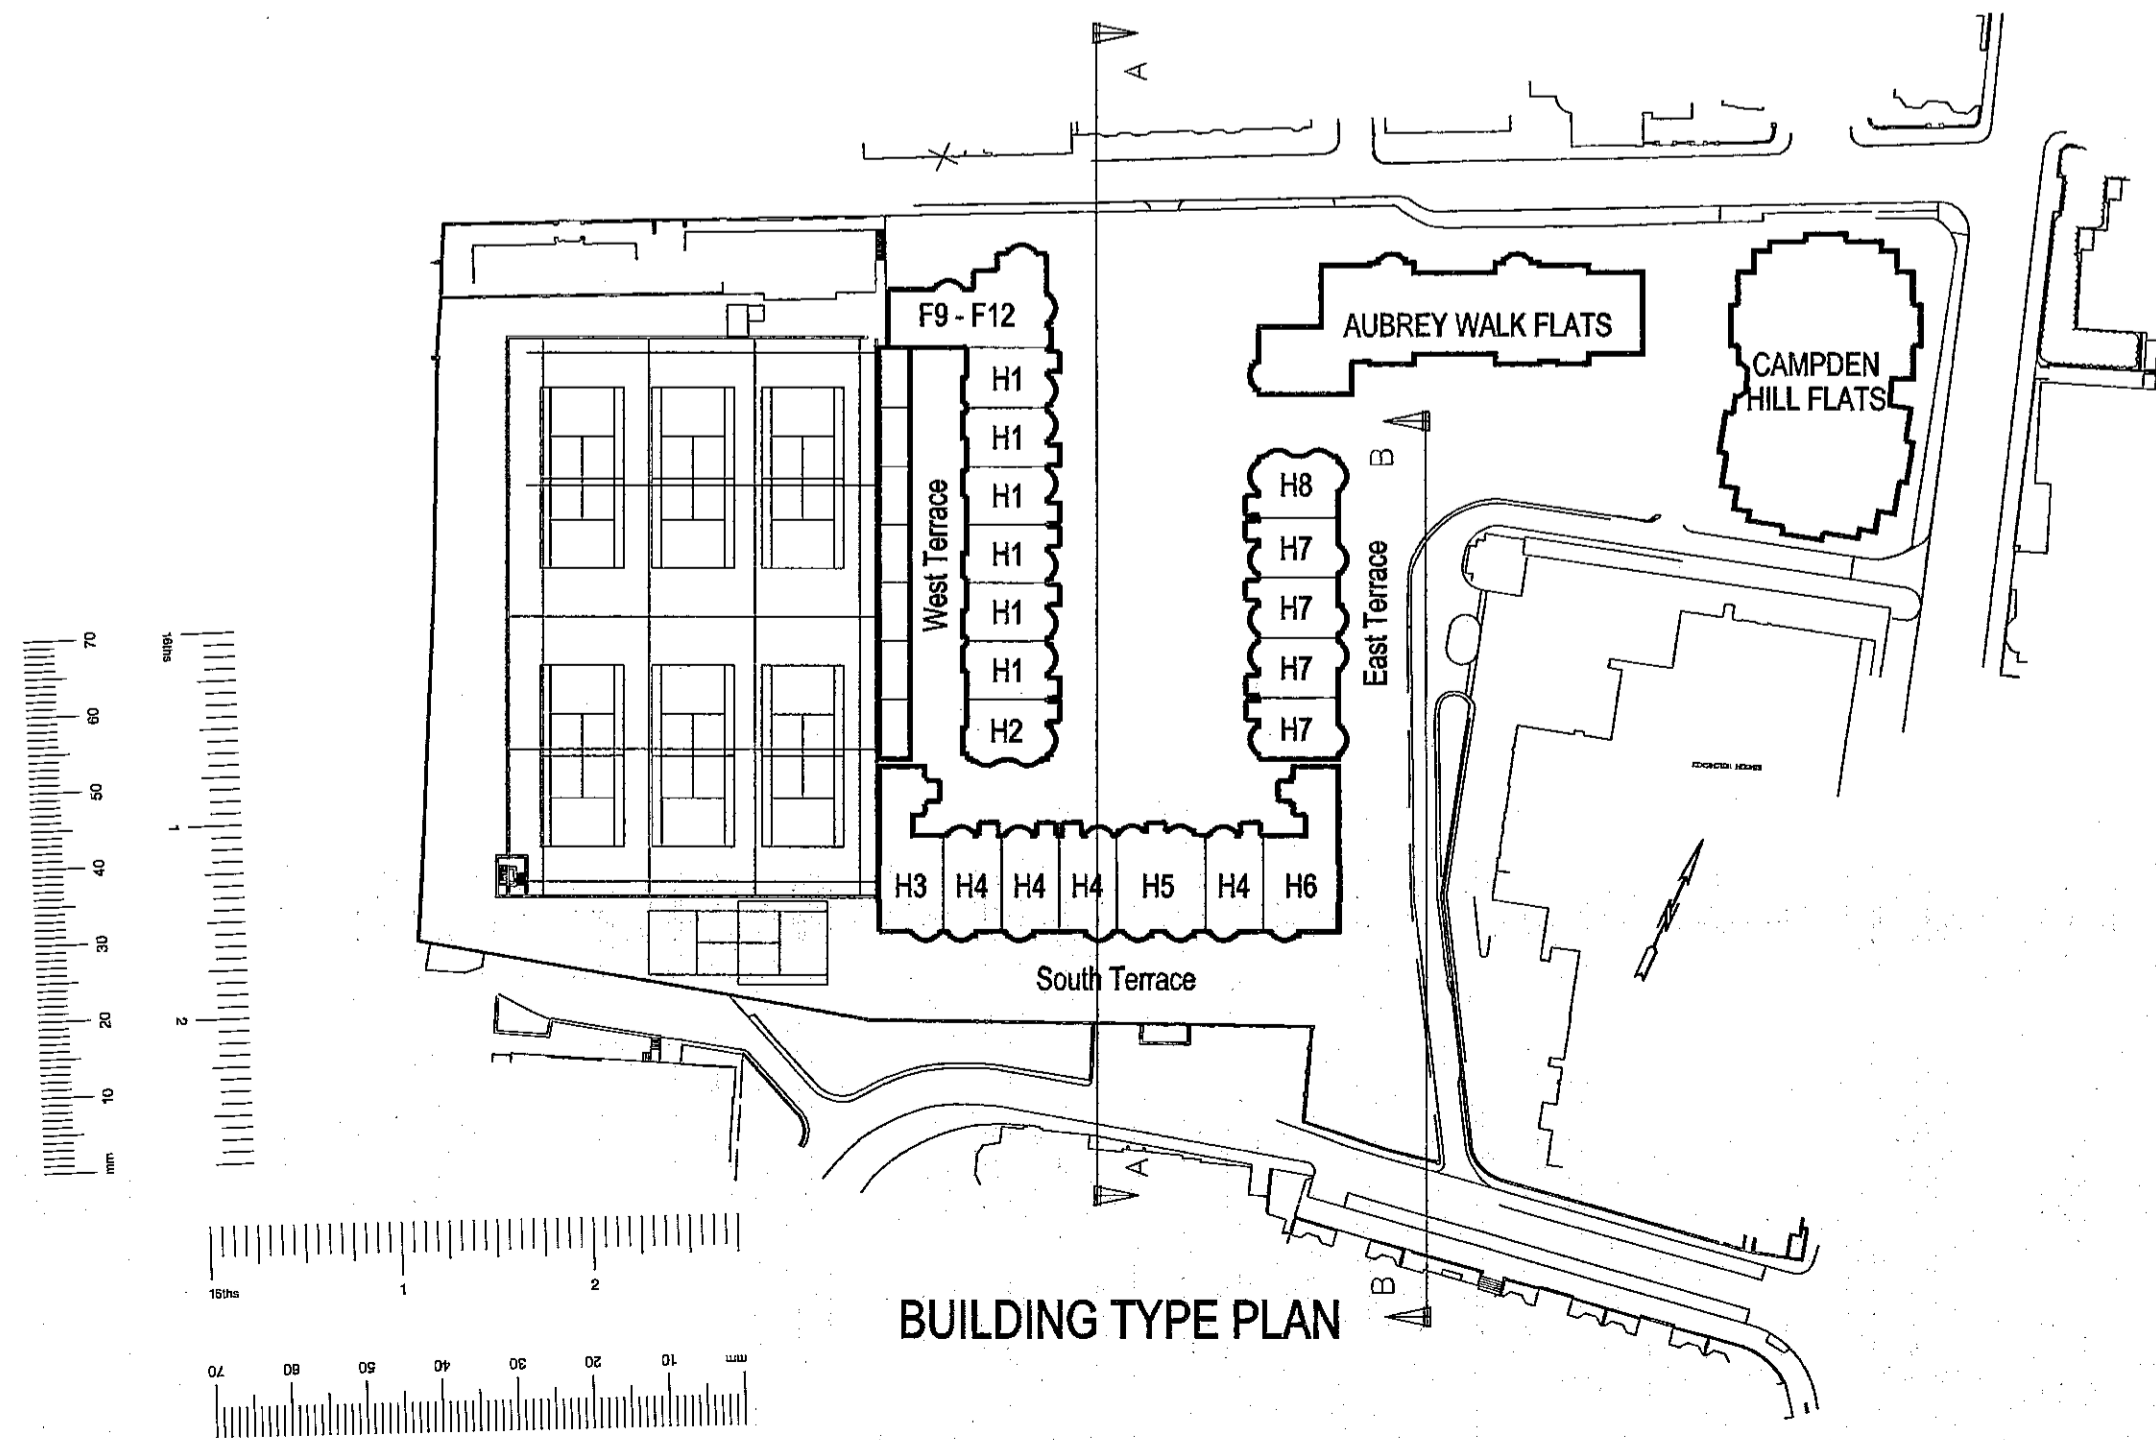

RECEIVED
26 JUL 2000

BroadwayMalyan
Architects & Designers
Woburn Hill, Addlestone
Weybridge, Surrey KT15 2QA
T: +44(0)1932 845599
F: +44(0)1932 856206
E: Wey@BroadwayMalyan.com


Client
St. James Homes Ltd
Project
Campden Hill Reservoir
Description
East Terrace
Front & Rear Elevations

Status
Planning
Scale
1:200
Job number
7650
Original size 100mm

Drawn
Date
Dec '99
Revision
B
Drawing number
P103
Copyright Broadway Malyan Limited


Contractors are not to scale dimensions from this drawing

Revision	Date
A	Elevations and key plan updated. 16.03.99
B	Revised for resubmission 01.00
C	East terrace boundary wall revised for resubmission. 22.08.00
D	South East end of terrace dwelling rear boundary revised for resubmission. 30.08.00

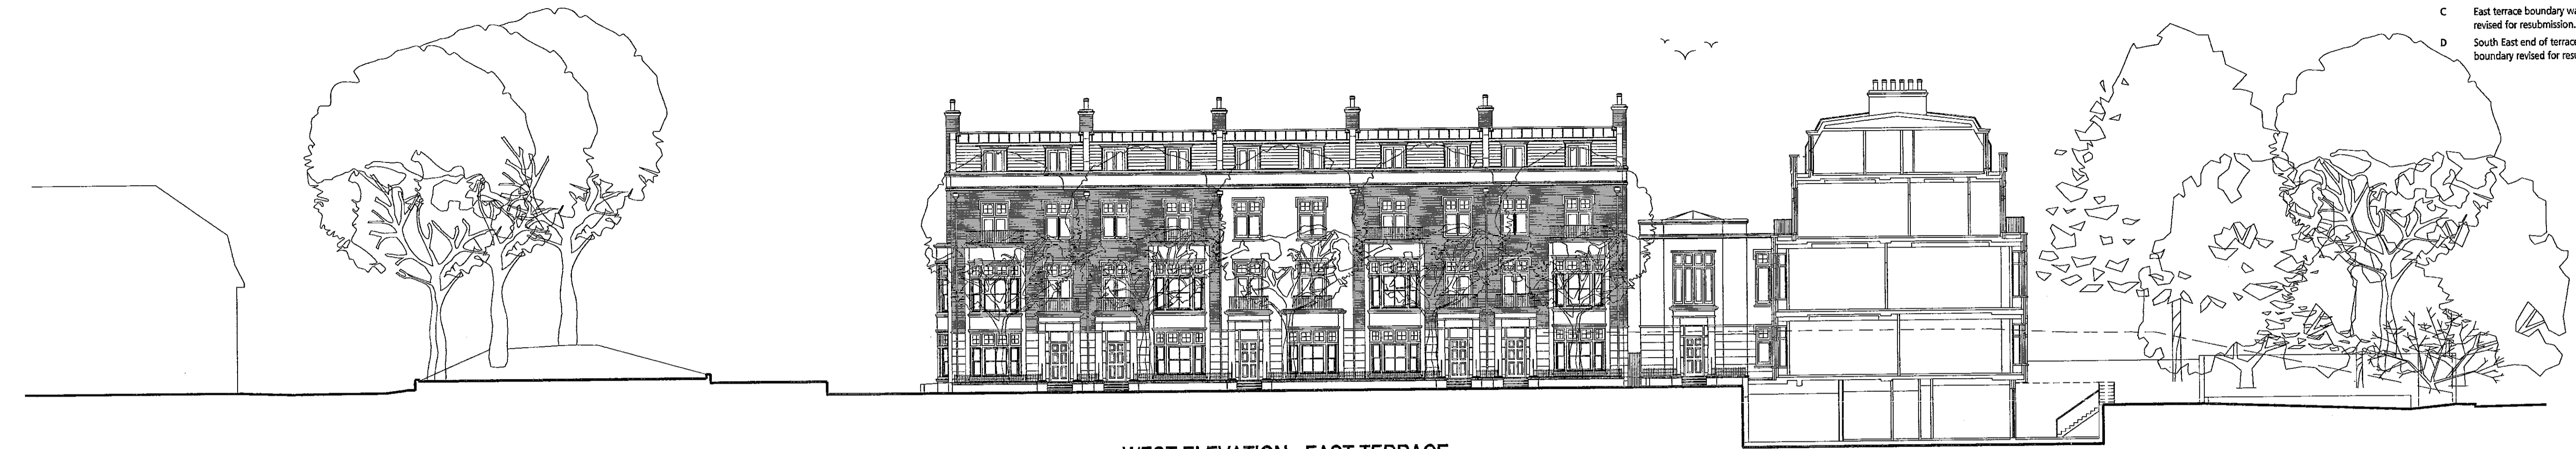


NOTE: BASEMENT LEVEL NOT SHOWN

WEST ELEVATION - EAST TERRACE SECTION A-A

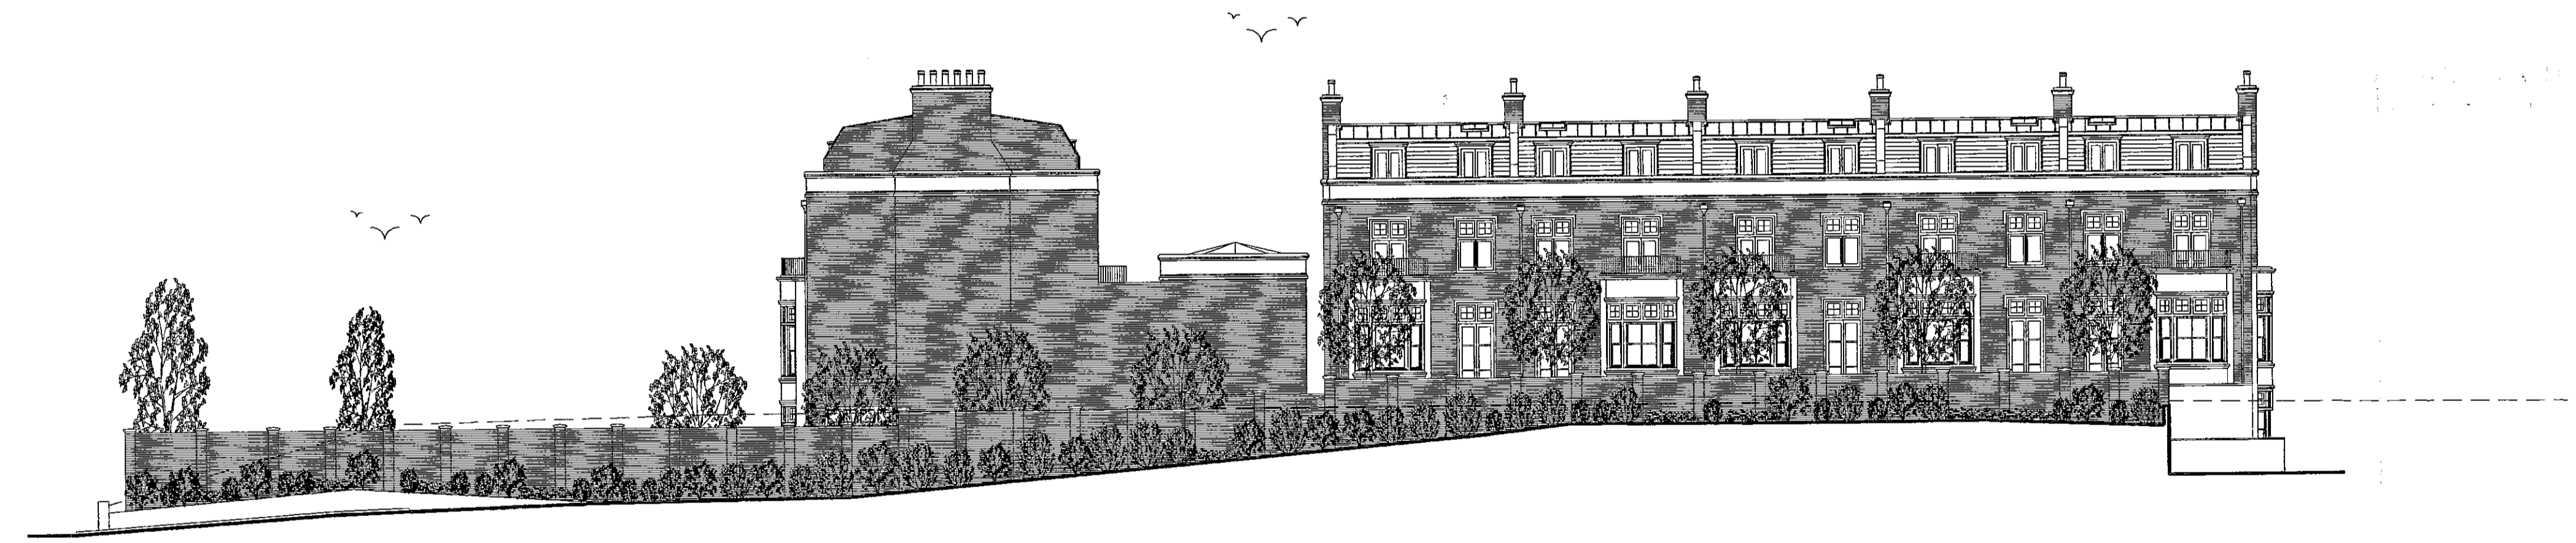

EAST ELEVATION - EAST TERRACE SECTION B-B

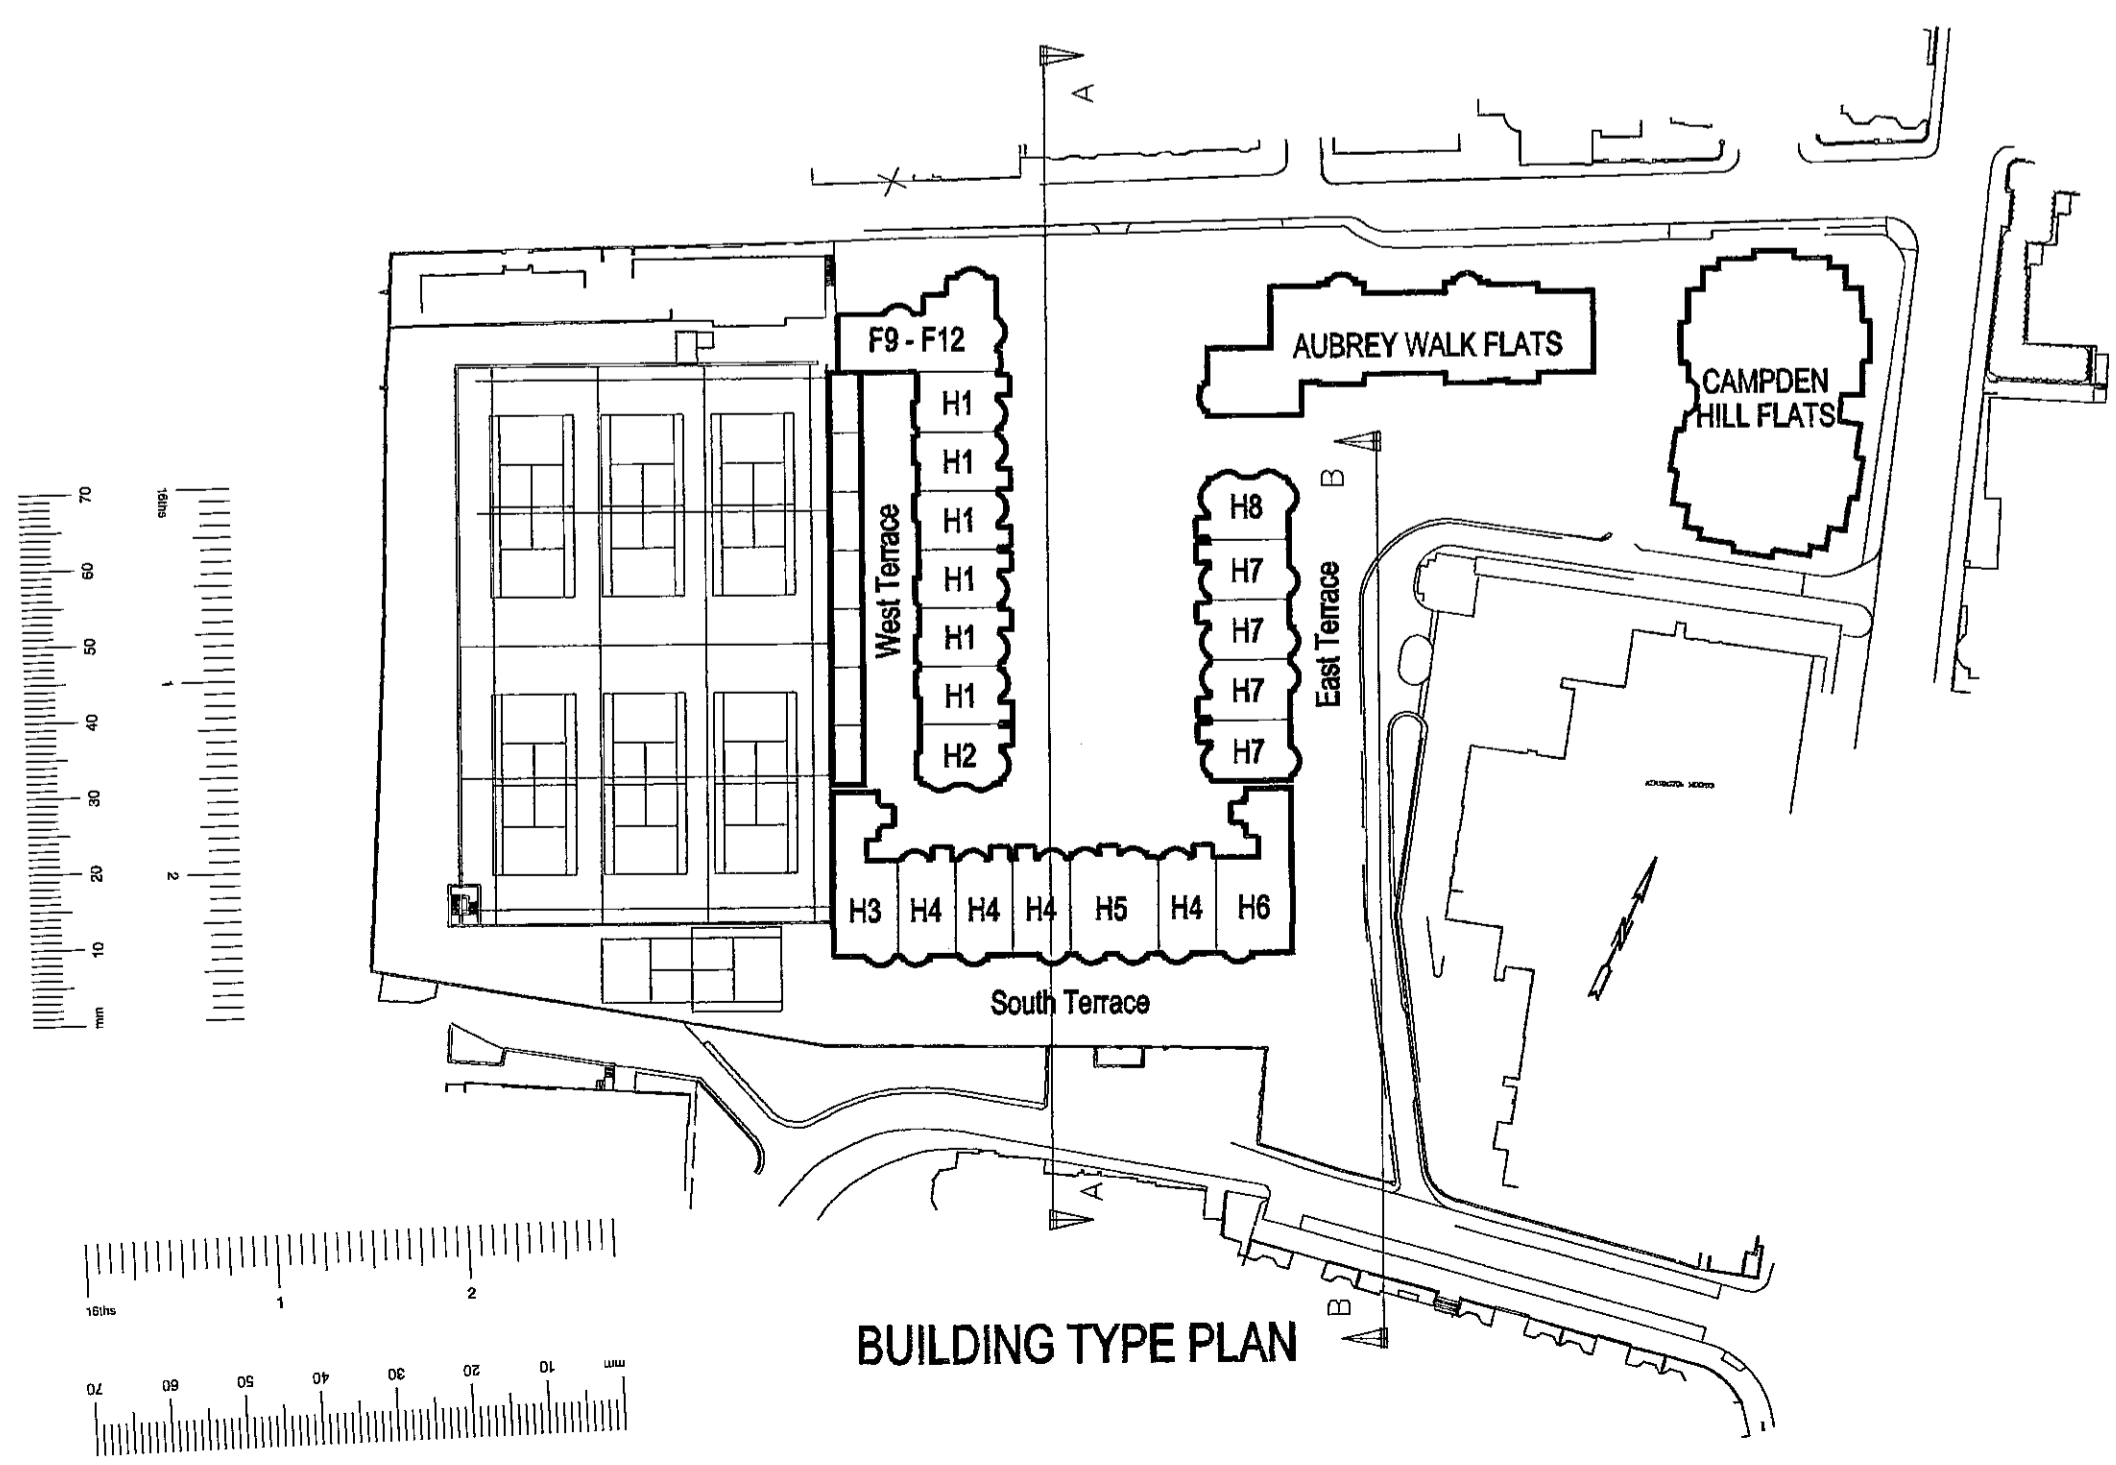

BUILDING TYPE PLAN

BroadwayMalyan
Architects & Designers

Woburn Hill, Addlestone
Weybridge, Surrey KT15 2QA
T: +44(0)1932 845599
F: +44(0)1932 856206
E: Wey@BroadwayMalyan.com

Client
St. James Homes Ltd
Project
Campden Hill Reservoir
Description
East Terrace
Front & Rear Elevations


Status
Planning
Scale
1:200
Job number
7650
Original size 100mm

Drawn
Date
Dec '99
Drawing number
P103
Revision
D
Copyright Broadway Malyan Limited


TP/99/0733(4)

Contractors are not to scale dimensions from this drawing

Revision	Date
A	Elevations and key plan updated. 16.03.99
B	Revised for resubmission. 01.00
C	Minor revisions to west terrace flats roof. 12.07.00

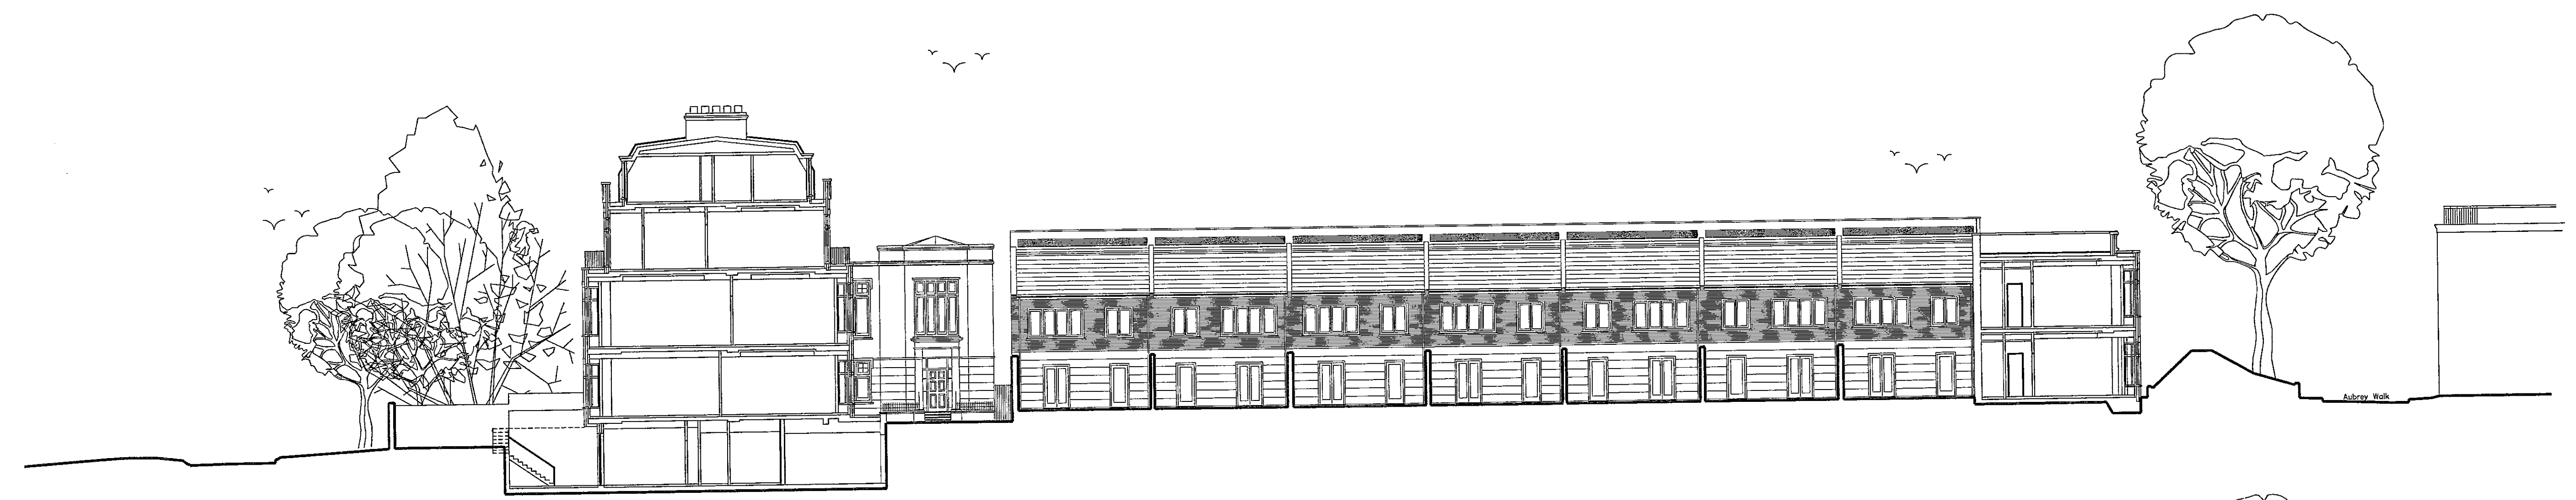


STUDIO EAST ELEVATION - WEST TERRACE
SECTION A-A

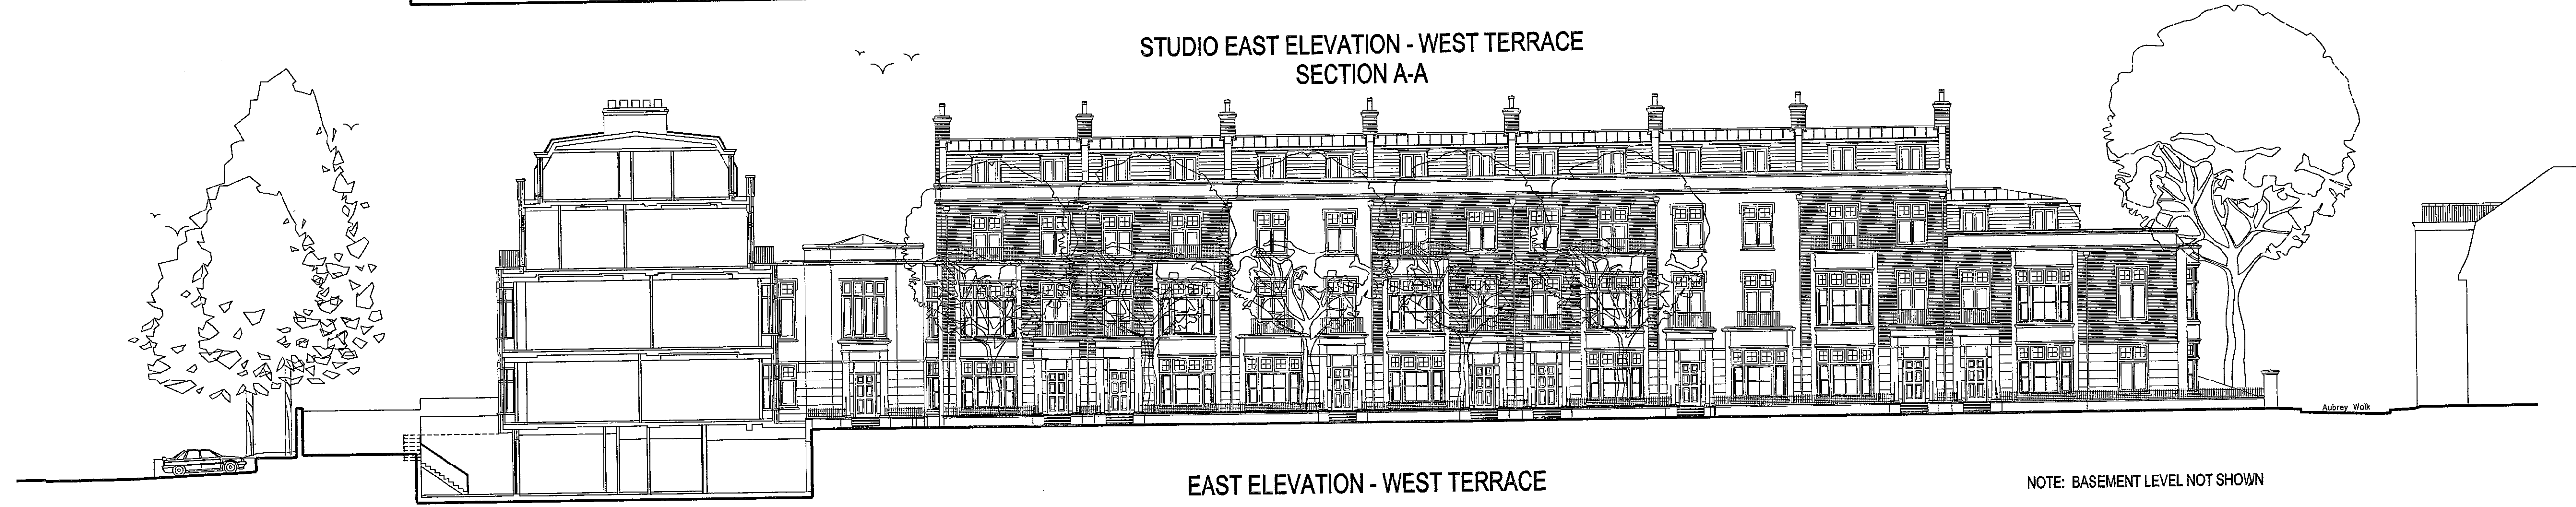


EAST ELEVATION - WEST TERRACE
SECTION B-B


NOTE: BASEMENT LEVEL NOT SHOWN

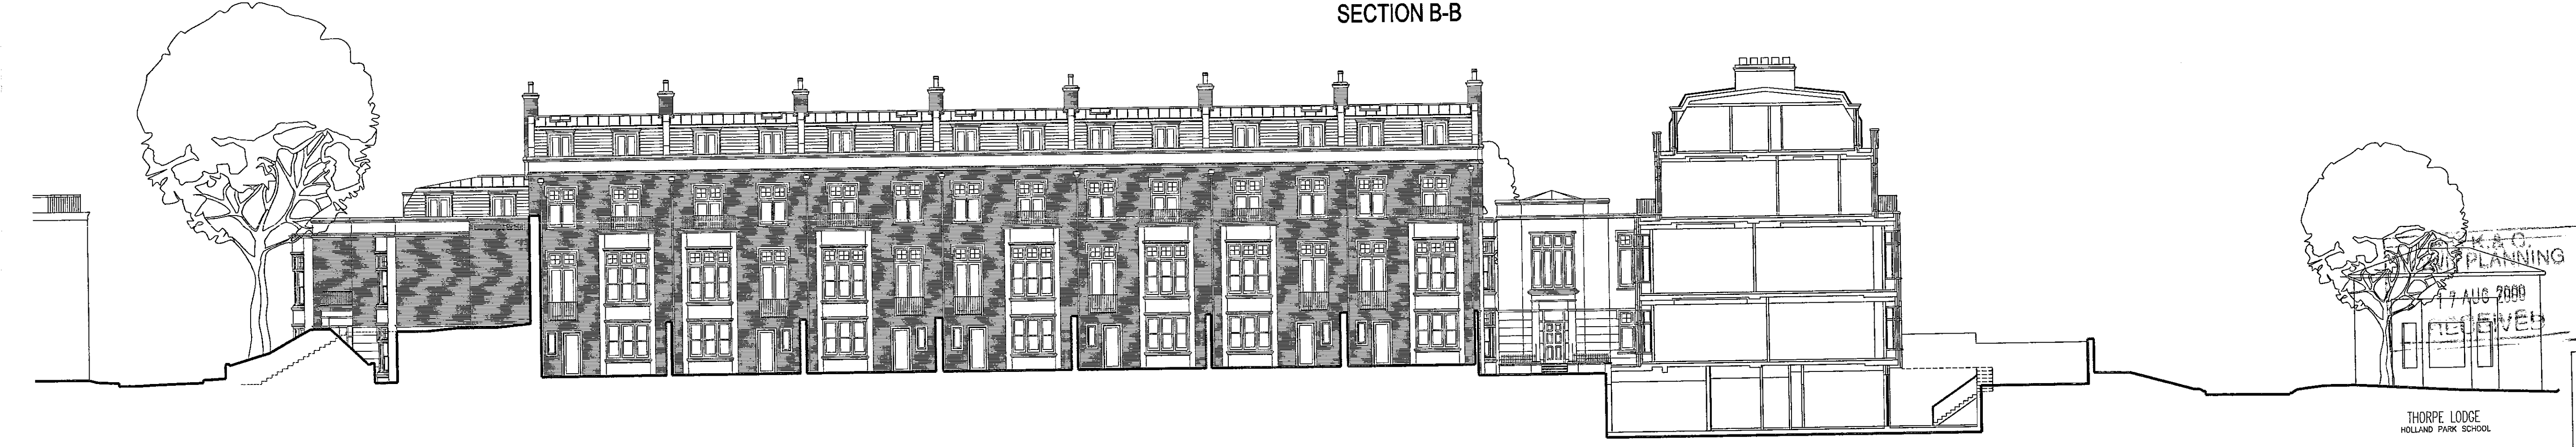

WEST ELEVATION (REAR) - WEST TERRACE
SECTION C-C

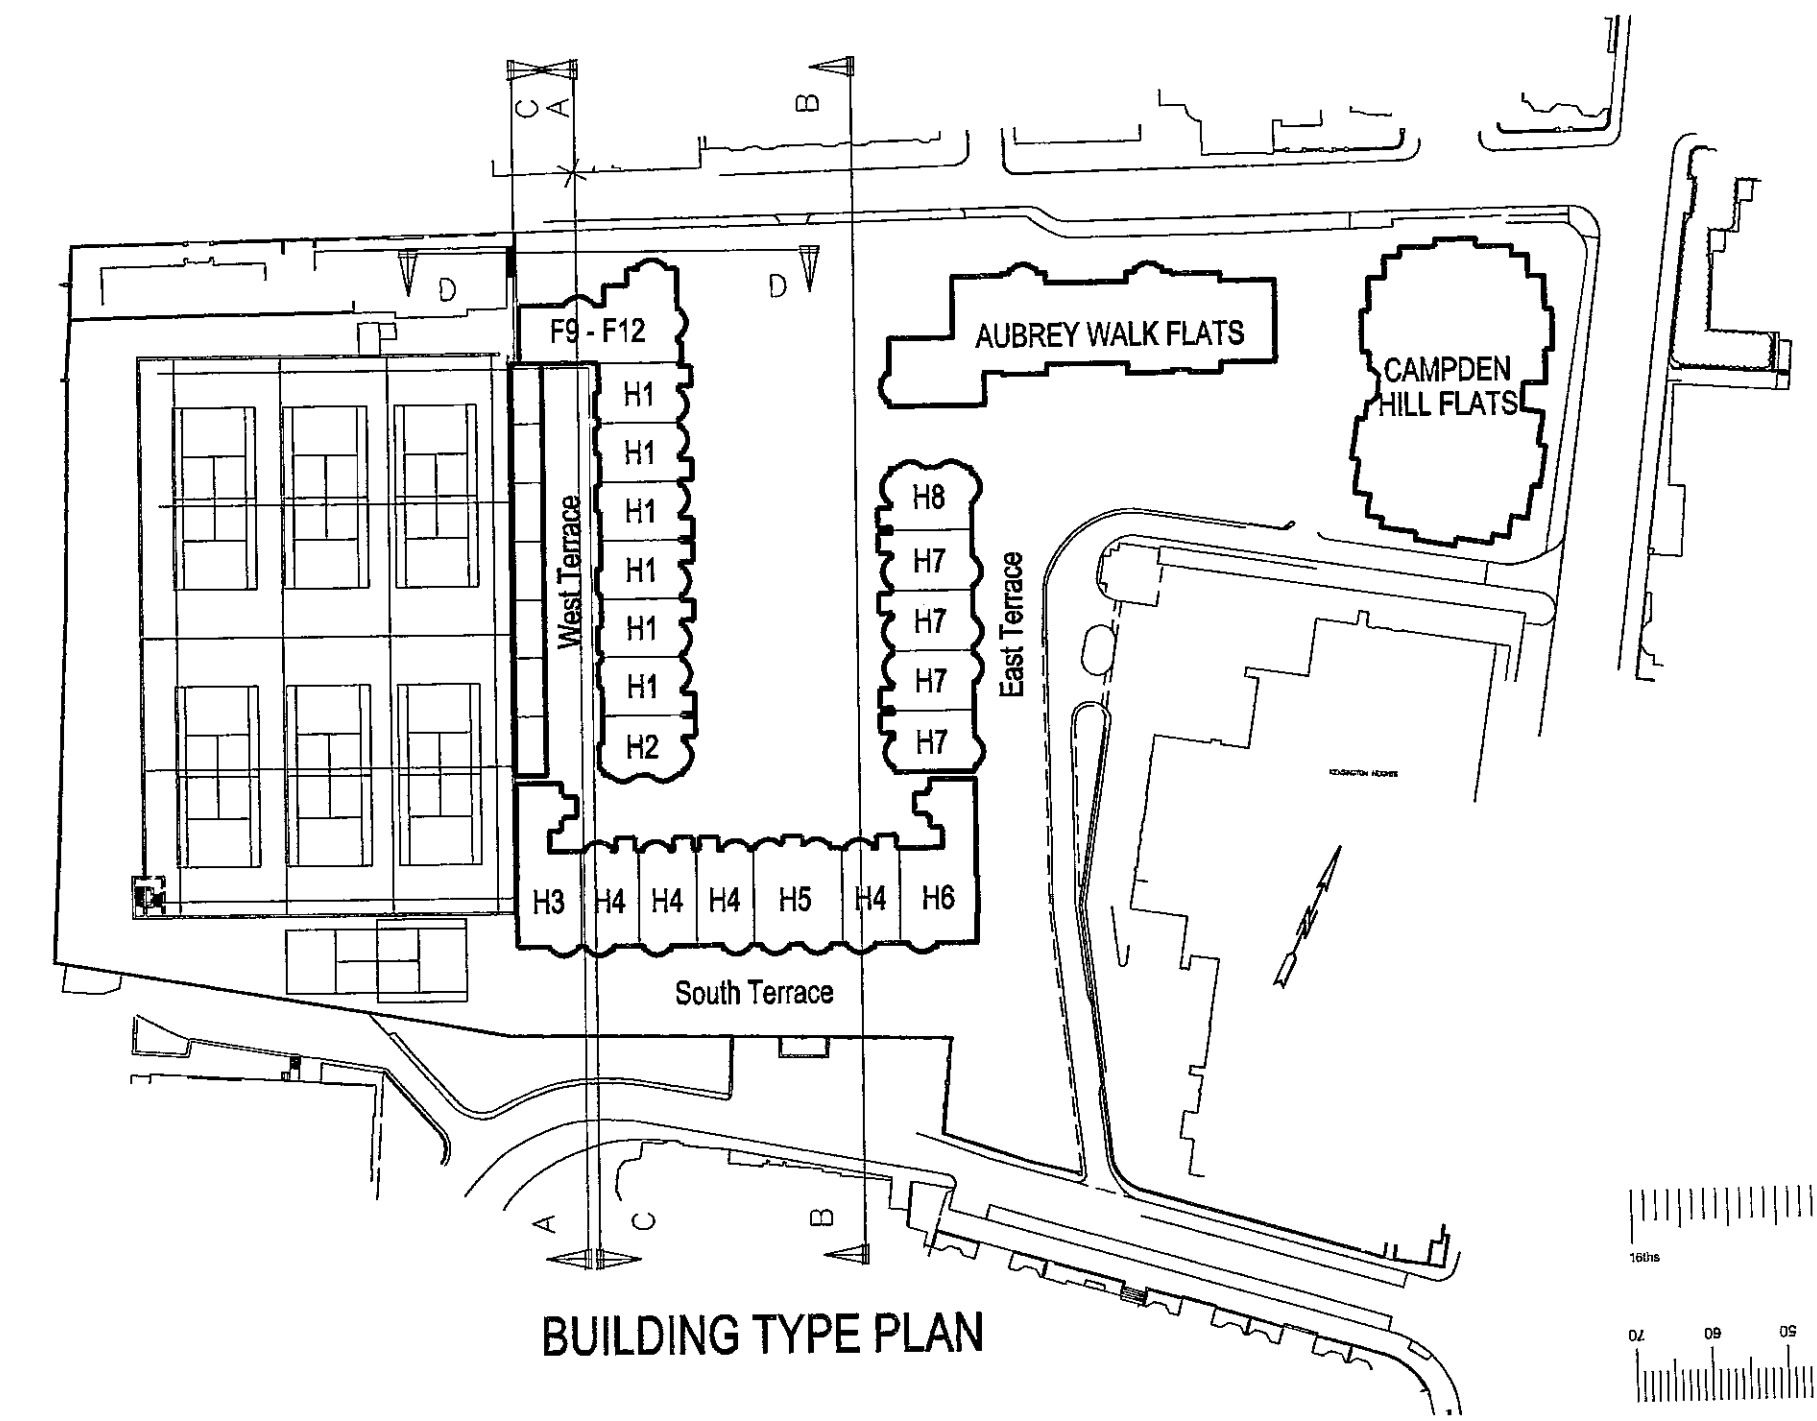

BUILDING TYPE PLAN

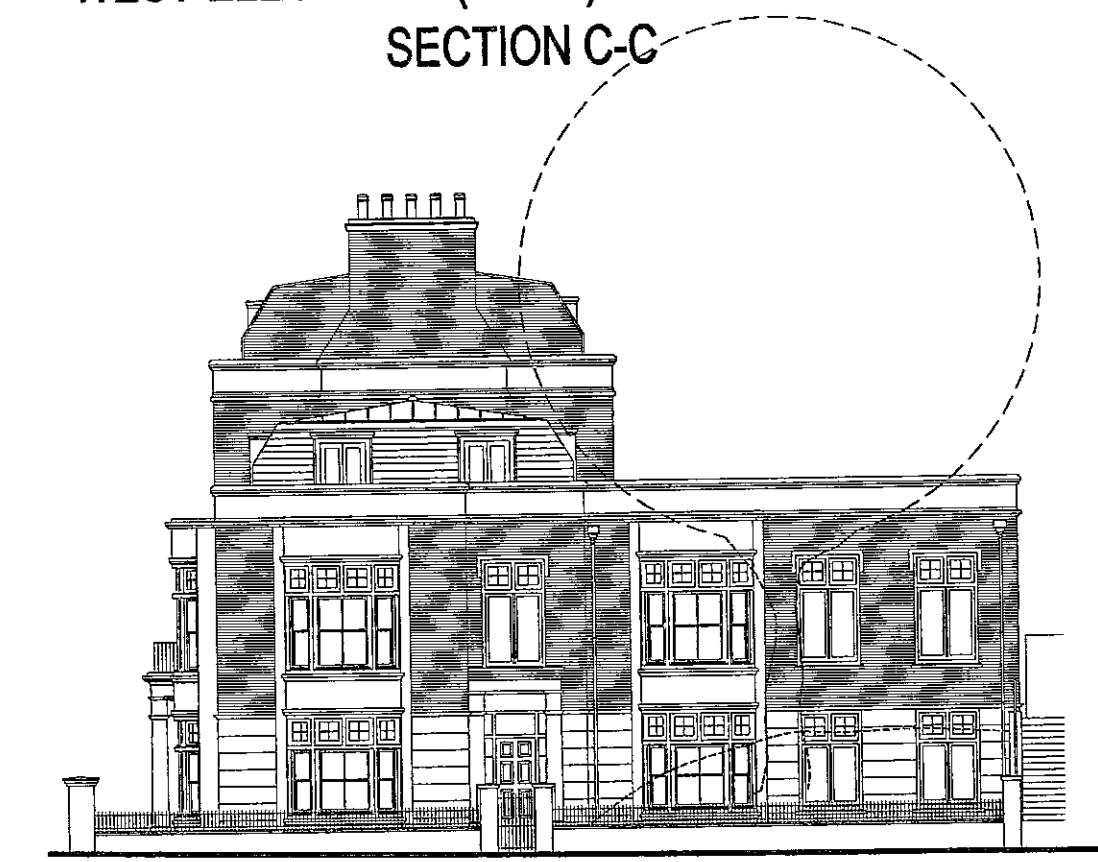

NORTH ELEVATION - WEST TERRACE
SECTION D-D

BroadwayMalyan
Architects & Designers

Woburn Hill, Addlestone
Weybridge, Surrey KT15 2QA
T: +44(0)1932 845999
F: +44(0)1932 856206
E: Wey@broadwaymalyan.com

Client
St. James Homes Ltd
Project
Camden Hill Reservoir
Description
Studio & West Terrace Elevations

Status	Scale	Drawn	Date
Planning	1:200		Dec '99
Job number	Drawing number	Revision	
7650	P104	C	

Original size 100mm Copyright Broadway Malyan Limited