



**PLAN SHOWING REVISED LOCATION OF FAN COIL UNIT**

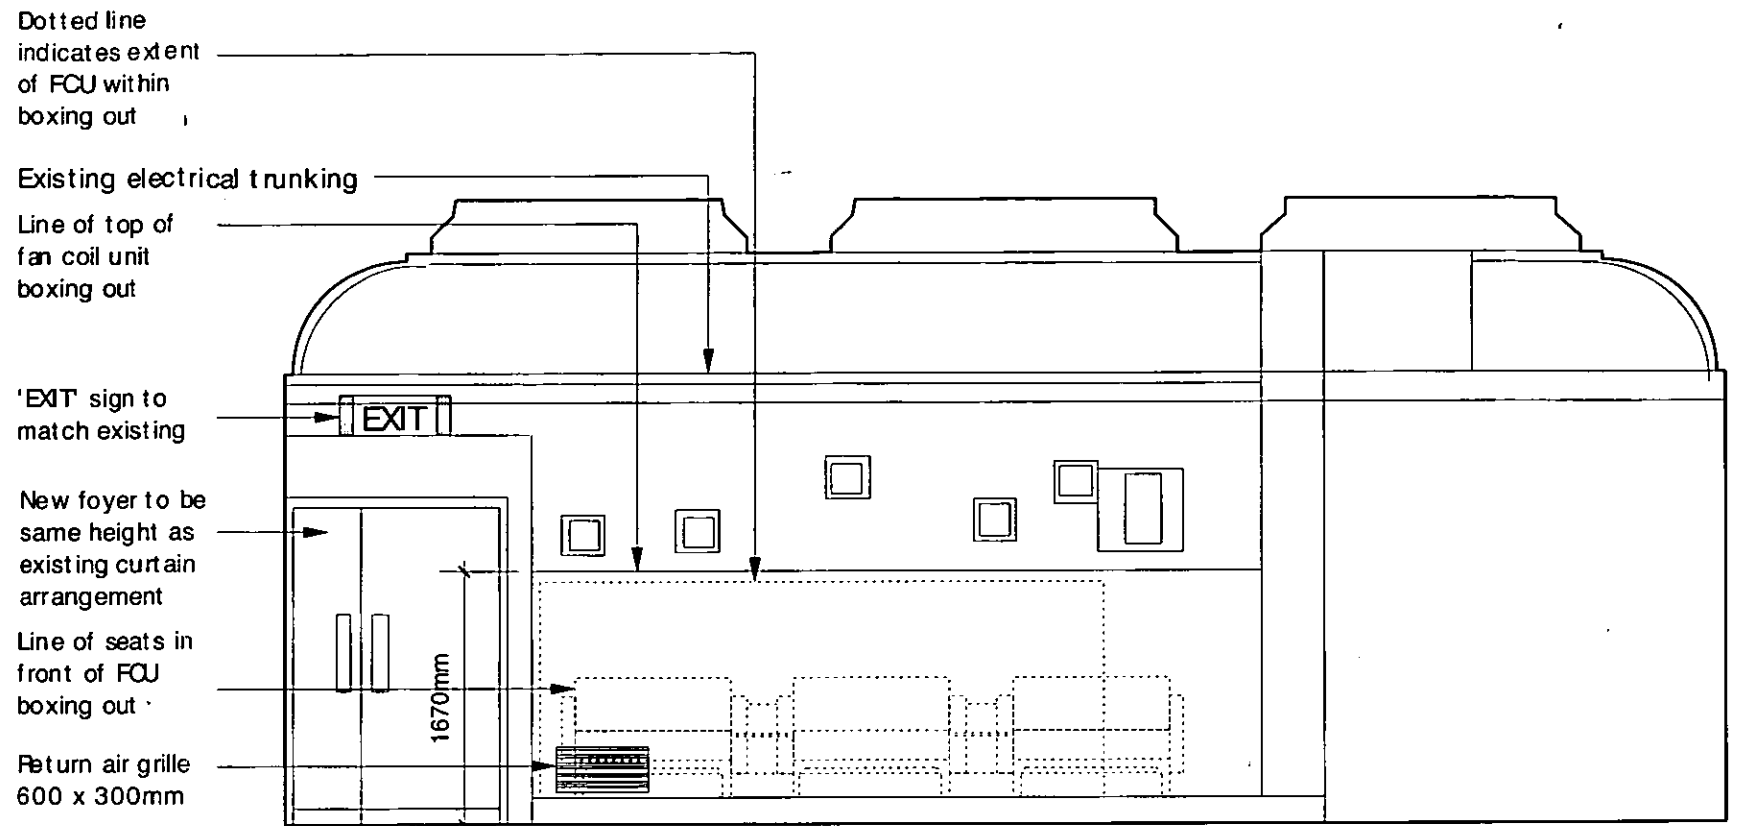

**ELEVATION SHOWING REVISED LOCATION OF NEW FCU**

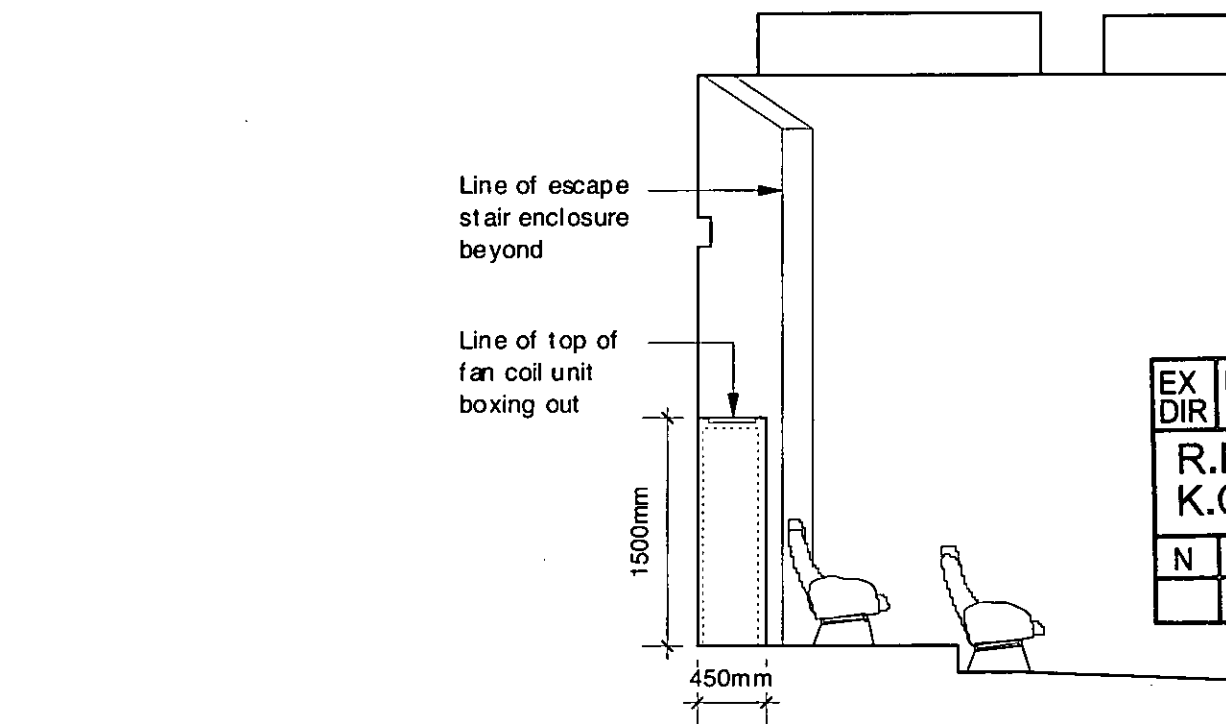

**SECTION SHOWING REVISED LOCATION OF NEW FCU**

EX DIR	HDC	TP	CAC	AD	CLU	AO AK
R.B.	K.C.	21	JUL	2004	PLANNING	
N	C	SW	SE	APP	JO	REC
				ARB	PLN	DES FEES

**DELEGATED APPROVAL**  
- 4 AUG 2004


A.

REVISION	DATE	DRAWN BY	JB	DRAWING	Revised FCU location in auditorium	Jcb. No.	304
		CHECKED BY		PROJECT	Gate Cinema, Notting Hill	Dwg. No.	SK/09
		REVISION BY		SCALE	1:50 @ A3	DATE	19.07.04
		REVISION CHECKED BY		DO NOT SCALE THIS DRAWING. CHECK ALL DIMENSIONS ON SITE. IF IN DOUBT ASK. <small>If information contained in this drawing is a site copy right of Pantar Hudspith Architects and is not to be reproduced without their permission.</small>			

**PH**  
PANTER HUDSPITH ARCHITECTS  
235, Southwark Bridge Road, London, SE1 6NP  
Telephone: 020 7407 2788 Fax: 020 7403 4178  
www.pantaruhspith.com Email: info@pantaruhspith.com

LUXBRIDGE STREET

FARMER STREET

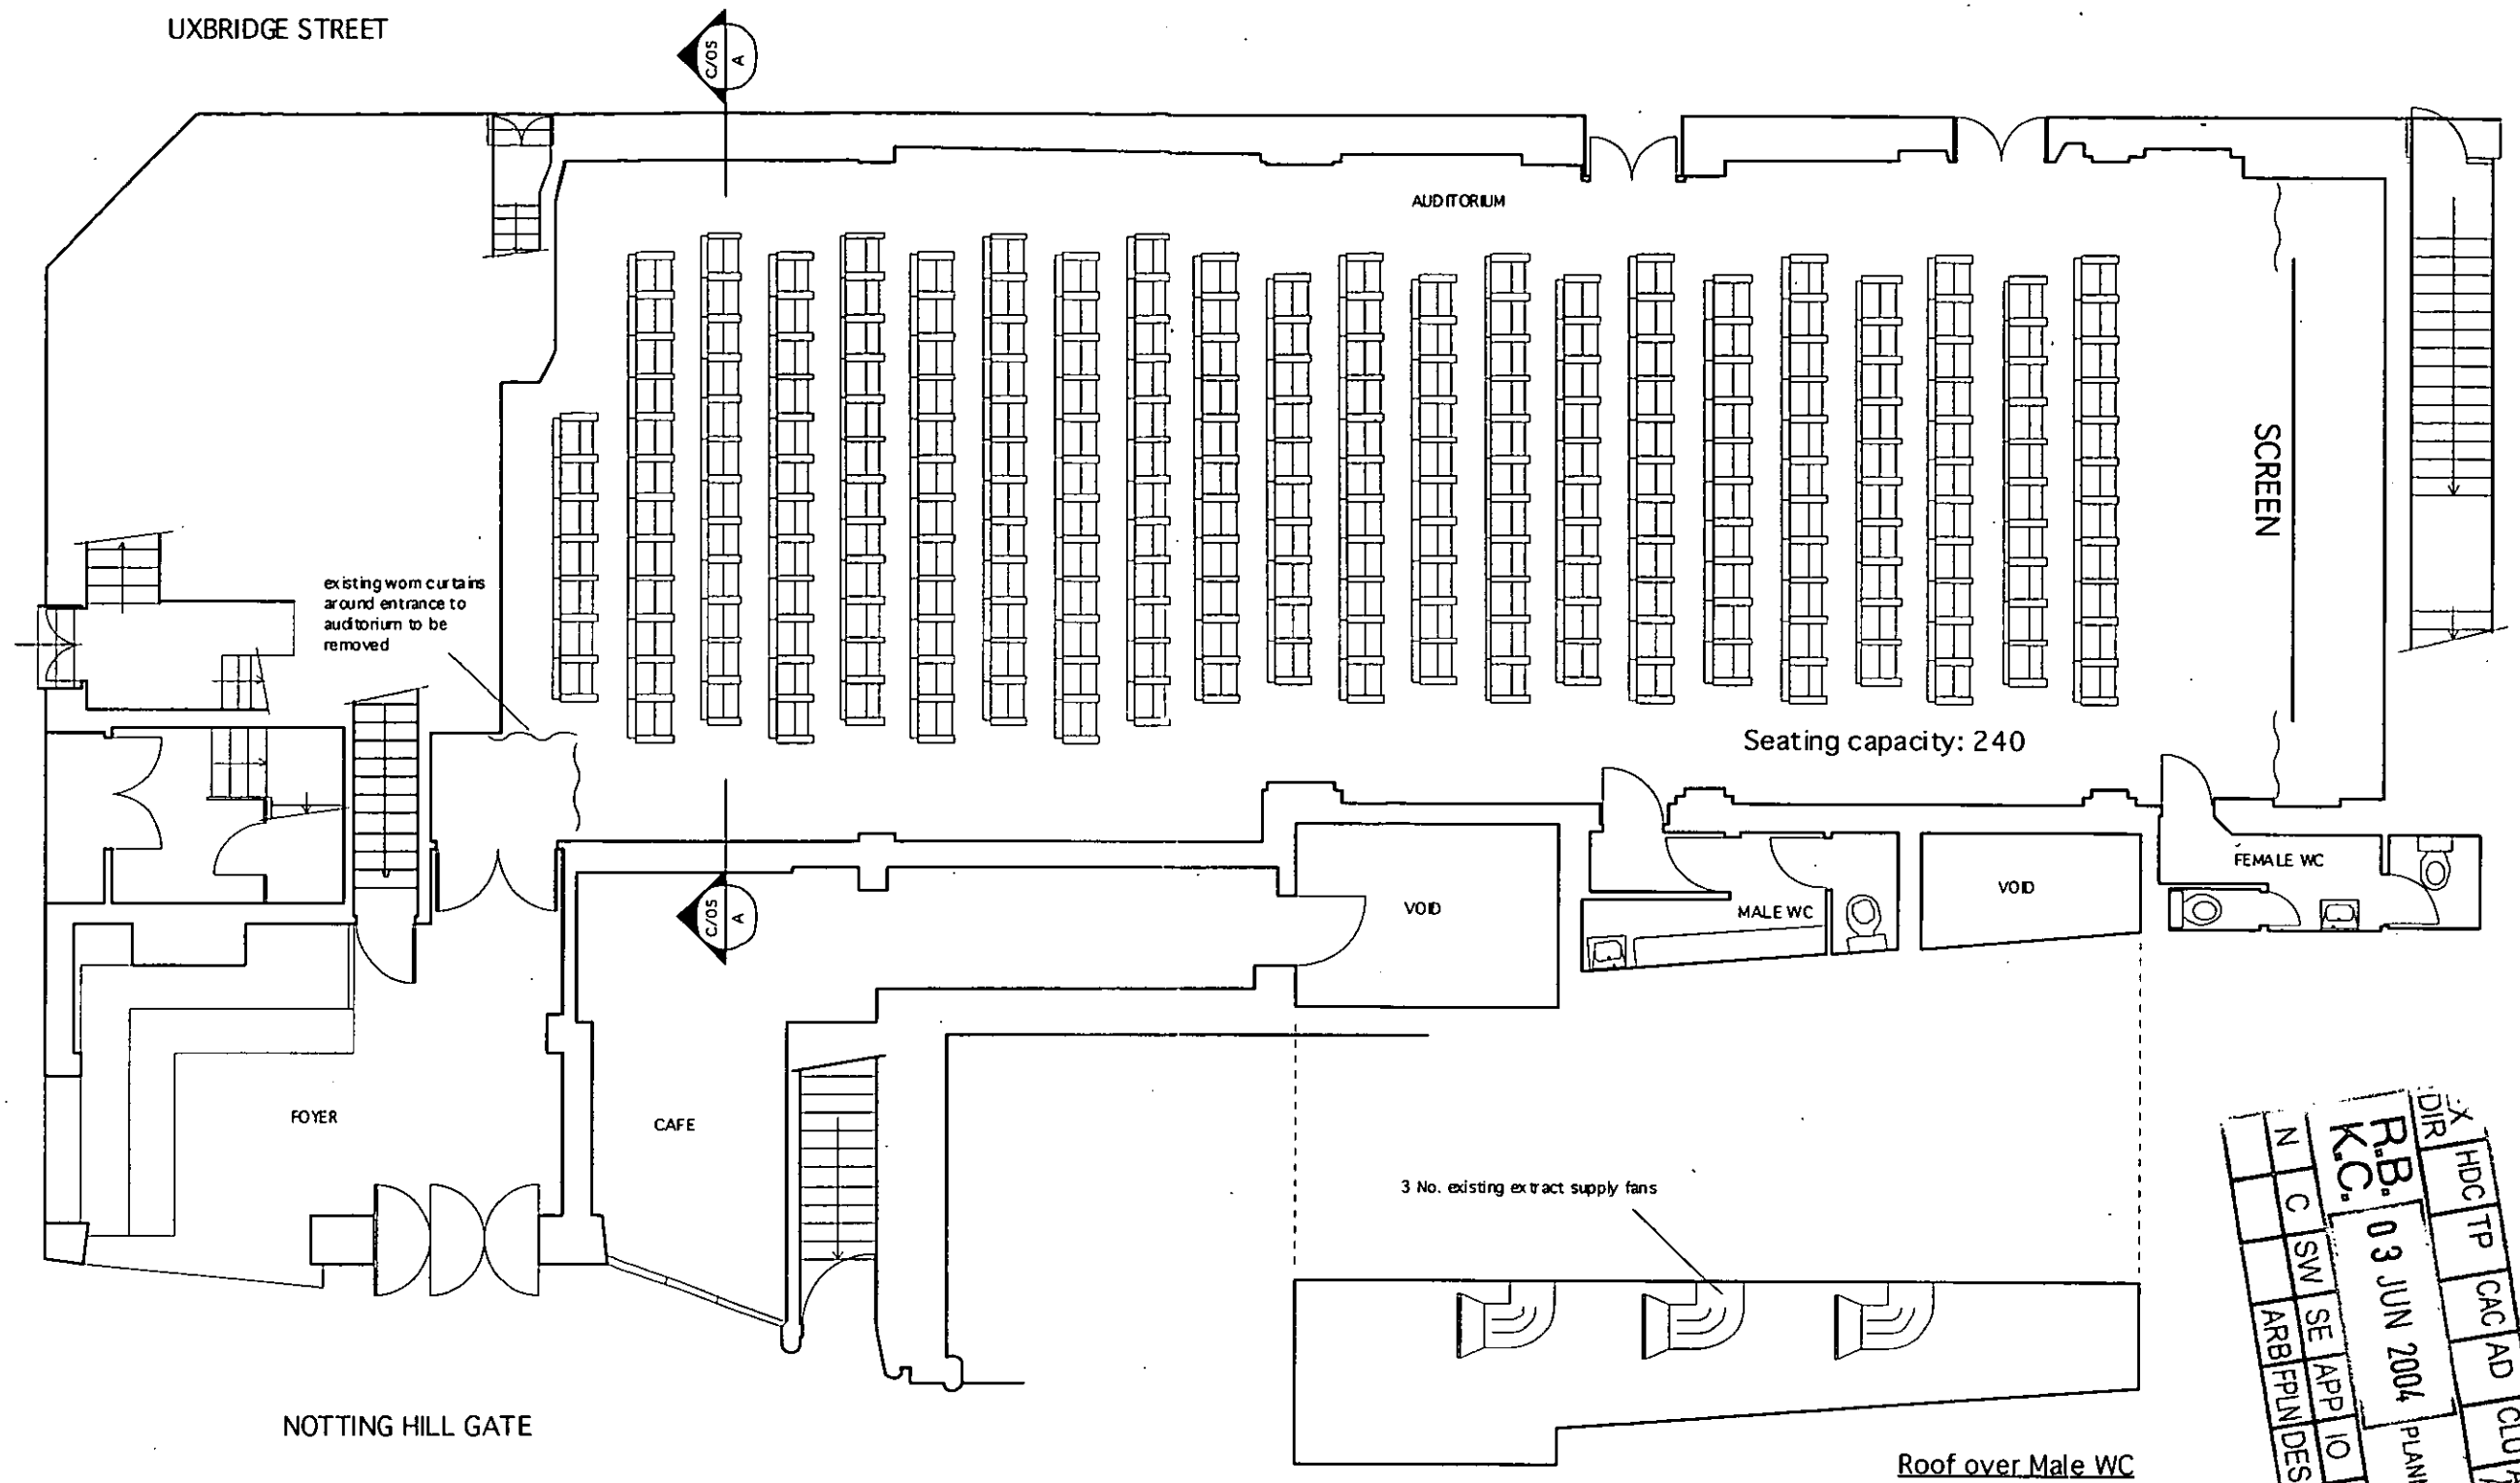


NOTTING HILL GATE

DIR	X	HDC	TP	CAC	AD	CLU	AR
N	C	SW	SE	APP	IO	REC	DES
ARB	FP	PLN	DES	FEES			
R.B. 03 JUN 2004							
K.C. PLANNING							

**DELEGATED APPROVAL**  
4 AUG 2004

REVISION	DATE	DRAWN BY	DRAWING	Job No.
		CHECKED BY	Auditorium and foyer plan Existing	304
		REVISION BY	PROJECT Gate Cinema, Notting Hill	C/04
		REVISION CHECKED BY	SCALE 1:100 at A3	Dwg. No.
			DATE May 2004	
DO NOT SCALE THIS DRAWING. CHECK ALL DIMENSIONS ON SITE. IF IN DOUBT ASK. All information contained in this drawing is sole copy right of Panter Hudspith Architects and is not to be reproduced without their permission.				

**PANTER HUDSPITH ARCHITECTS**  
 235, Southwark Bridge Road, London, SE1 8NP  
 Telephone: 020 7407 2788 Fax: 020 7403 4178  
 www.panterhudspith.com Email: info@panterhudspith.com

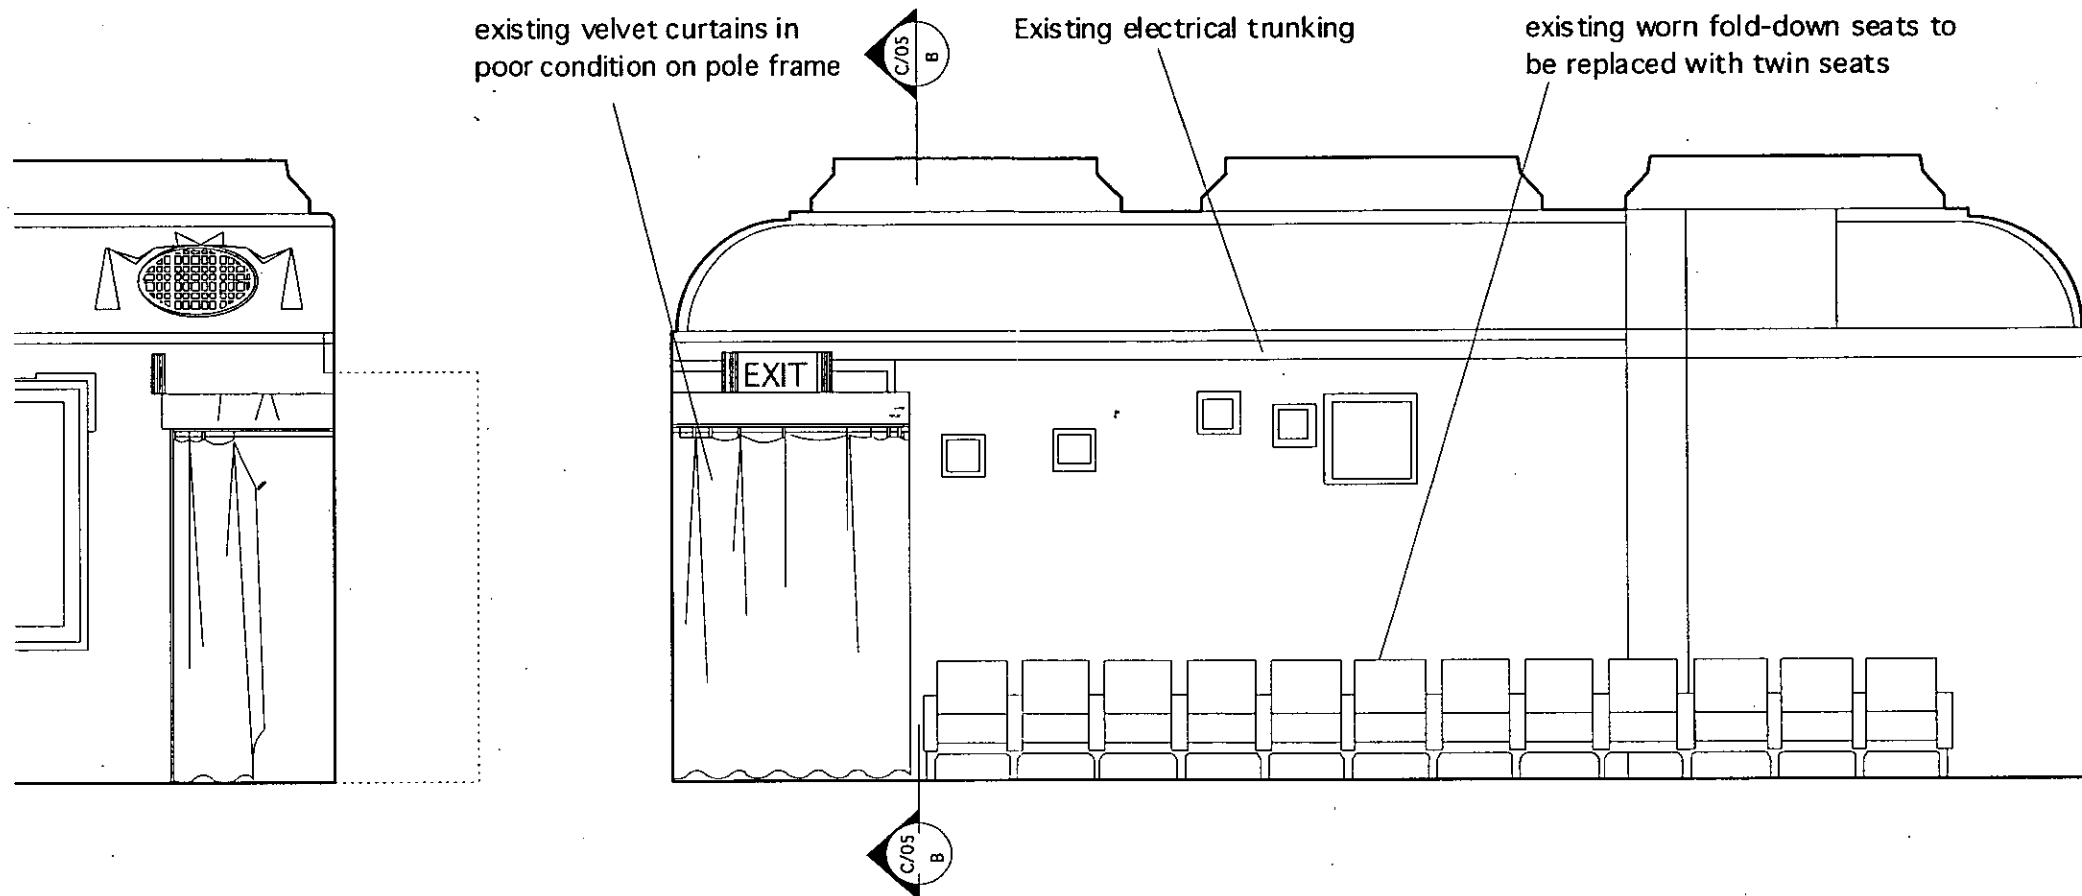

C/05 Elevation BB - Existing  
B

C/05 Elevation AA - Existing  
A

EX DIR	HDC	TP	CAC	AD	CLU	AC
R.B.	K.C.	03 JUN 2004	PLANNING			
N	C	SW	SE	APP	IO	REC
		ARB	FPLN	DES	FEE	

**DELEGATED APPROVAL**  
- 4 AUG 2004

REVISION	DATE	DRAWN BY	DRAWING	Job No.
		CHECKED BY	Auditorium entrance and rear wall Existing	304
		REVISION BY	PROJECT Gate Cinema, Notting Hill	Rev. C/05
		REVISION CHECKED BY	SCALE 1:50 at A3 DATE May 2004	
			DO NOT SCALE THIS DRAWING. CHECK ALL DIMENSIONS ON SITE. IF IN DOUBT ASK. <small>All information contained in this drawing is the sole copy right of Panter Hudspith Architects and is not to be reproduced without their permission.</small>	

**PANTER HUDSPITH ARCHITECTS**  
 235, Southwark Bridge Road, London, SE1 8NP  
 Telephone: 020 7407 2788 Fax: 020 7403 4178  
 www.panterhudspith.com Email: info@panterhudspith.com

UXBRIDGE STREET

FARMER STREET

NOTTING HILL GATE

Twin seats separated by drinks shelf

Paired seats separated by drinks shelf

New carpet

NEW SEATING THROUGHOUT

Fold down seats, seat width 550mm

Existing fire exits retained

Existing curtains

External intake bouvre

1150mm

1000mm

AUDITORIUM

Seating capacity: 185

SCREEN retained as existing

AIR SUPPLY UNIT

New partition and door to match existing

Single step with high visibility nosing

New bar and ticketing counter

Existing doors retained

CAFE

VOID

MALE WC

VOID

FEMALE WC

WCs retained as existing

WCs retained as existing

FOYER

Existing doors retained

new fan unit to replace existing fans

Roof over Male WC

Works to foyer approved March 2004  
RPKC Ref: LB/04/00146

EX DIR	HDC	TP	CAC	AD	CLU	A
R.B.	K.C.	03 JUN 2004	PLANNING			
C	SW	SE	APP	IO	REC	
	ARB	FPLN	DES	FEE		

**DELEGATED APPROVAL**  
- 4 AUG 2004

REVISION	DATE	DRAWN BY	DRAWING	Job No.	304 C/06
		CHECKED BY	Auditorium and foyer Plan Poposed	Rev.	
		REVISION BY	PROJECT Gate Cinema, Notting Hill	Dwg. No.	
		REVISION CHECKED BY	SCALE 1:100 at A3	DATE May 2004	
			DO NOT SCALE THIS DRAWING. CHECK ALL DIMENSIONS ON SITE. IF IN DOUBT ASK. <small>All information contained in this drawing is the sole copyright of Panter Hudspith Architects and is not to be reproduced without their permission.</small>		

**PANTER HUDSPITH ARCHITECTS**  
235, Southwark Bridge Road, London, SE1 6NP  
Telephone: 020 7407 2788 Fax: 020 7403 4178  
www.panterhudspith.com Email: info@panterhudspith.com

EB J41269

EX DIR	HDC	TP	CAC	AD	CLU	AO AK
R.B. K.C.	09 JUN 2004				PLANNING	
N	C	SW	SE	APP	IO	REC
		ARB	FP/LN	DES	FEE	



proposed air intake louvre for auditorium cooling


auditorium fire exit doors, retained as existing

existing a/c units


*to be changed*

**DELEGATED APPROVAL**  
- 4 AUG 2004


DRAWN BY	DRAWING	Job No	304	Rev.
CHECKED BY	Proposed rear elevation	Dwg. No		
REVISION BY	PROJECT Gate Cinema	DATE June 2004		
REVISION CHECKED BY	SCALE 1:100 at A3	DONOT SCALE THIS DRAWING. CHECK ALL DIMENSIONS ON SITE. IF IN DOUBT ASK. <small>All information contained in this drawing is sole copyright of Panter Hudspith Architects and is not to be reproduced without their permission.</small>		
		<p>PANTER HUDSPITH ARCHITECTS</p> <p>235, Southwark Bridge Road, London, SE1 6NP Telephone: 020 7407 2788 Fax: 020 7403 4176 www.panterhudspith.com Email: info@panterhudspith.com</p>		

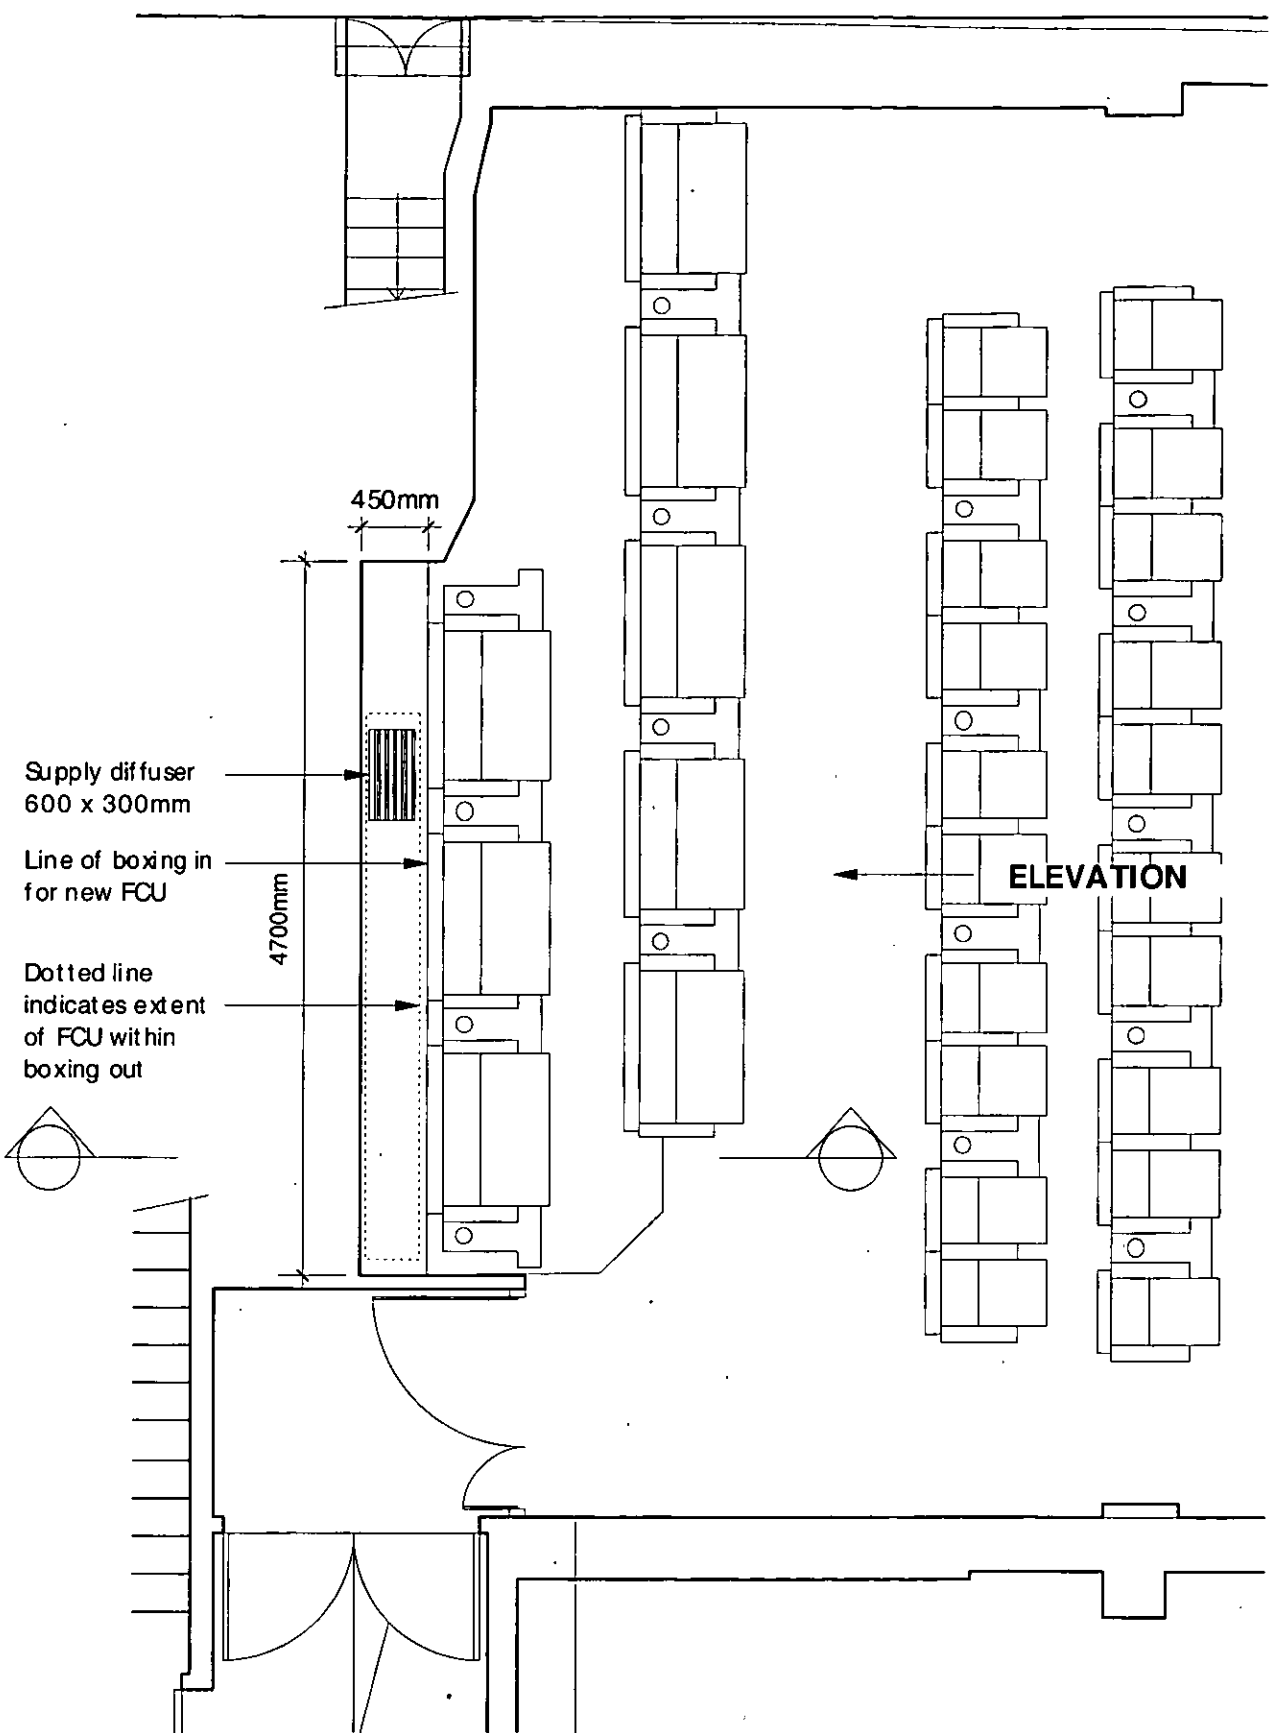

**PLAN SHOWING REVISED LOCATION OF FAN COIL UNIT**

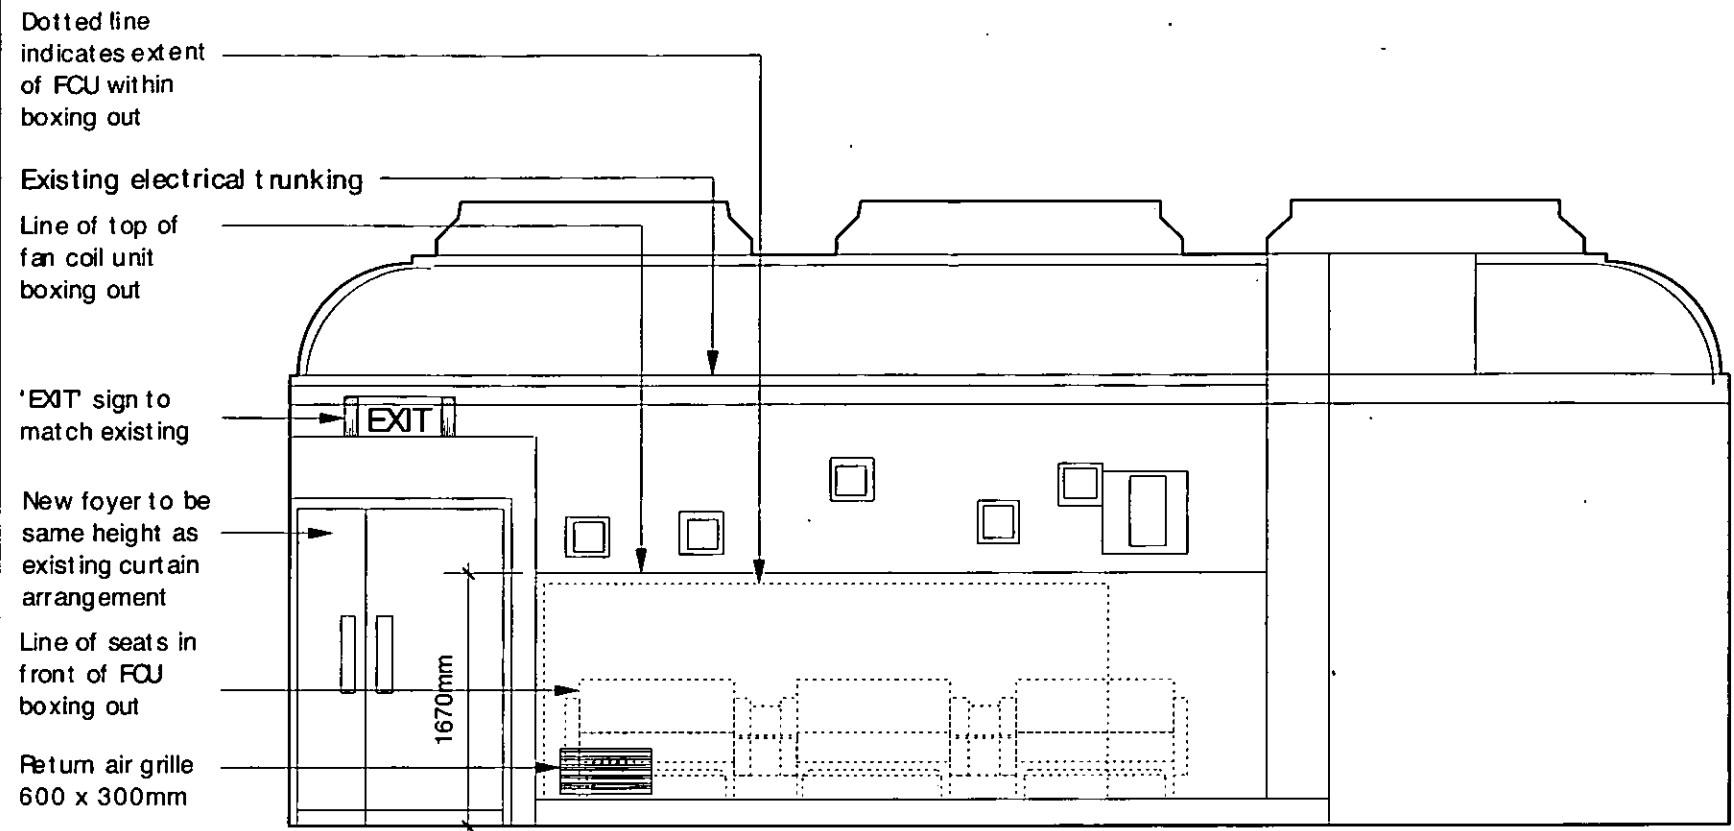

**ELEVATION SHOWING REVISED LOCATION OF NEW FCU**

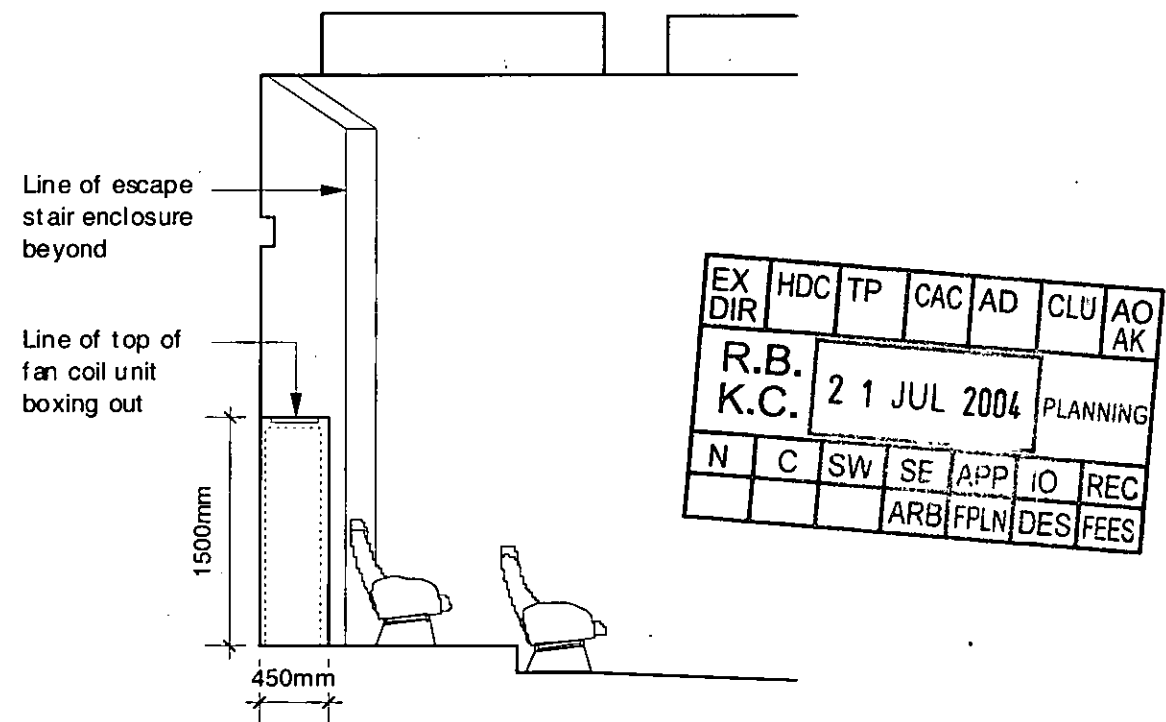

**SECTION SHOWING REVISED LOCATION OF NEW FCU**


EX DIR	HDC	TP	CAC	AD	CLU	AO
R.B.	K.C.	21 JUL 2004	PLANNING			
N	C	SW	SE	APP	IO	REC
			ARB	FPLN	DES	FEE

REVISION	DATE	DRAWN BY	JB	DRAWING	Revised FCU location in auditorium	Job No.	304
		CHECKED BY		PROJECT	Gate Cinema, Notting Hill	Dwg. No.	SK/09
		REVISION BY		SCALE	1:50 @ A3	DATE	19.07.04
		REVISION CHECKED BY		DO NOT SCALE THIS DRAWING. CHECK ALL DIMENSIONS ON SITE. IF IN DOUBT ASK. <small>All information contained in this drawing is the sole copyright of Panter Hudspith Architects and is not to be reproduced without their permission.</small>			


**PANTER HUDSPITH ARCHITECTS**

235, Southwark Bridge Road, London, SE1 6NP  
 Telephone: 020 7407 2786 Fax: 020 7403 4178  
 www.panterhudspith.com Email: info@panterhudspith.com




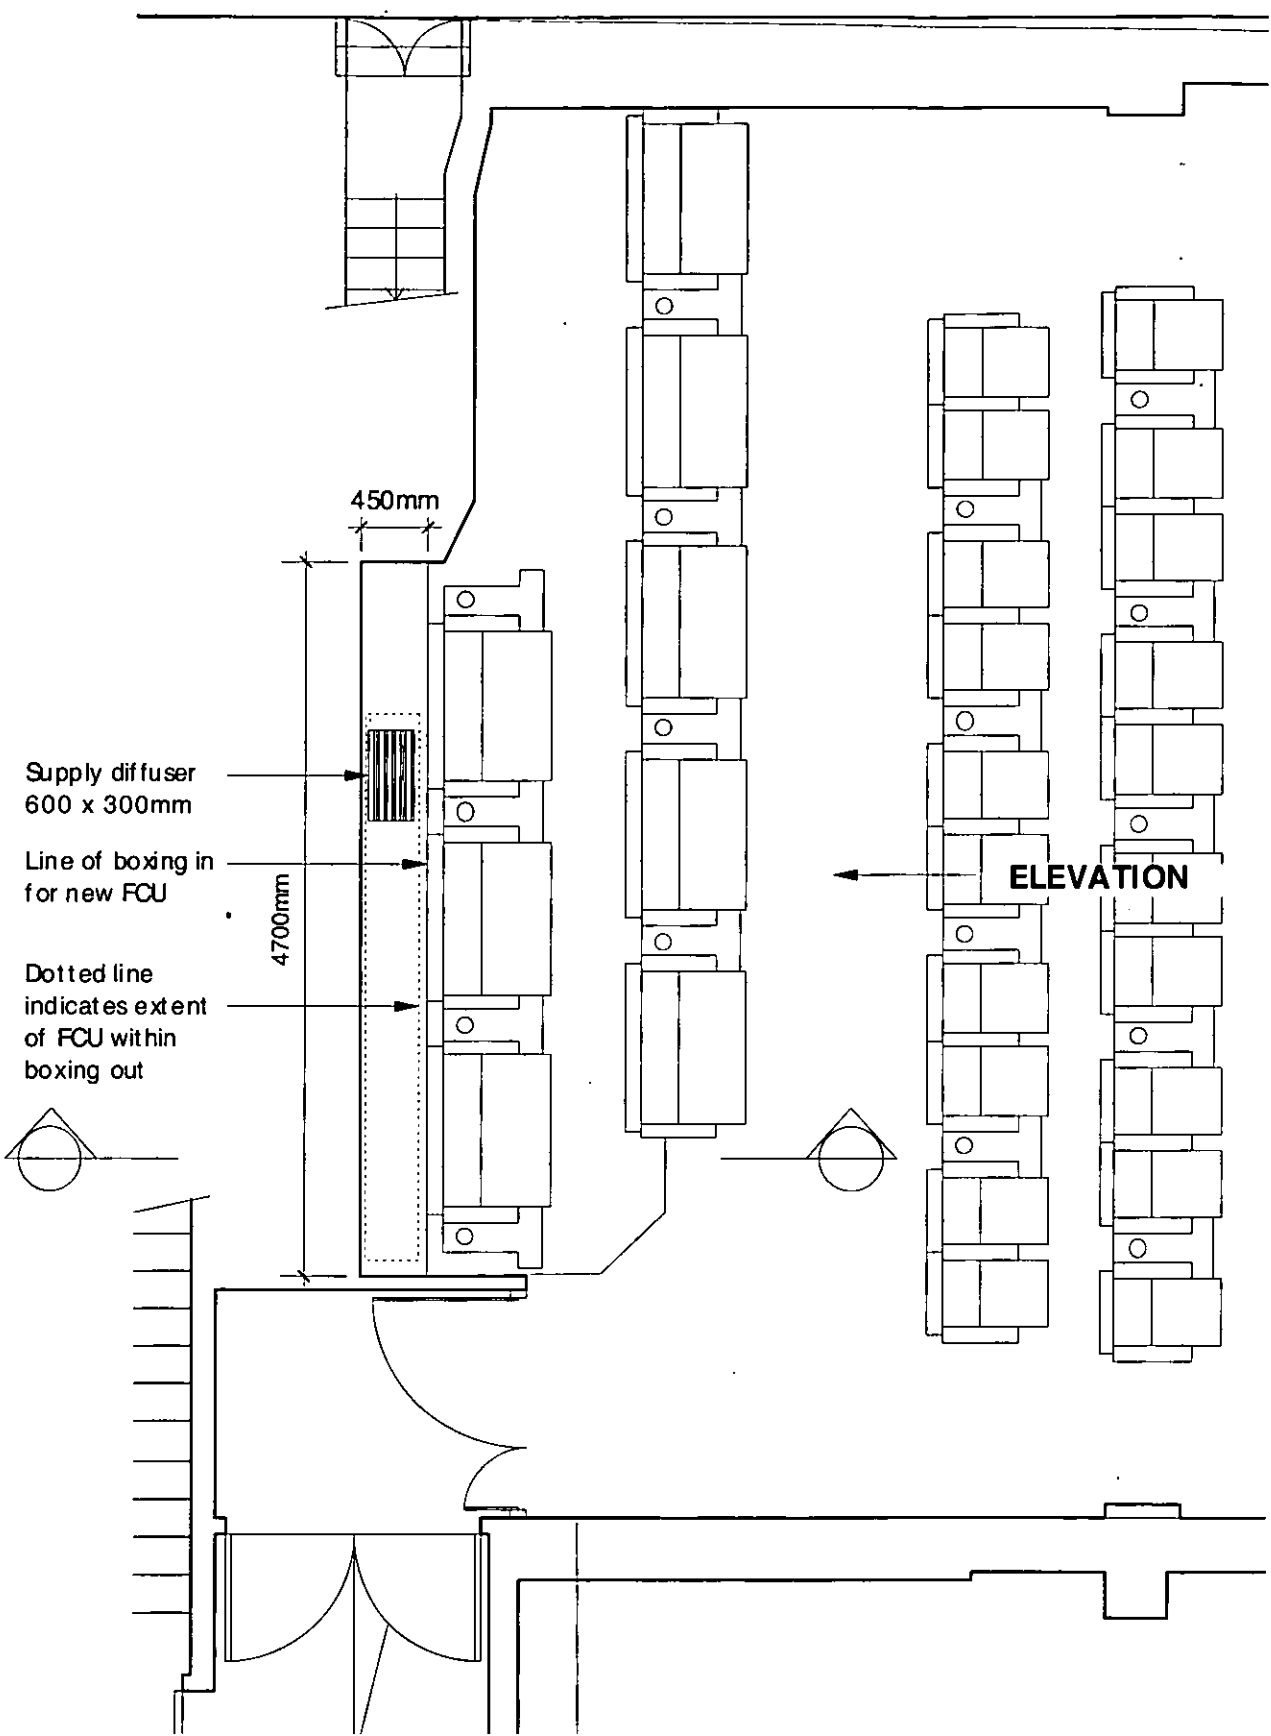

**PLAN SHOWING REVISED LOCATION OF FAN COIL UNIT**

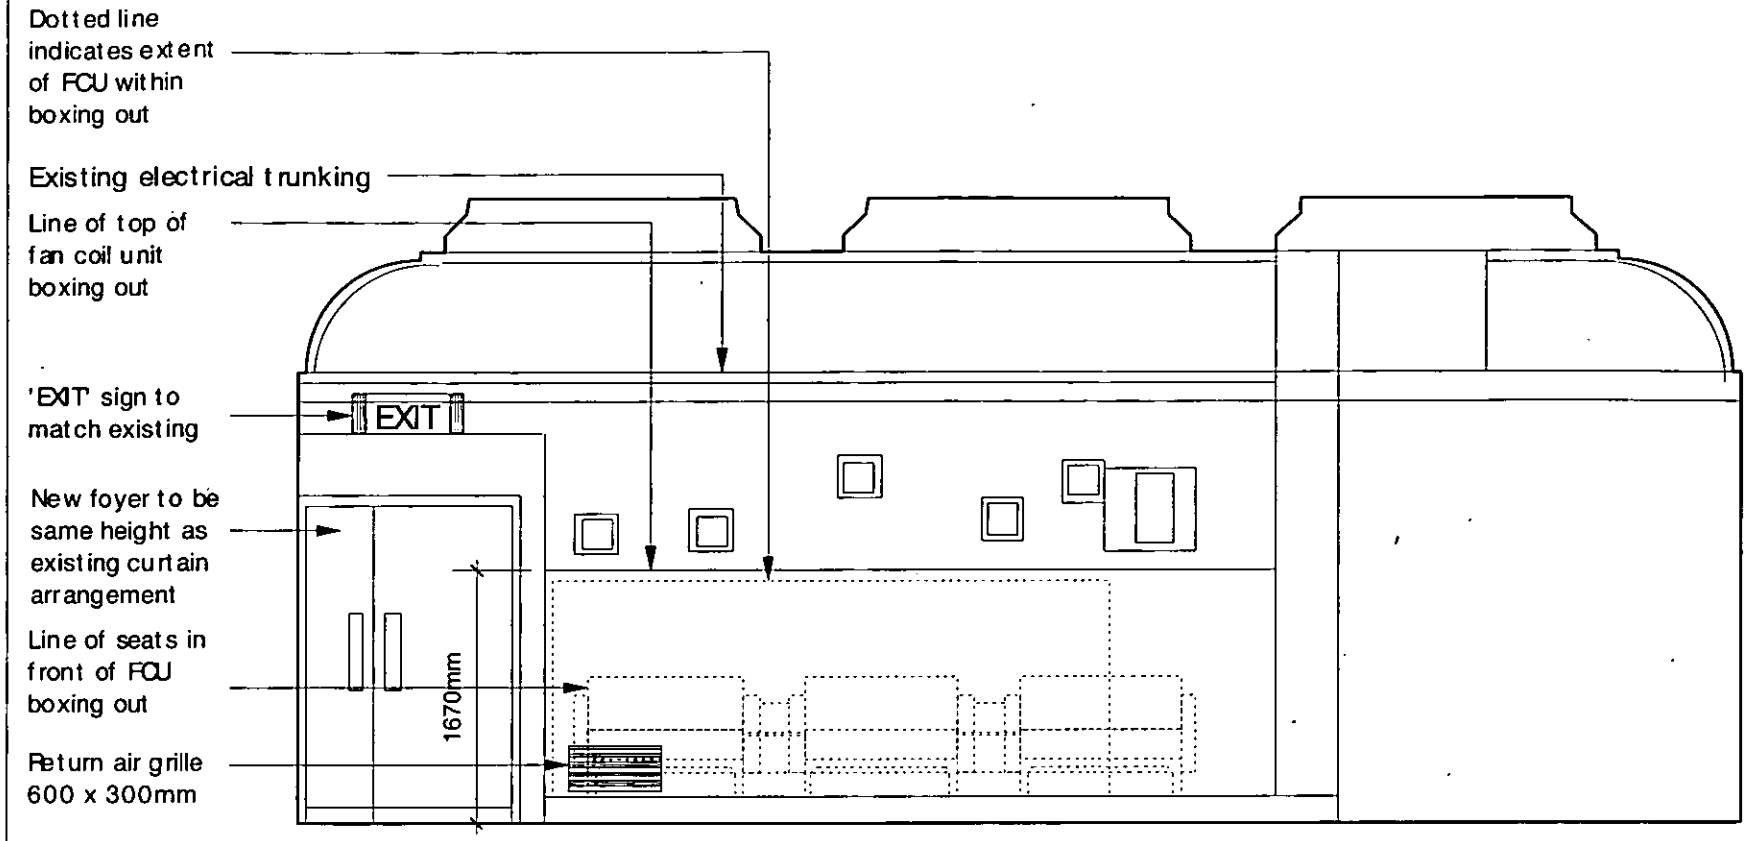

**ELEVATION SHOWING REVISED LOCATION OF NEW FCU**

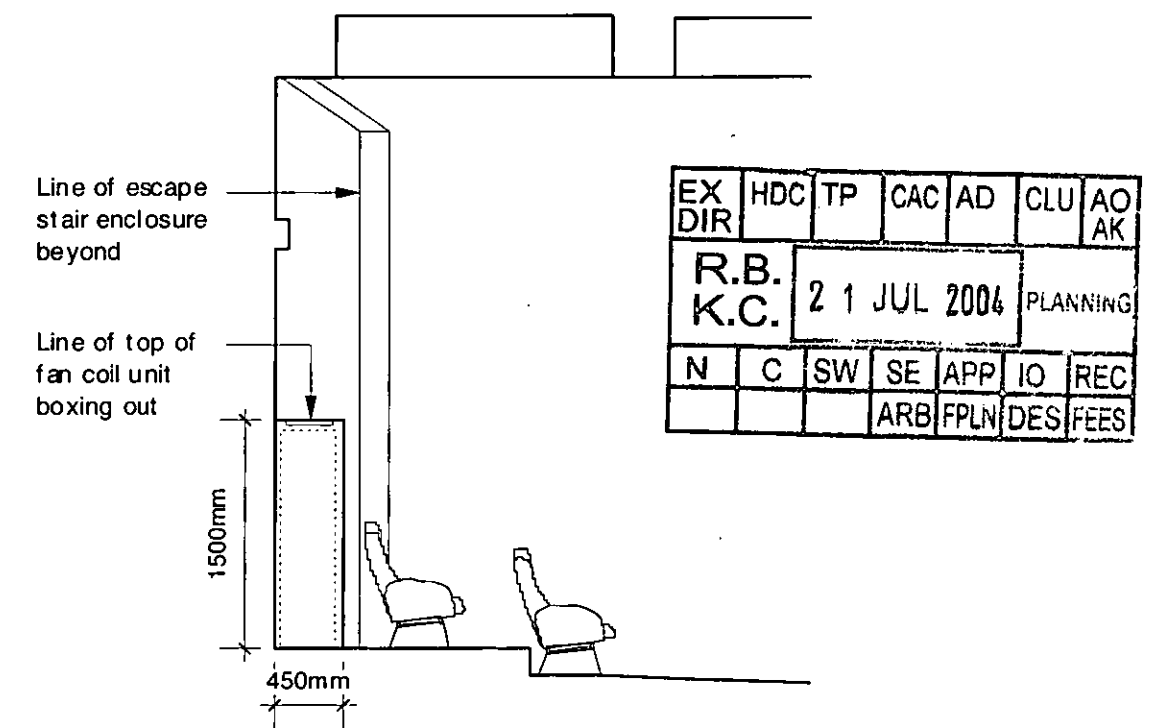


**SECTION SHOWING REVISED LOCATION OF NEW FCU**

REVISION	DATE	DRAWN BY	JB	DRAWING	Revised FCU location in auditorium	Jcb. No.	304	Rev.	PANTER HUDSPITH ARCHITECTS
		CHECKED BY		PROJECT	Gate Cinema, Notting Hill	Dwg. No.			
		REVISION BY		SCALE	1:50 @ A3	DATE	19.07.04		235, Southwark Bridge Road, London, SE1 6NP
		REVISION CHECKED BY		DO NOT SCALE THIS DRAWING. CHECK ALL DIMENSIONS ON SITE. IF IN DOUBT ASK. All information contained in this drawing is the sole copyright of Panter Hudspith Architects and is not to be reproduced without their permission.					Telephone: 020 7407 2786 Fax: 020 7403 4178 www.panterhudspith.com Email: info@panterhudspith.com



Existing air supply grille - all decorative plasterwork retained as existing

New partition wall to be constructed

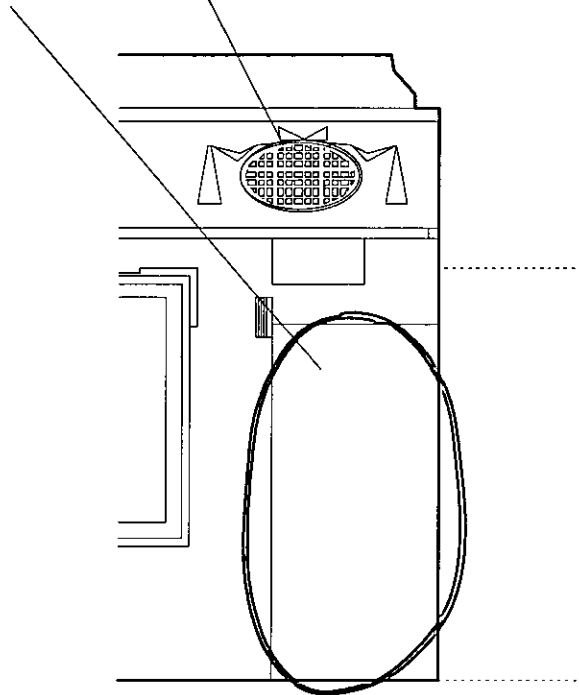

C/07 Elevation BB - Proposed  
B

New stud and plaster wall, no dado - to match rear wall

New cooling only unit distributes air evenly across back of seating area


Existing period Exit sign to be retained

New double doors to match existing

Existing projection ports

Existing escape stair from projection room

New twin seats separated by drinks shelf

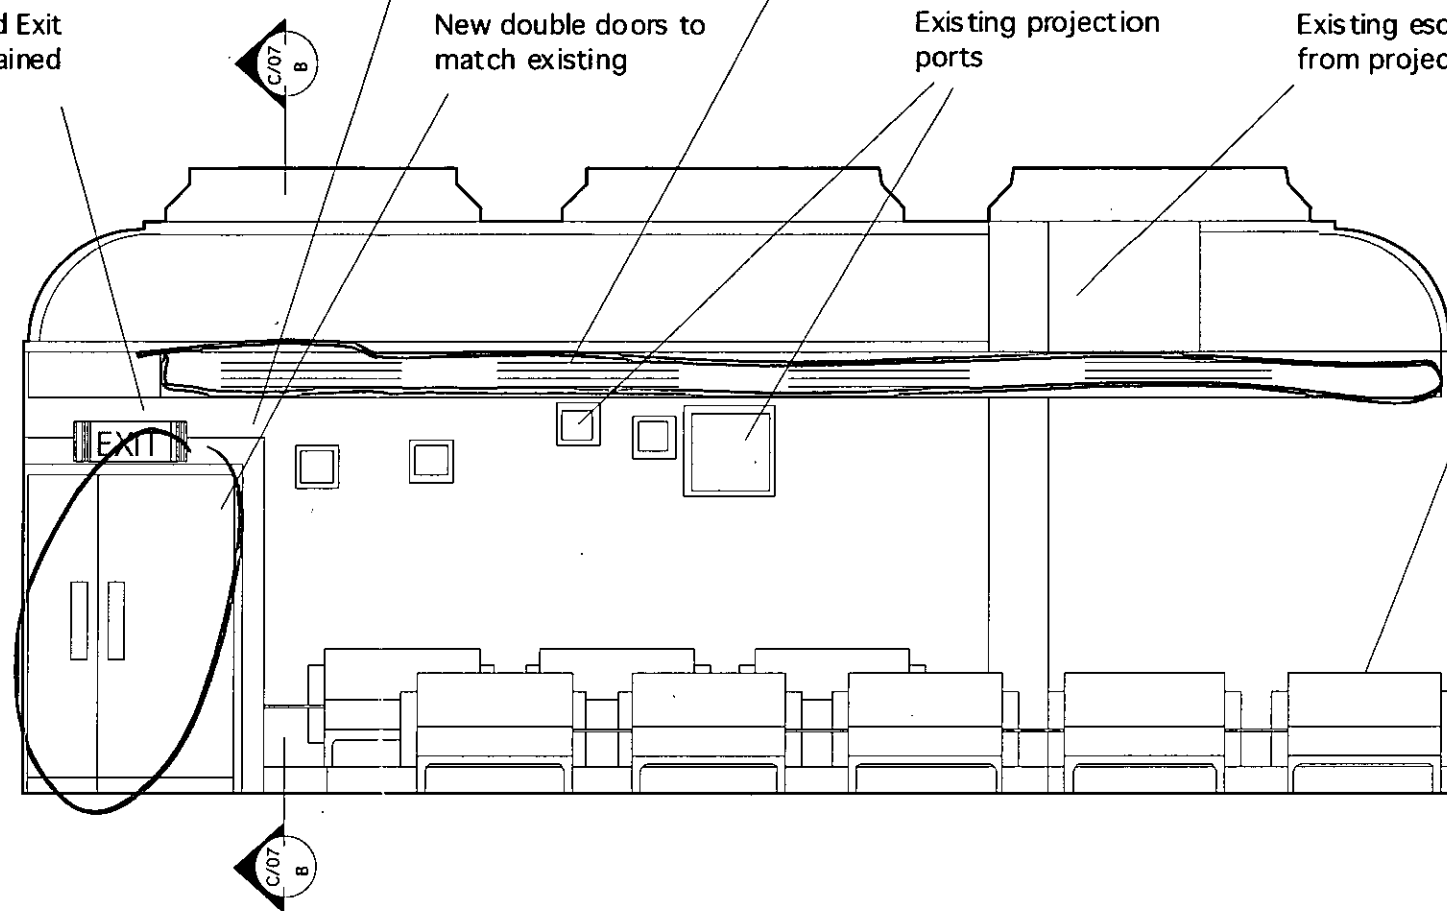

C/07 Elevation AA - Proposed  
A

EX DIR	HDC	TP	CAC	AD	CLU	A
R.B.	K.C.	03 JUN 2004	PLANNING			
N	C	SW	SE	APP	IO	REC
		ARB	FPLN	DES	FEE	

REVISION	DATE	DRAWN BY	DRAWING	Job No.
			Auditorium entrance and rear wall Proposed	304
		CHECKED BY	PROJECT Gate Cinema, Notting Hill	Rev. <input type="checkbox"/>
		REVISION BY	SCALE 1:50 at A3 DATE May 2004	Dwg. No. C/07
		REVISION CHECKED BY	DO NOT SCALE THIS DRAWING. CHECK ALL DIMENSIONS ON SITE. IF IN DOUBT ASK. <small>All information contained in this drawing is sole copy right of Panter Hudspith Architects and is not to be reproduced without their permission.</small>	


**PANTER HUDSPITH ARCHITECTS**

235, Southwark Bridge Road, London, SE1 6NP  
 Telephone: 020 7407 2788 Fax: 020 7403 4178  
 www.panterhudspith.com Email: info@panterhudspith.com



Existing air supply grille - all decorative plasterwork retained as existing

New partition wall to be constructed

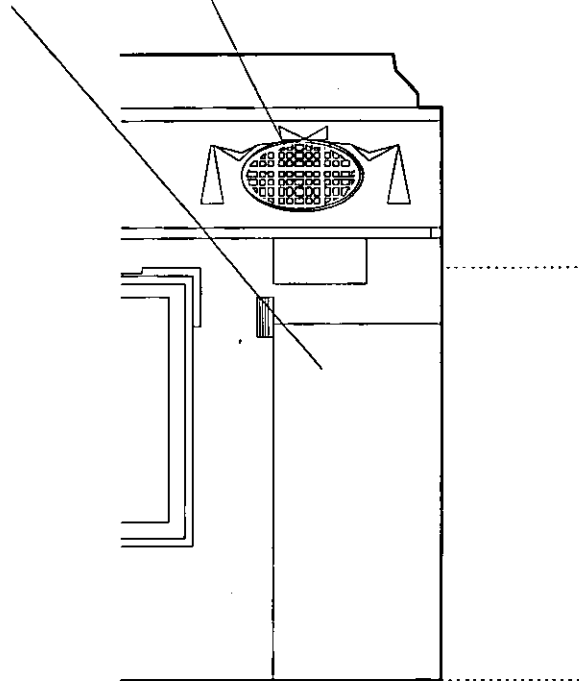

C/07  
B  
Elevation BB - Proposed

New stud and plaster wall, no dado - to match rear wall

New cooling only unit distributes air evenly across back of seating area


Existing period Exit sign to be retained

New double doors to match existing

Existing projection ports

Existing escape stair from projection room

New twin seats separated by drinks shelf

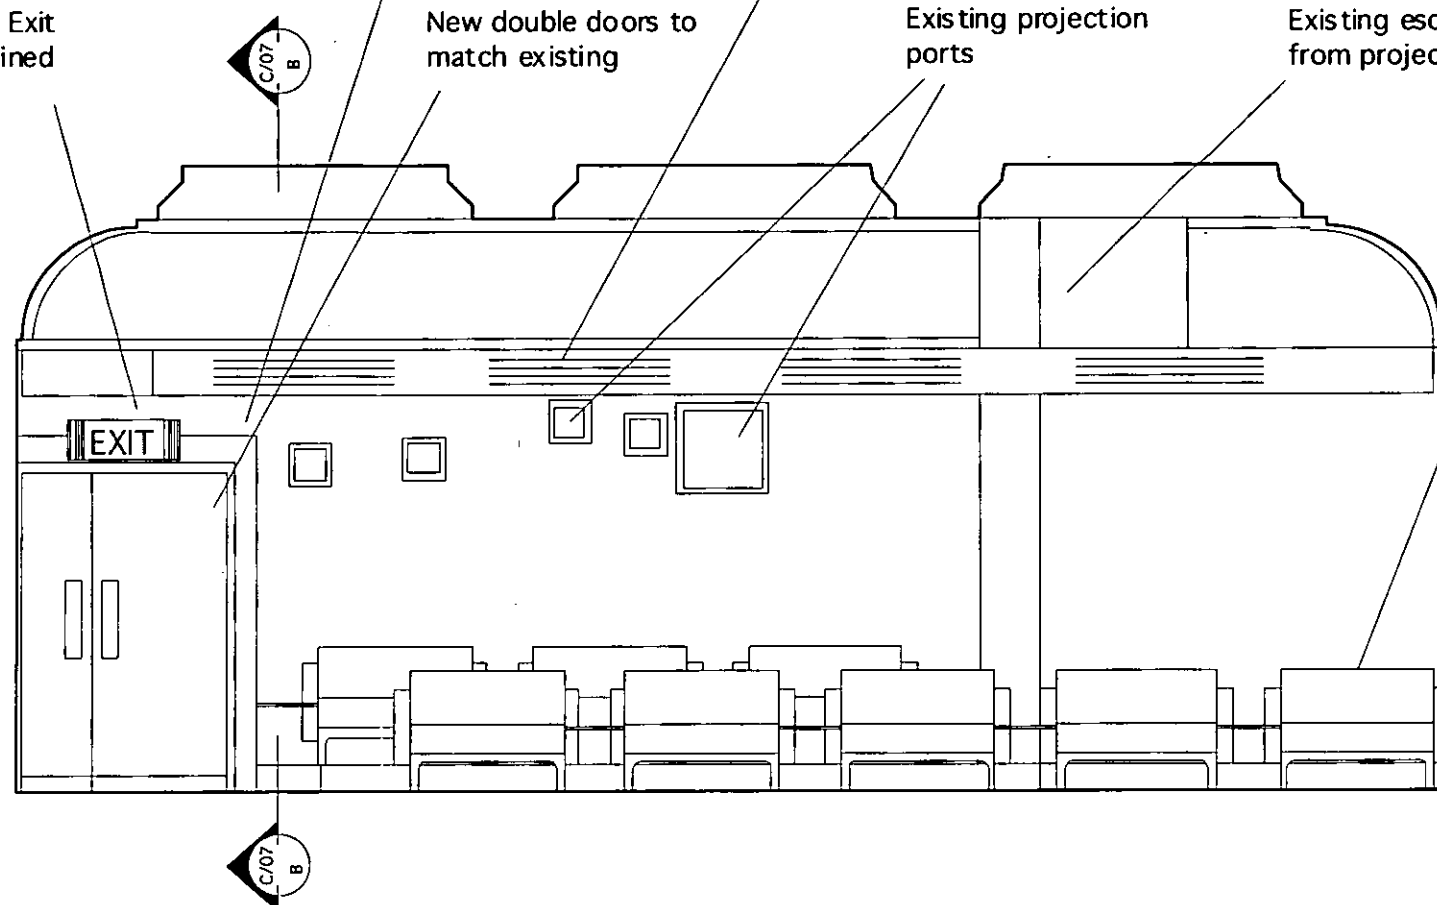

C/07  
A  
Elevation AA - Proposed

EX DIR	HDC	TP	CAC	AD	CLU	A
R.B.	03 JUN 2004				PLANNING	
K.C.						
N	C	SW	SE	APP	IO	REC
			ARB	FPLN	DES	FEE

REVISION	DATE	DRAWN BY	DRAWING	Job No.
		CHECKED BY	Auditorium entrance and rear wall Proposed	304
		REVISION BY	PROJECT Gate Cinema, Notting Hill	C/07
		REVISION CHECKED BY	SCALE 1:50 at A3 DATE May 2004	
			DO NOT SCALE THIS DRAWING. CHECK ALL DIMENSIONS ON SITE. IF IN DOUBT ASK.	
			<small>All information contained in this drawing is a sole copy right of Panter Hudspith Architects and is not to be reproduced without their permission.</small>	


**PANTER HUDSPITH ARCHITECTS**

235, Southwark Bridge Road, London, SE1 6NP  
 Telephone: 020 7407 2786 Fax: 020 7403 4176  
 www.panterhudspith.com Email: info@panterhudspith.com

RB041269




EX DIR	HDC	TP	CAC	AD	CLU	AO AK
R.B.	K.C.	09 JUN 2004	PLANNING			
N	C	SW	SE	APP	IO	REC
			ARB	FPLN	DES	FEE

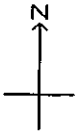

# Siteplan Data™



Produced 08 Jan 2004 from Ordnance Survey digital data and incorporating surveyed revision available at this date. © Crown Copyright 2004.

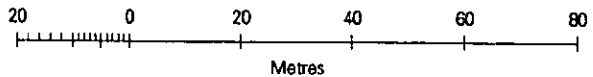

Reproduction in whole or in part is prohibited without the prior permission of Ordnance Survey.

Ordnance Survey and the OS symbol are registered trade marks and Siteplan a trade mark of Ordnance Survey, the national mapping agency of Great Britain.

Centre Coordinates: 525170 180395

National Grid sheet reference at centre of this Siteplan: TQ2580SW

Supplied by: Stanfords  
Serial Number: 00012046



As built location of supply louvre


auditorium fire exit doors, retained as existing

existing a/c units

EX DIR	HDC	TP	CAC	AD	CLU	AO AK
R.B.		16 SEP 2004			PLANNING	
N	C	SW	SE	APP	IO	REC
HBS			ARB	FPLN	DES	FEE

Rev.A - Location of supply louvre amended

DRAWN BY	DRAWING	Job No.	304 C/09	Rev. A
CHECKED BY	Proposed rear elevation			
REVISION BY	PROJECT Gate Cinema	DATE June 2004		
REVISION CHECKED BY	SCALE 1:100 at A3			
<small>DO NOT SCALE THIS DRAWING. CHECK ALL DIMENSIONS ON SITE. IF IN DOUBT ASK.          All information contained in this drawing is the sole copyright of Panter Hudspith Architects and is not to be reproduced without their permission.</small>				



**PANTER HUDSPITH ARCHITECTS**  
 235, Southwark Bridge Road, London, SE1 8NP  
 Telephone: 020 7407 2788 Fax: 020 7403 4178  
 www.panterhudspith.com Email: info@panterhudspith.com