

TP99/745 (1)

1:1	0	10mm	20	30	40	50	60	70	80	90	100	110
1:100	0	1m	2	3	4	5	6	7	8	9	10	11
1:5	0	100mm	200	300	400	500	600	700	800	900	1000	1100
1:50	0	1m	2	3	4	5	6	7	8	9	10	11
1:20	0	200mm	400	600	800	1000	1200	1400	1600	1800	2000	2200
1:200	0	2m	4	6	8	10	12	14	16	18	20	22
1:1250	0	10m	20	30	40	50	60	70	80	90	100	110
1:2500	0	20m	40	60	80	100	120	140	160	180	200	220


NOTES
THIS DRAWING IS THE PROPERTY OF ATTWOOD ASSOCIATES. IT IS NOT TO BE REPRODUCED, COPIED, EITHER WHOLLY OR IN PART, WITHOUT THE WRITTEN PERMISSION OF ATTWOOD ASSOCIATES. ANY REPRODUCTION OF THIS DRAWING IS AT THE USER'S RISK. THE USER SHALL BE RESPONSIBLE FOR CHECKING ALL DIMENSIONS AND ALL DIMENSIONS SHOULD BE CHECKED ON SITE.
REVISION NOTES
A - AUG 99 - AS BUILT DRAWING




204 TREBOVIR RD ELEVATION AA

EXISTING FIRE DOOR TO REMAIN  
NEW WAREHOUSE STYLE TIMBER WINDOWS WITH SAFTY GLAZING PAINTED YELLOW, DULUX (0010 Y20R)



- MOTIF- FRET CUT ACRYLIC COLOUR YELLOW
- NEW SIGNAGE BUILT UP ACRYLIC LETTERS INTERNALLY ILLUMINATED WITH RED NEON.
- EXISTING LEAD FLASHING TO BE DRESSED OVER CORNICE
- NEW CORNICE DETAIL
- NEW TIMBER FACIA PAINTED GREEN DELUX (1116 Y18R)
- NEW GLAZED TRANSOM PANEL
- NEW TIMBER PILASTER WITH FLUTING, CAPITAL & CORBEL DETAILS PAINTED YELLOW, DULUX(0010 Y20R)
- NEW SAFTY GLAZING(BS 0026) WITH TIMBER FRAMING PAINTED GREEN, DULUX (1116 Y18R)
- NEW TIMBER STALL RISER PAINTED GREEN.
- EXISTING STONE PILASTER

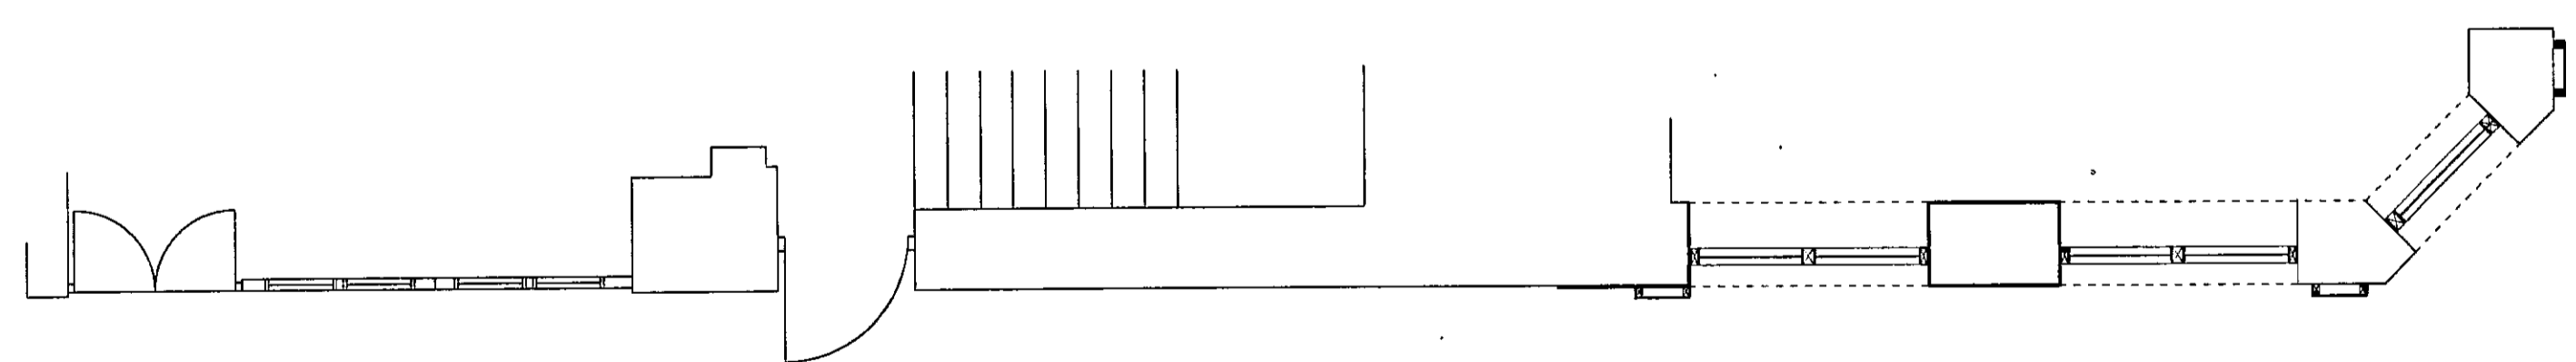


204 TREBOVIR RD PLAN AA

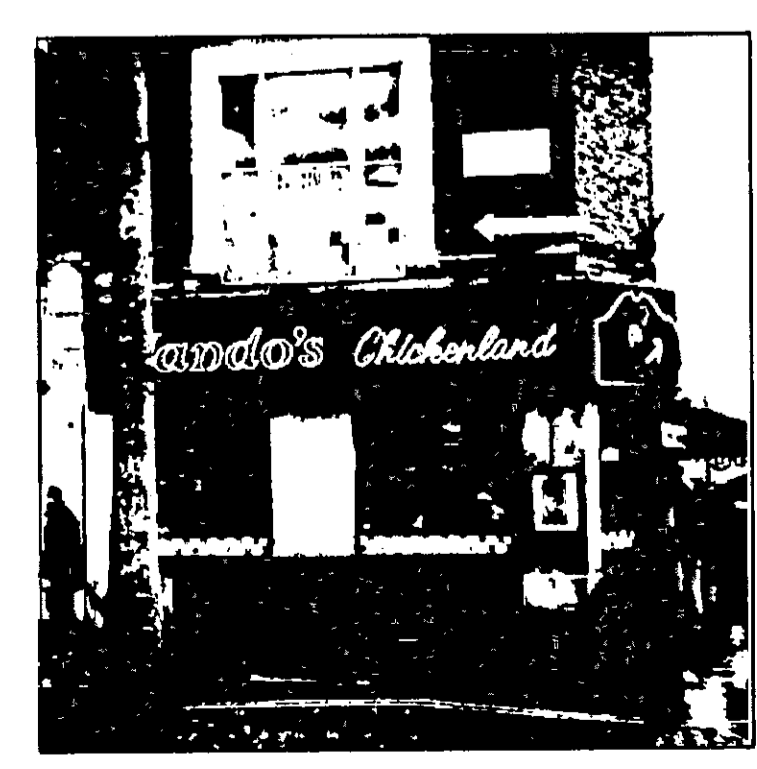


EXISTING SHOPFRONT ELEVATIONS

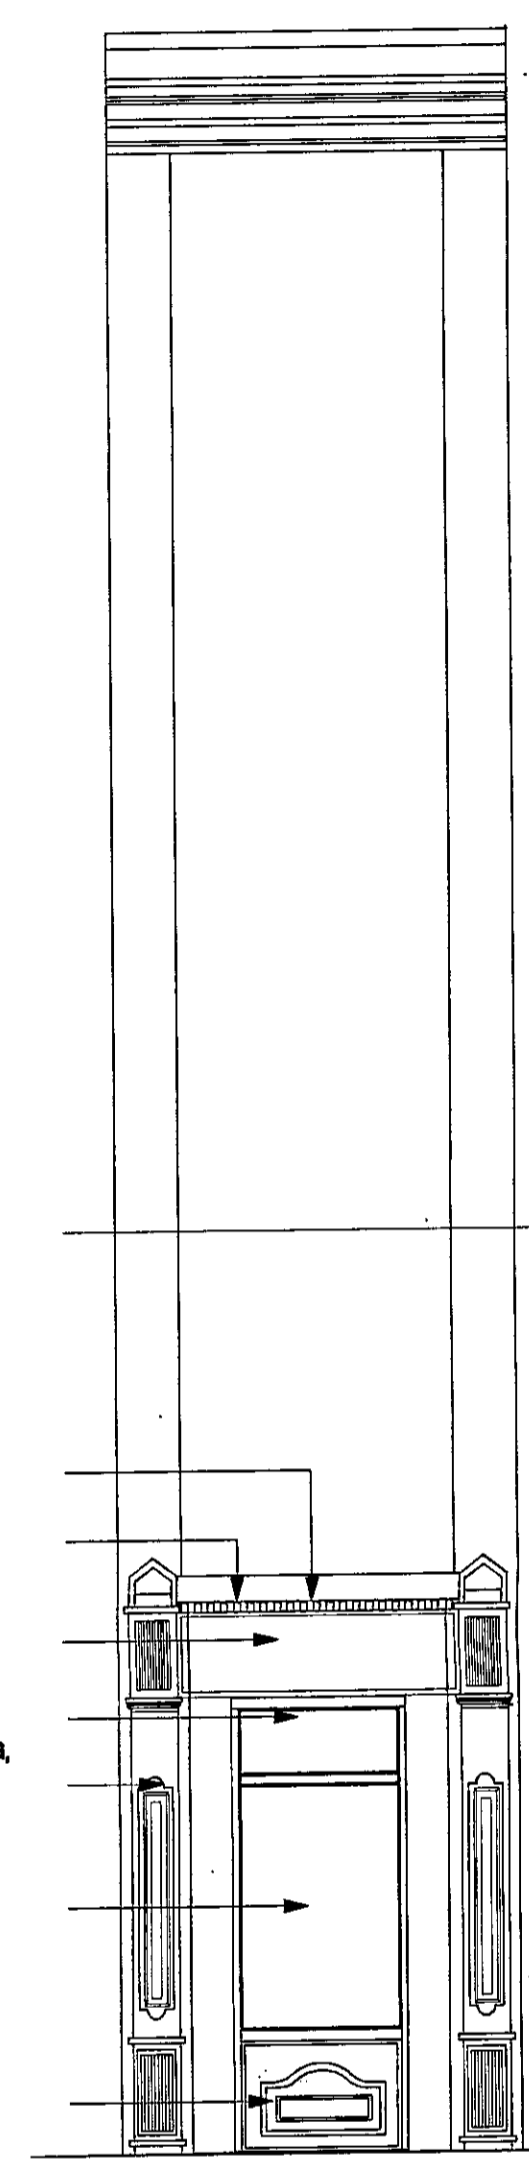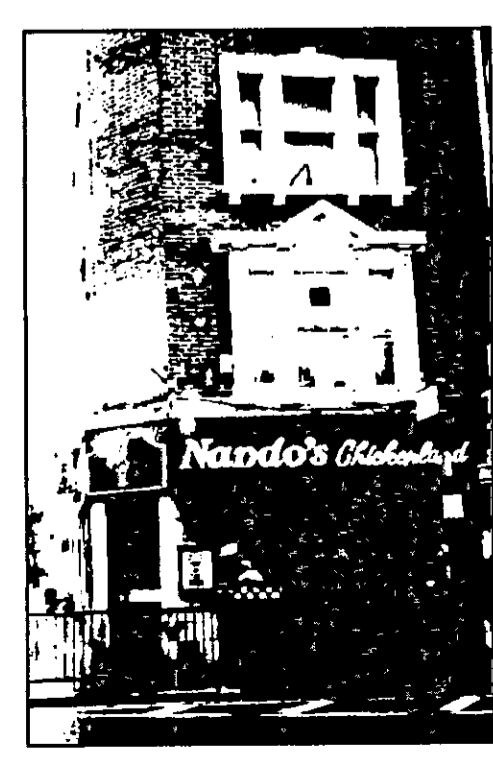

CORNER ELEVATION BB

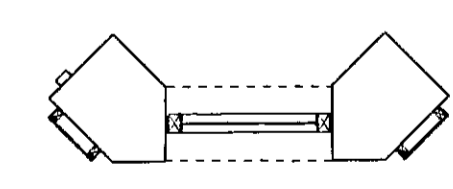


CORNER PLAN BB

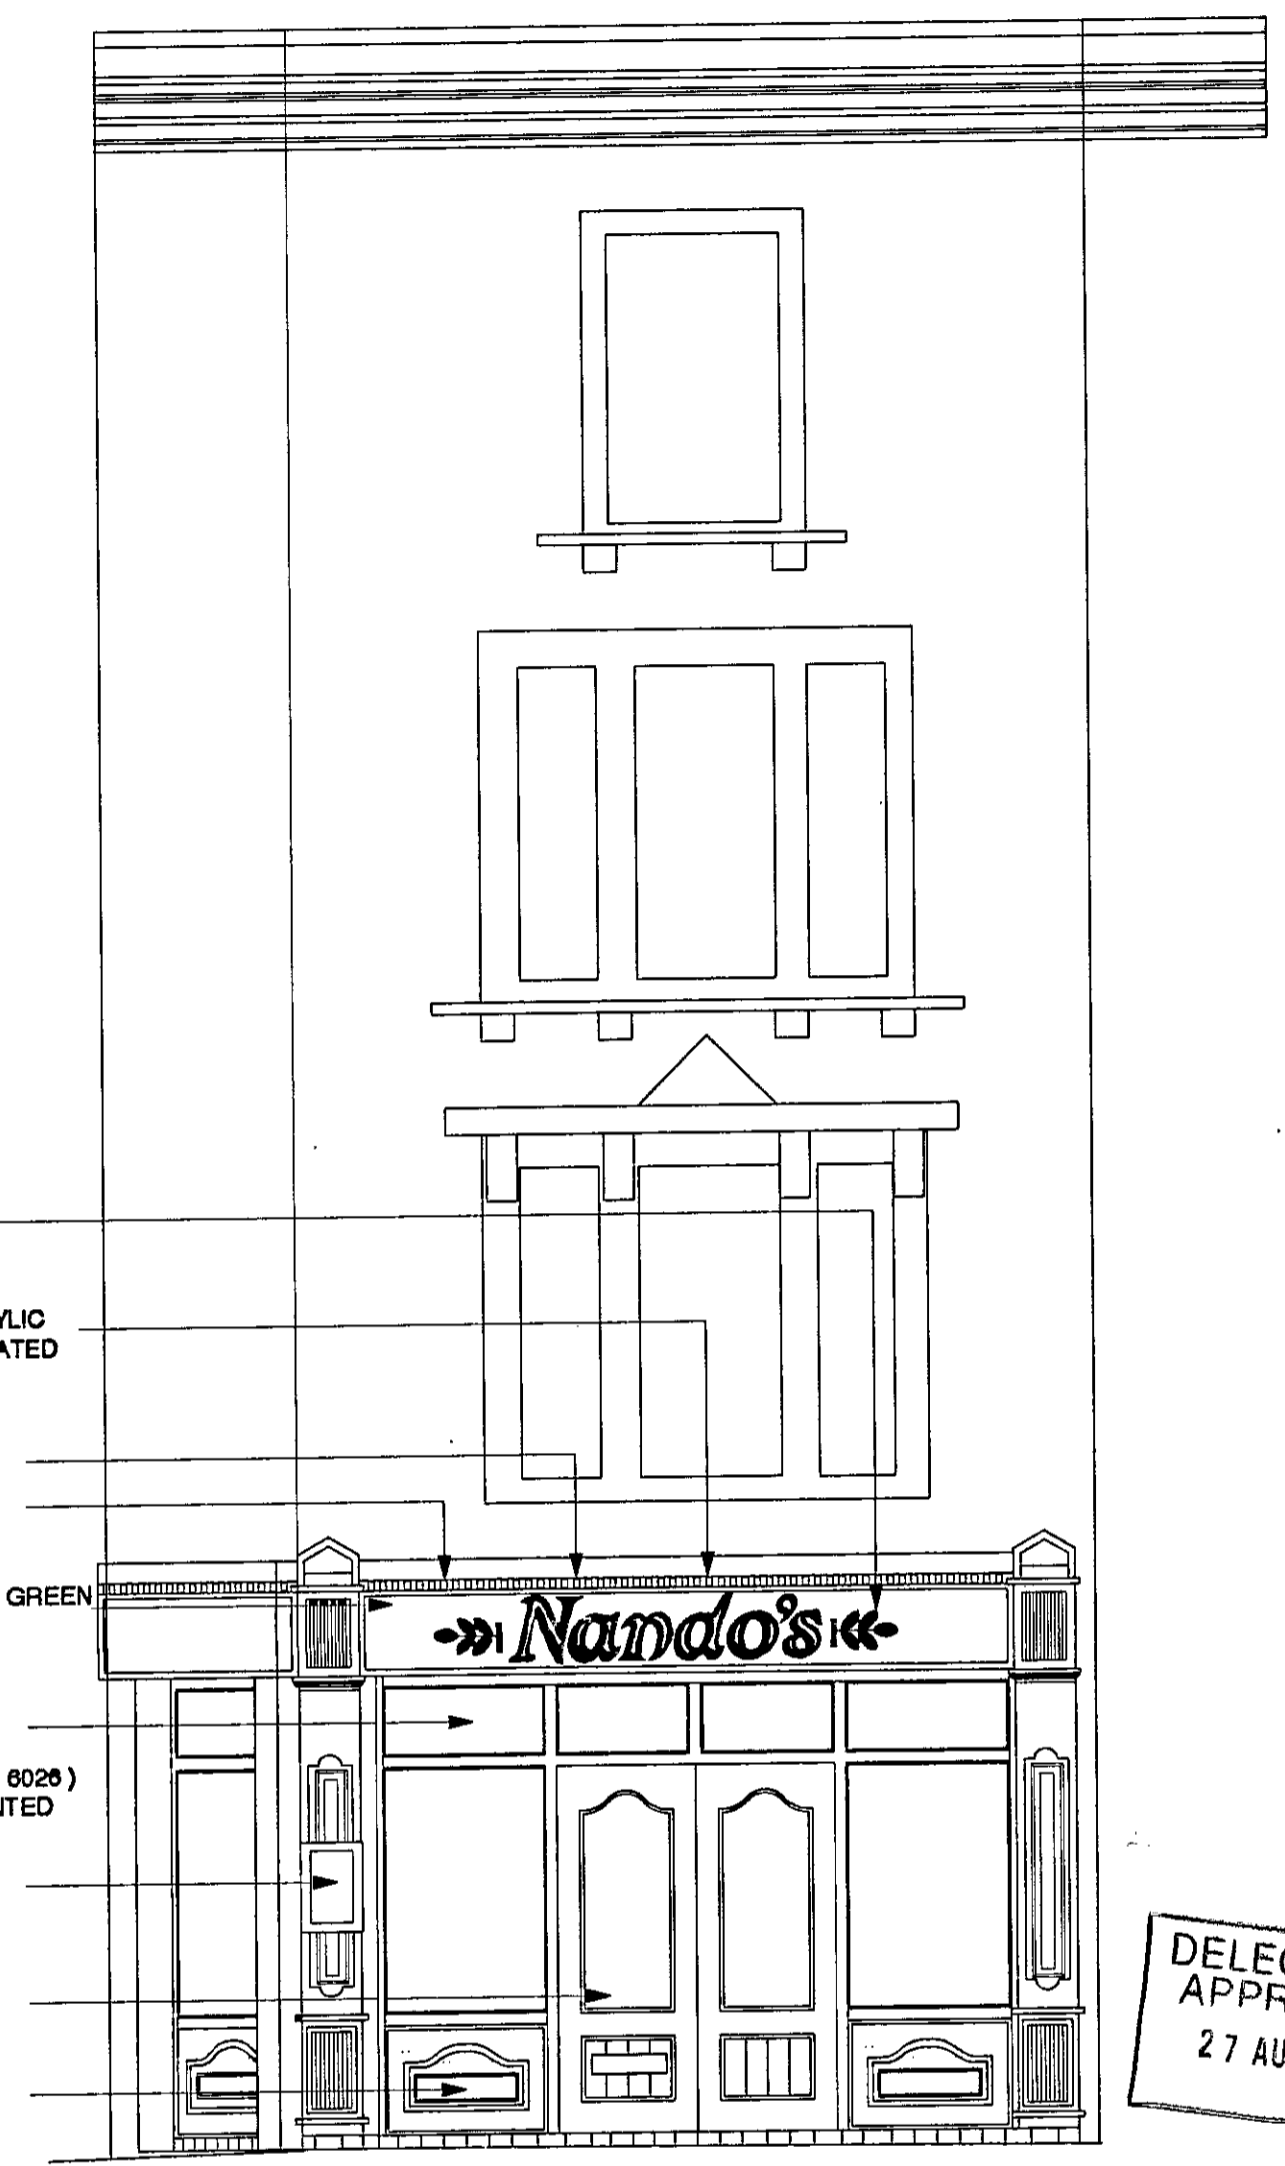


EARL'S COURT RD ELEVATION CC

- NEW SIGNAGE BUILT UP ACRYLIC LETTERS INTERNALLY ILLUMINATED WITH RED NEON.
- EXISTING LEAD FLASHING TO BE DRESSED OVER CORNICE
- NEW CORNICE DETAIL
- NEW TIMBER FACIA PAINTED GREEN DELUX (1116 Y18R)
- NEW TRANSOM LIGHT
- NEW SAFTY GLAZING (BS 0026) WITH TIMBER FRAMING PAINTED GREEN, DULUX (1116 Y18R)
- NEW MENU BOARD
- NEW TIMBER DOORS
- NEW TIMBER STALL RISER PAINTED GREEN. DULUX (1116 Y18R)

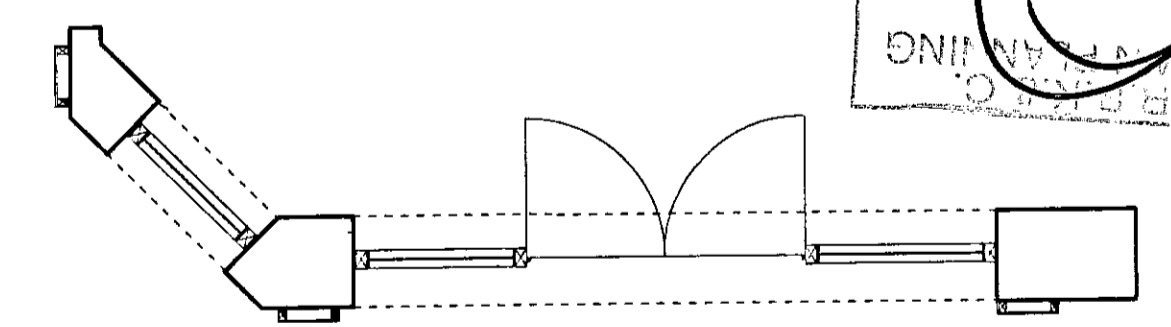


EARL'S COURT RD PLAN CC

DELEGATED APPROVAL  
27 AUG 1999

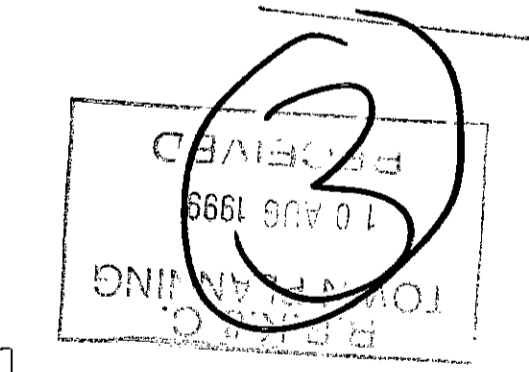

PP990745/c

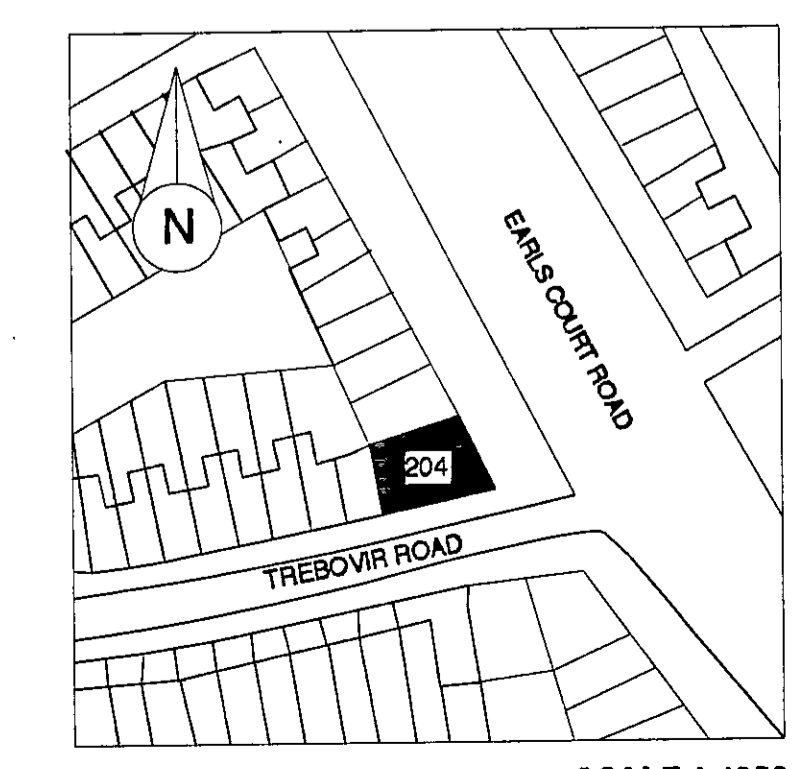

LOCATION PLAN SCALE 1:1250

ATTWOOD ASSOCIATES	
ENTERPRISE HOUSE, BEEBROOK LANE, BUCKINGHAM, HERTS, UK. TEL: 01295 711882 FAX: 01295 774011	
CLIENT	NANDOS
PROJECT	204 EARL'S COURT ROAD LONDON SW
TITLE	PROPOSED SHOPFRONT LAYOUT.
DRAWING NO.	1206/07
REVISION	B
SCALE	1:50
DRAWN BY	CWP
DATE	AUG 99

TP/99/745 (2)

**NOTE**  
 THIS DRAWING IS THE PROPERTY OF ATWOOD KING ASSOCIATES  
 COPYRIGHT IS RESERVED BY THEM AND THE DRAWING IS LOANED ON  
 THE CONDITION THAT IT IS NOT COPIED, REPRODUCED, EITHER WHOLLY OR  
 PARTIALLY, WITHOUT PERMISSION IN WRITING FROM ATWOOD KING  
 ASSOCIATES. THIS DRAWING SHOULD ONLY BE USED FOR THE PURPOSES  
 INTENDED.  
 SOURCE SCALE FROM THIS DRAWING AND ALL DIMENSIONS SHOULD BE  
 CHECKED ON SITE.

**REVISION NOTES**



2

DELEGATED  
 APPROVAL  
 27 AUG 1999



R.B.K. & C  
 TOWN PLANNING  
 17 AUG 1999  
 RECEIVED

1:1	0	10mm	20	30	40	50	60	70	80	90	100	110			
1:100	0	1m	2	3	4	5	6	7	8	9	10	11			
1:5	0	100mm	200	300	400	500									
1:50	0	1m	2	3	4	5									
1:20	0	200mm	400	600	800	1000	1200	1400	1600	1800	2000	2200			
1:200	0	2m	4	6	8	10	12	14	16	18	20	22			
1:1250	0	10m	20	30	40	50	60	70	80	90	100	110	120	130	140
1:2500	0	20m	40	60	80	100	120	140	160	180	200	220	240	260	280

**PRELIMINARY**

<b>KING ASSOCIATES</b>	
ENTERPRISE HOUSE BEECHAM ROAD BURY LANE FRODOBUSHGATE HERTFORDSHIRE SG8 2BE TEL: 01297 11811 FAX: 01297 77011	
CLIENT	NANDOS
PROJECT	204 EARLS COURT ROAD LONDON SW8 9QF
TITLE	Existing shopfront
DRAWING NO.	1059/02
REVISION	
SCALE	1:50
DRAWN BY	TM
DATE	DEC 98

THIS DRAWING IS THE PROPERTY OF ATTWOOD KING ASSOCIATES  
 IT IS NOT TO BE REPRODUCED OR COPIED IN ANY MANNER  
 WITHOUT THE WRITTEN CONSENT OF ATTWOOD KING ASSOCIATES  
 THIS DRAWING SHOULD ONLY BE USED FOR THE PURPOSES  
 STATED ON THE DRAWING AND ALL DIMENSIONS SHOULD BE  
 CHECKED ON SITE.

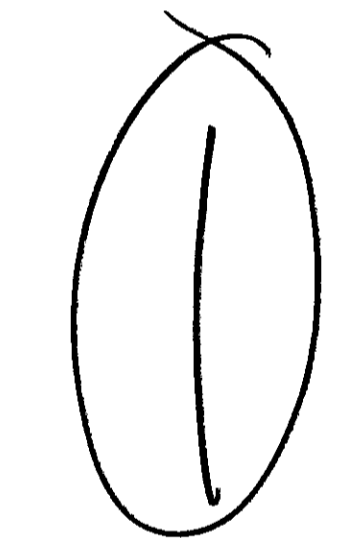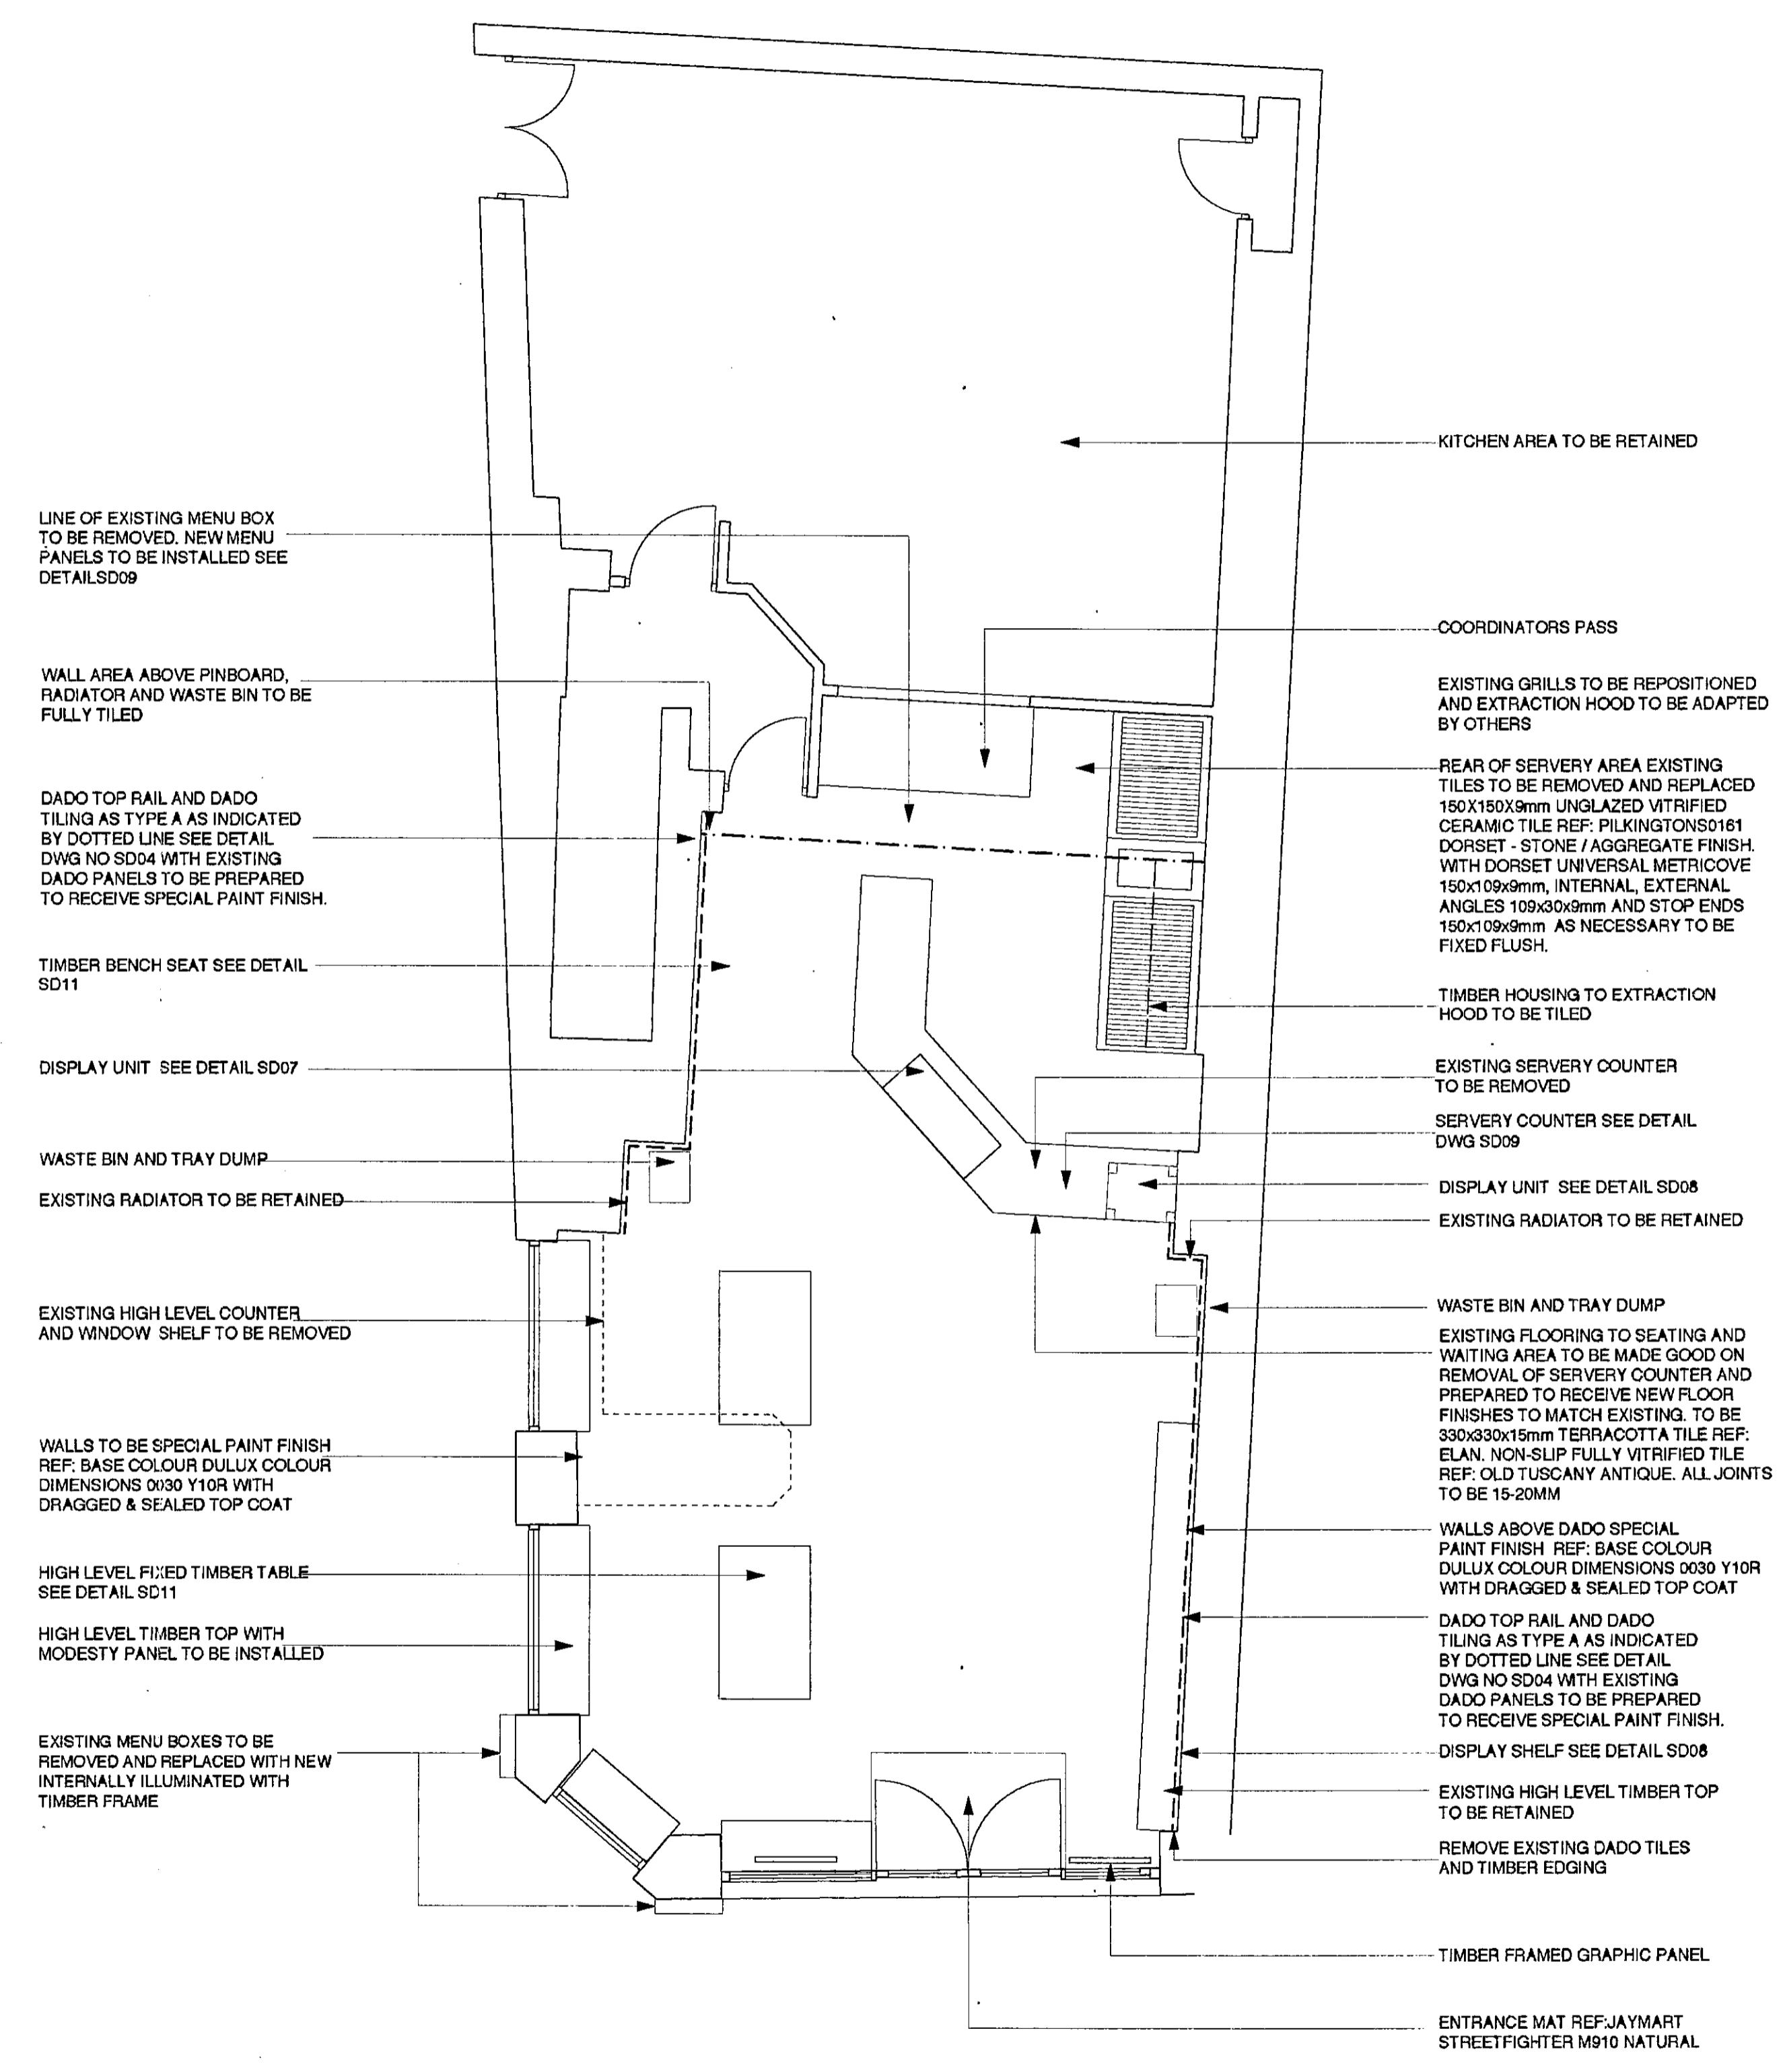

DELEGATED APPROVAL  
 27 AUG 1999

TOWN PLANNING RECEIVED  
 12 APR 1999

1:1	0	10mm	20	30	40	50	60	70	80	90	100	110
1:100	0	1m	2	3	4	5	6	7	8	9	10	11
1:5	0	100mm	200	300	400	500						
1:50	0	1m	2	3	4	5						
1:20	0	200mm	400	600	800	1000	1200	1400	1600	1800	2000	2200
1:200	0	2m	4	6	8	10	12	14	16	18	20	22
1:1250	0	10m	20	30	40	50	60	70	80	90	100	110
1:2500	0	20m	40	60	80	100	120	140	160	180	200	220

PP990745


PP990745

**ATTWOOD KING ASSOCIATES**  
 ENTERPRISE HOUSE, 88/90 SOUTH BRIDGE ROAD, SINGAPORE 059108  
 TEL: 6342 7118 FAX: 6342 7401

CLIENT: **NANDOS**  
 PROJECT: **EARLS COURT**  
 TITLE: **PLAN LAYOUT**  
 DRAWING NO: **1059/01**  
 SCALE: **1:50**  
 DATE: **SC**  
 DRAWN BY: **SC**  
 DATE: **DEC 98**


TP99/745 (4)

NOTES
<small>THIS DRAWING IS THE PROPERTY OF ATTWOOD ASSOCIATES. IT IS TO BE USED ONLY FOR THE PROJECT AND SITE SPECIFICALLY IDENTIFIED ON THE DRAWING. IT IS NOT TO BE REPRODUCED, COPIED, EITHER WHOLLY OR IN PART, WITHOUT CONSENT IN WRITING FROM ATTWOOD ASSOCIATES. THE DRAWING SHOULD ONLY BE USED FOR THE PURPOSE INTENDED. SCALE FROM THIS DRAWING AND ALL DIMENSIONS SHOULD BE CHECKED ON SITE.</small>
REVISION NOTES
A - AUG 98 - AS BUILT DRAWING

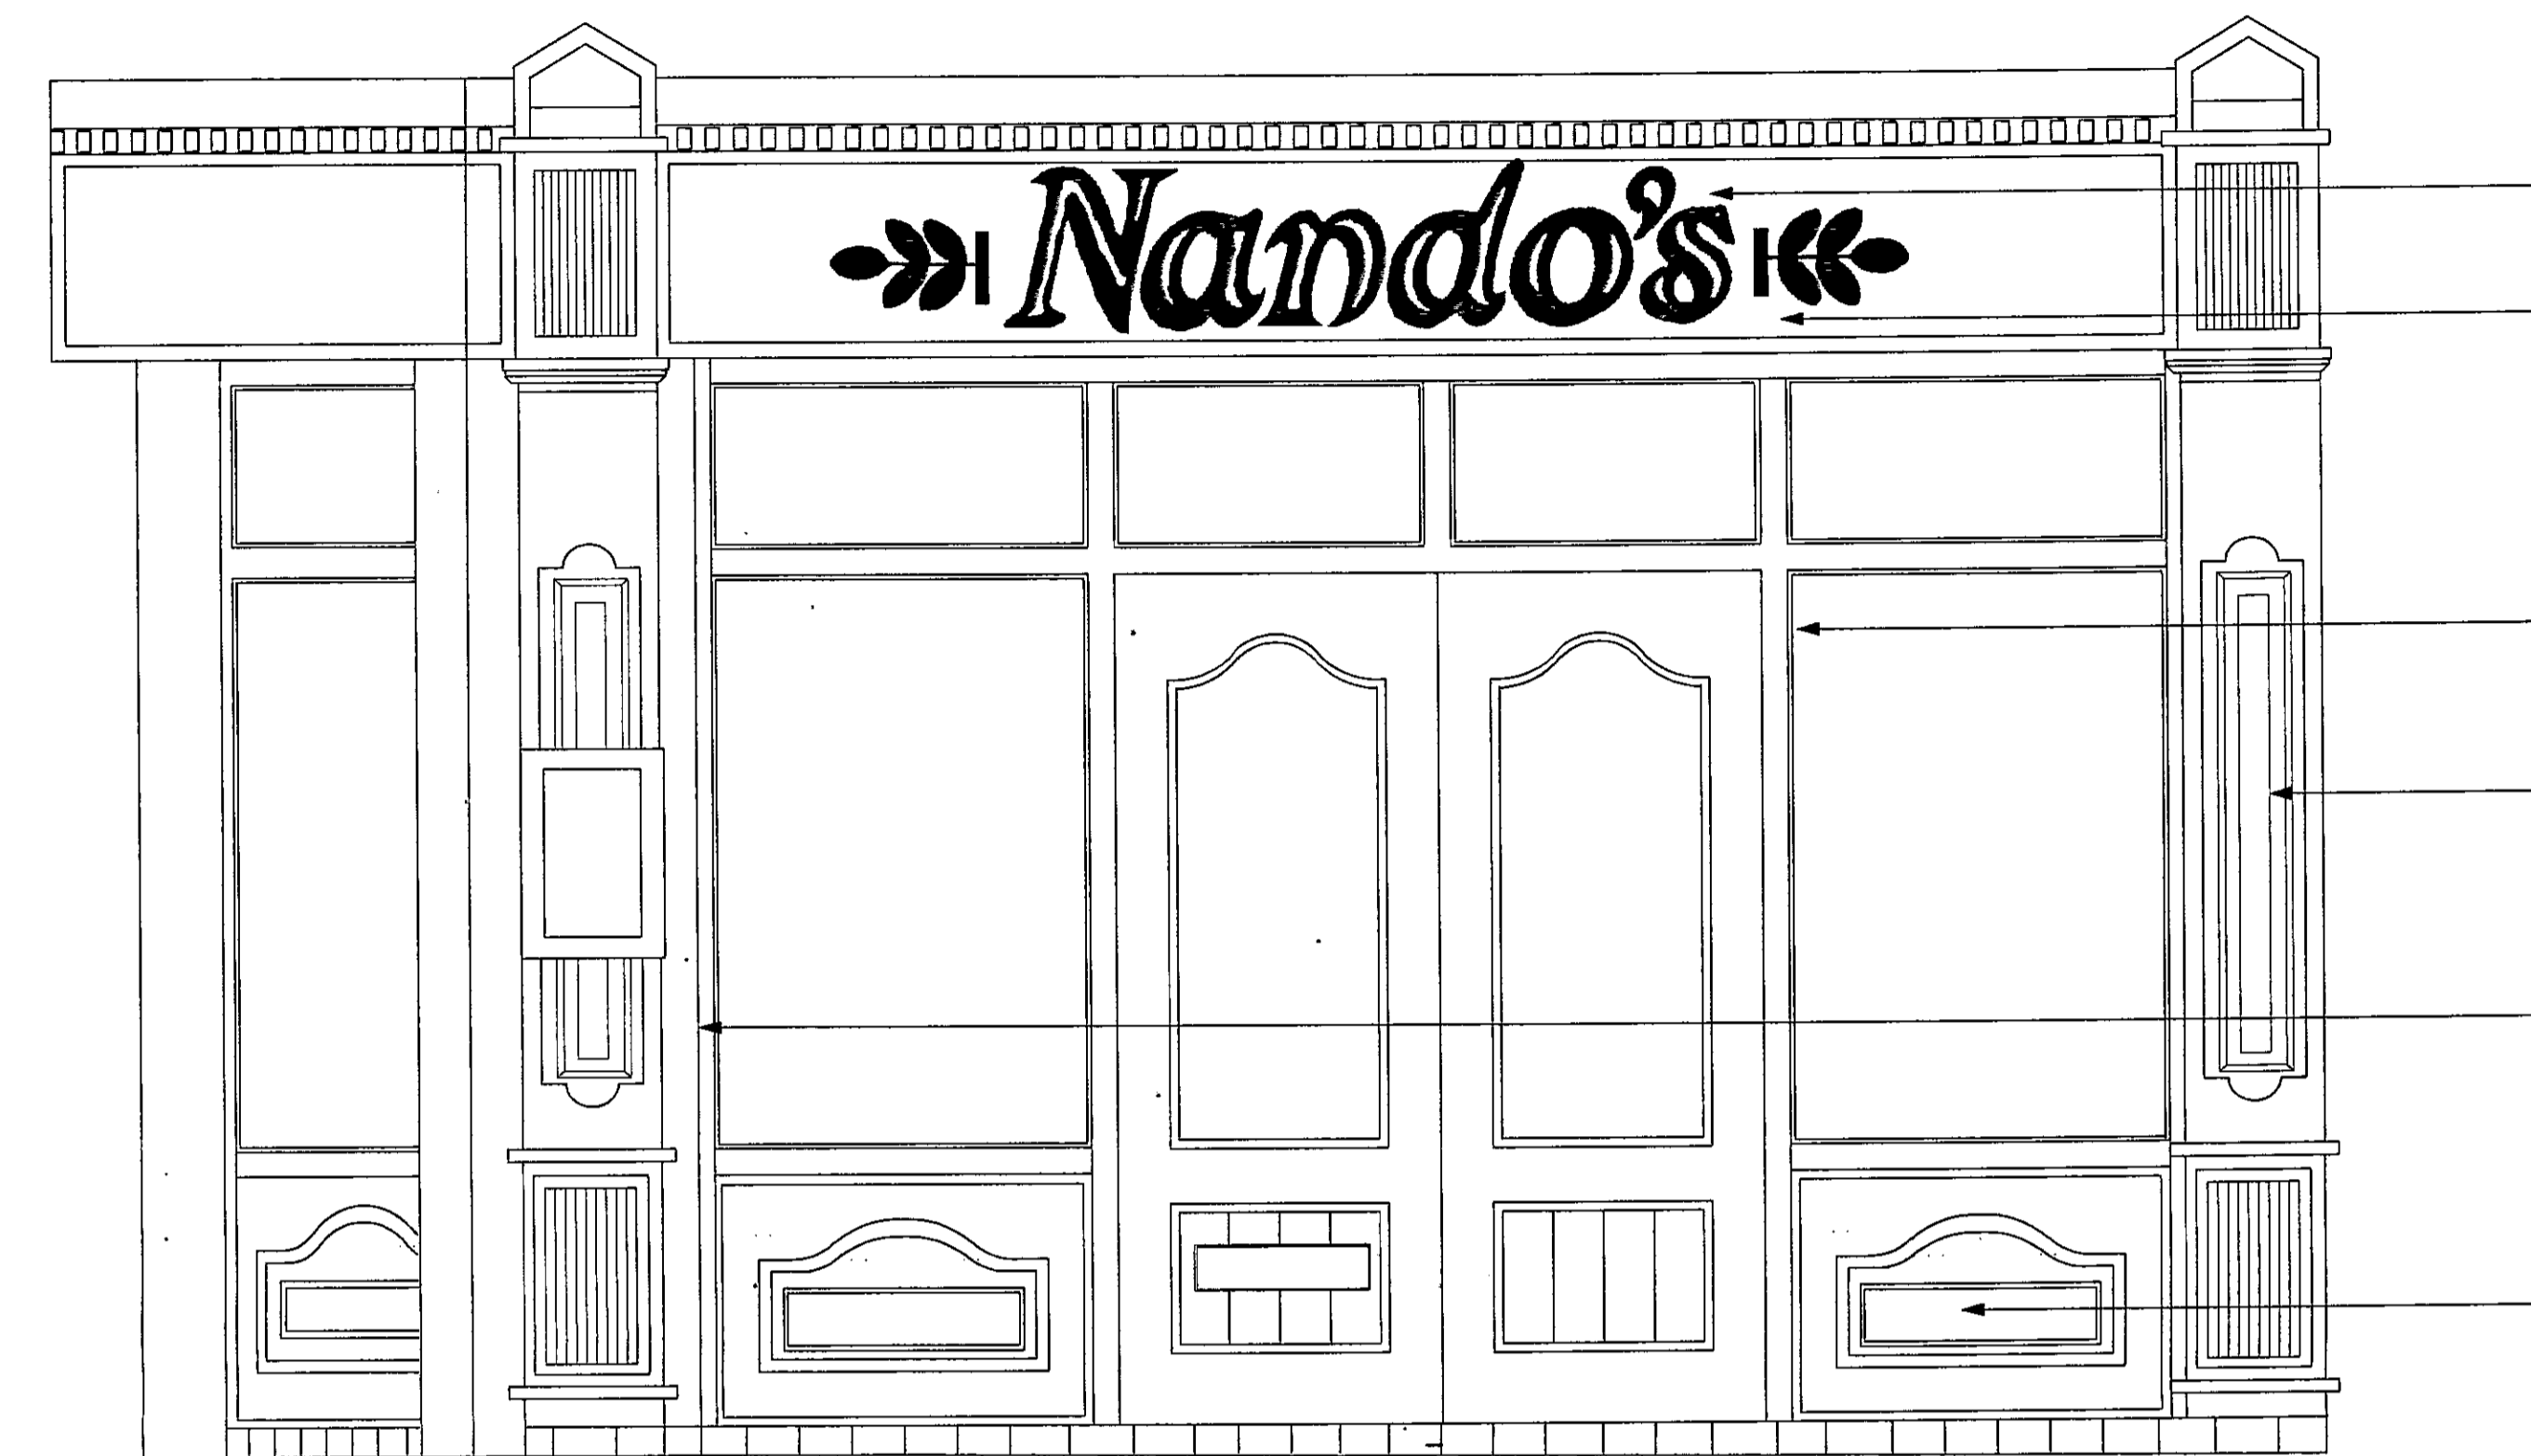

- NEW SIGNAGE BUILT UP ACRYLIC LETTERS INTERALLY ILLUMINATED WITH RED NEON.
- NEW TIMBER FACIA PAINTED GREEN DULUX (1116 Y18R)
- NEW SAFTEY GLAZING (BS 8026) WITH TIMBER FRAMING PAINTED GREEN, DULUX (1116 Y18R)
- NEW TIMBER PLASTER WITH FLUTING, CAPITAL & CORSEL DETAILS PAINTED YELLOW, DULUX(0010 Y20R)
- EXISTING WALL TO BE PAINTED YELLOW, DULUX (1116 Y20R)
- NEW TIMBER STALL RISER PAINTED GREEN. DULUX (1116 Y18R)

EARL'S COURT RD. ELEVATION

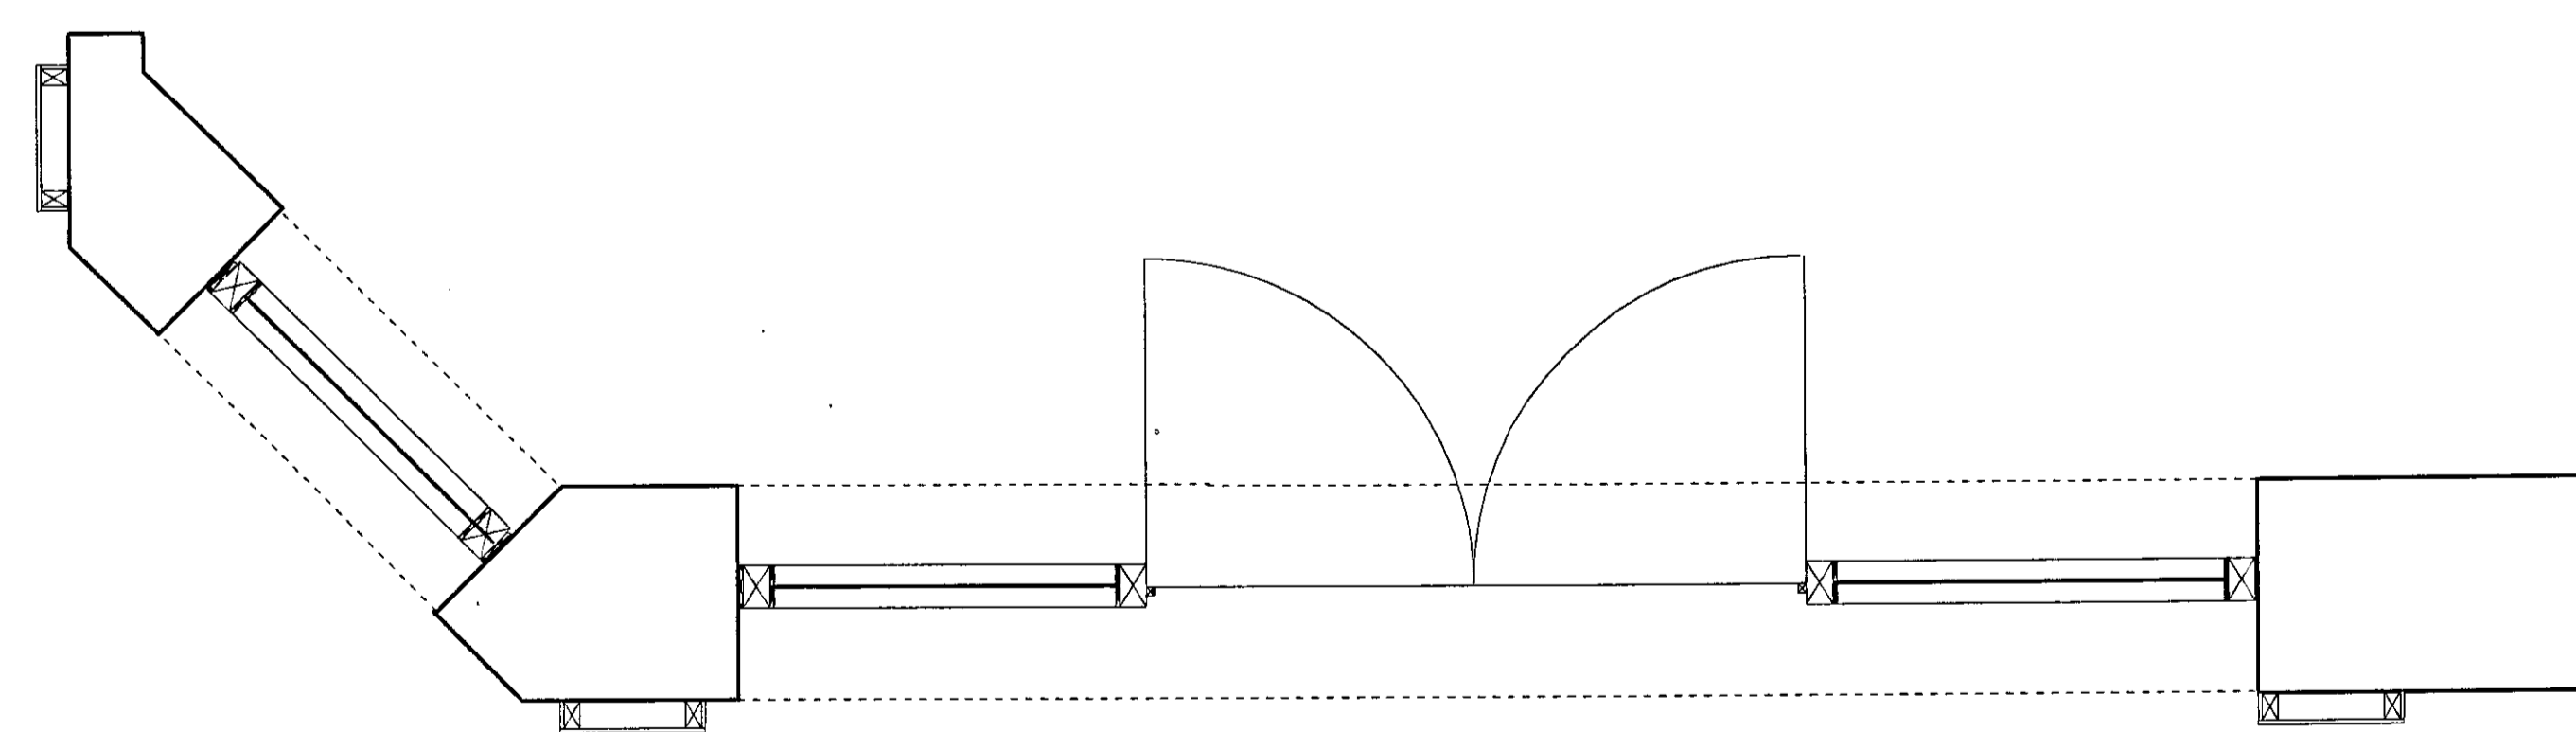

EARL'S COURT RD. PLAN

DELEGATED APPROVAL  
27 AUG 1999

(5)


1:1	0	10mm	20	30	40	50	60	70	80	90	100	110			
1:100	0	1m	2	3	4	5	6	7	8	9	10	11			
1:5	0	100mm	200	300	400	500									
1:50	0	1m	2	3	4	5									
1:20	0	200mm	400	600	800	1000	1200	1400	1600	1800	2000	2200			
1:200	0	2m	4	6	8	10	12	14	16	18	20	22			
1:1250	0	10m	20	30	40	50	60	70	80	90	100	110	120	130	140
1:2500	0	20m	40	60	80	100	120	140	160	180	200	220	240	260	280

pp99074E/B

R.D.K. & C.  
TOWN PLANNING  
10 AUG 1999  
RECEIVED


<b>ATTWOOD ASSOCIATES</b> <small>ENTERPRISE HOUSE BISHOPS WINDMILL LANE LONDON SW11 1BS TEL 0181 225 7118 FAX 0181 225 778011</small>	
CLIENT	NANDOS
PROJECT	204 EARLS COURT ROAD LONDON SW
TITLE	SHOPFRONT DETAILS EARL'S COURT ELEVATION
DRAWING NO.	1206/15B
REVISION	A
SCALE	1:20
DRAWN BY	CWP
DATE	AUG 99

NOTES
THIS DRAWING IS THE PROPERTY OF ATTWOOD AND ASSOCIATES. IT IS NOT TO BE REPRODUCED OR COPIED IN ANY MANNER WITHOUT THE WRITTEN CONSENT OF ATTWOOD AND ASSOCIATES. THIS DRAWING SHOULD ONLY BE USED FOR THE PURPOSES SPECIFIED AND ALL DIMENSIONS SHOULD BE CHECKED ON SITE.
REVISION NOTES
A - AUG 99 - AS BUILT DRAWINGS

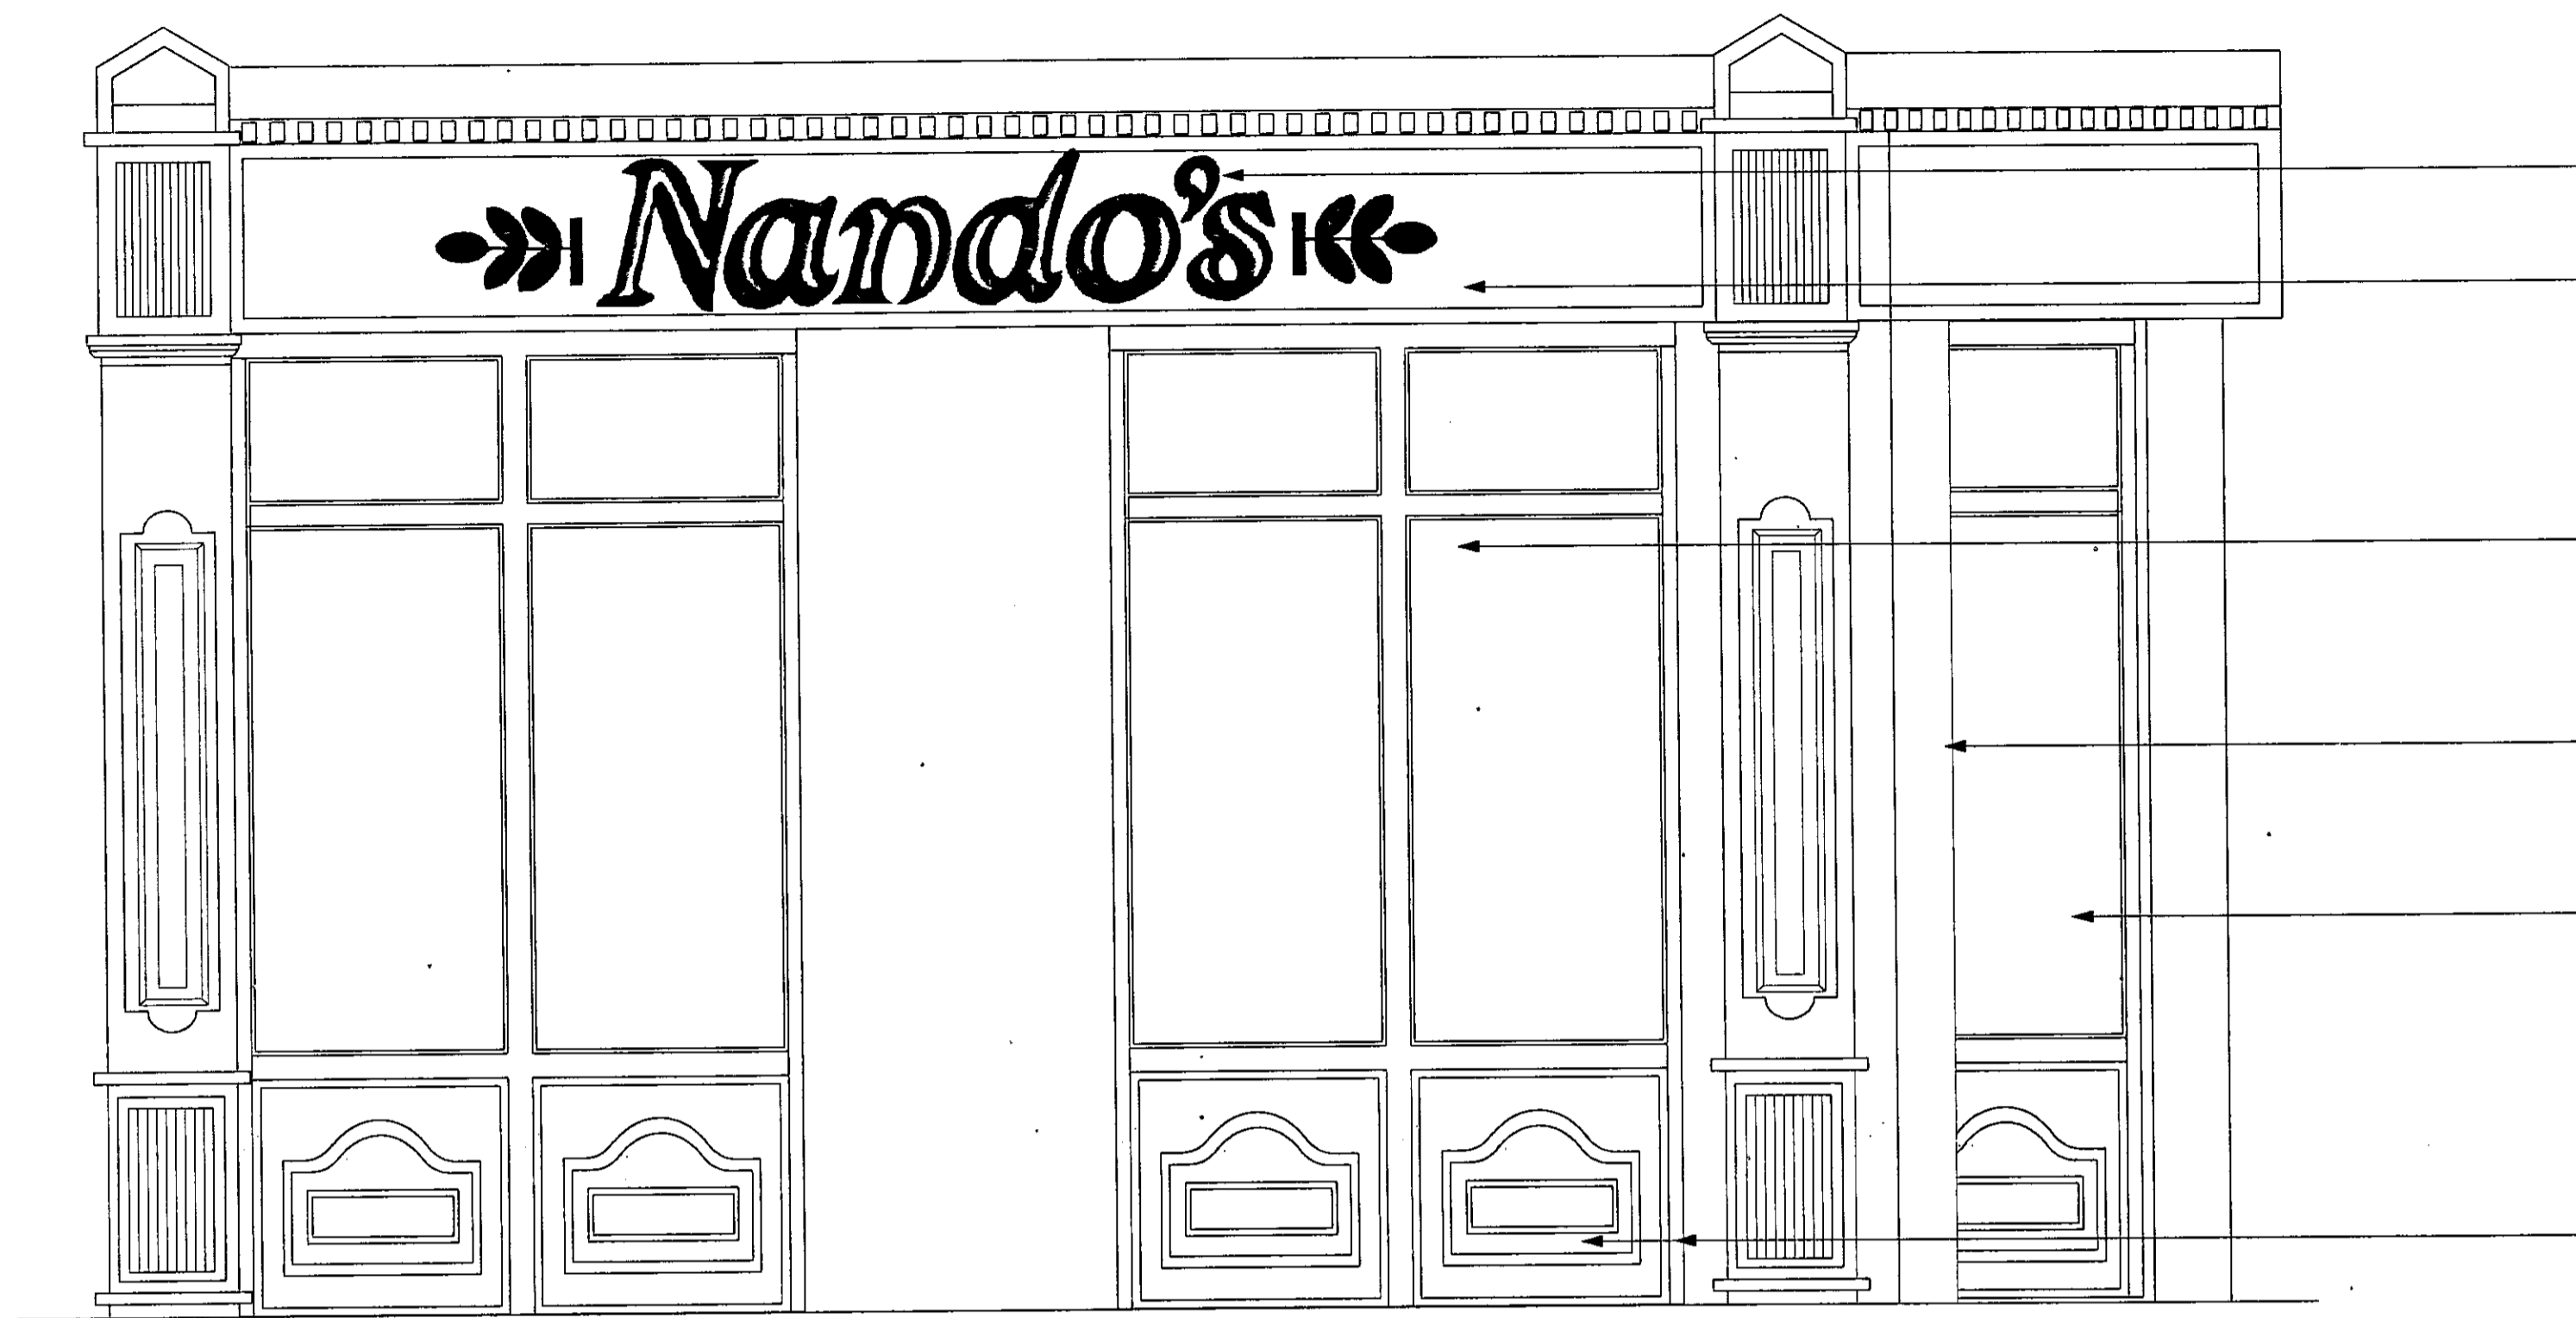


TREBOVIR RD ELEVATION


- NEW SIGNAGE BUILT UP ACRYLIC LETTERS INTERNALLY ILLUMINATED WITH RED NEON.
- NEW TIMBER FACIA PAINTED GREEN DELUX (1116 Y18R)
- NEW SAFETY GLAZING ( BS 6028 ) WITH TIMBER FRAMING PAINTED GREEN, DULUX (1116 Y18R)
- NEW TIMBER PILASTER WITH FLUTING, CAPITAL & CORSEL DETAILS PAINTED YELLOW, DULUX(0010 Y20R)
- EXISTING WALL TO BE PAINTED YELLOW, DULUX (1116 Y20R)
- NEW TIMBER STALL RISER PAINTED GREEN, DULUX (1116 Y18R)

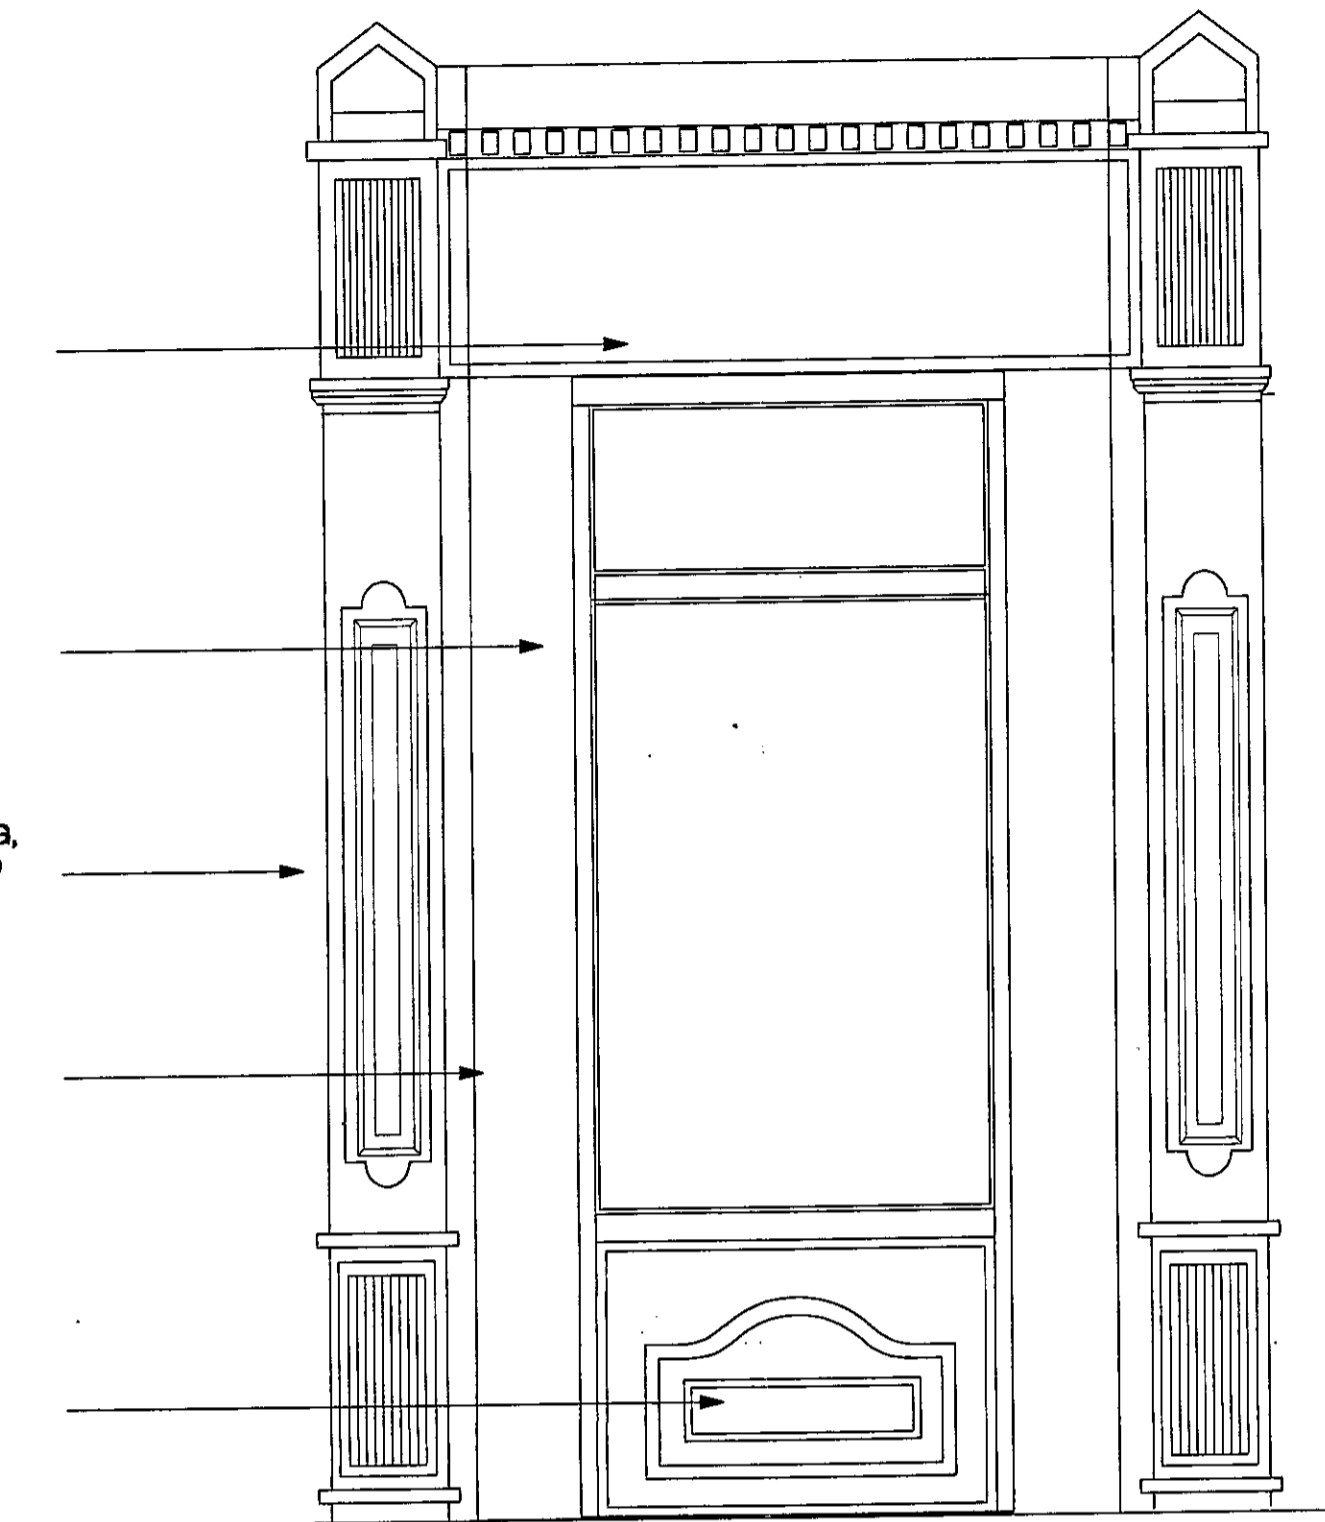

CORNER ELEVATION .

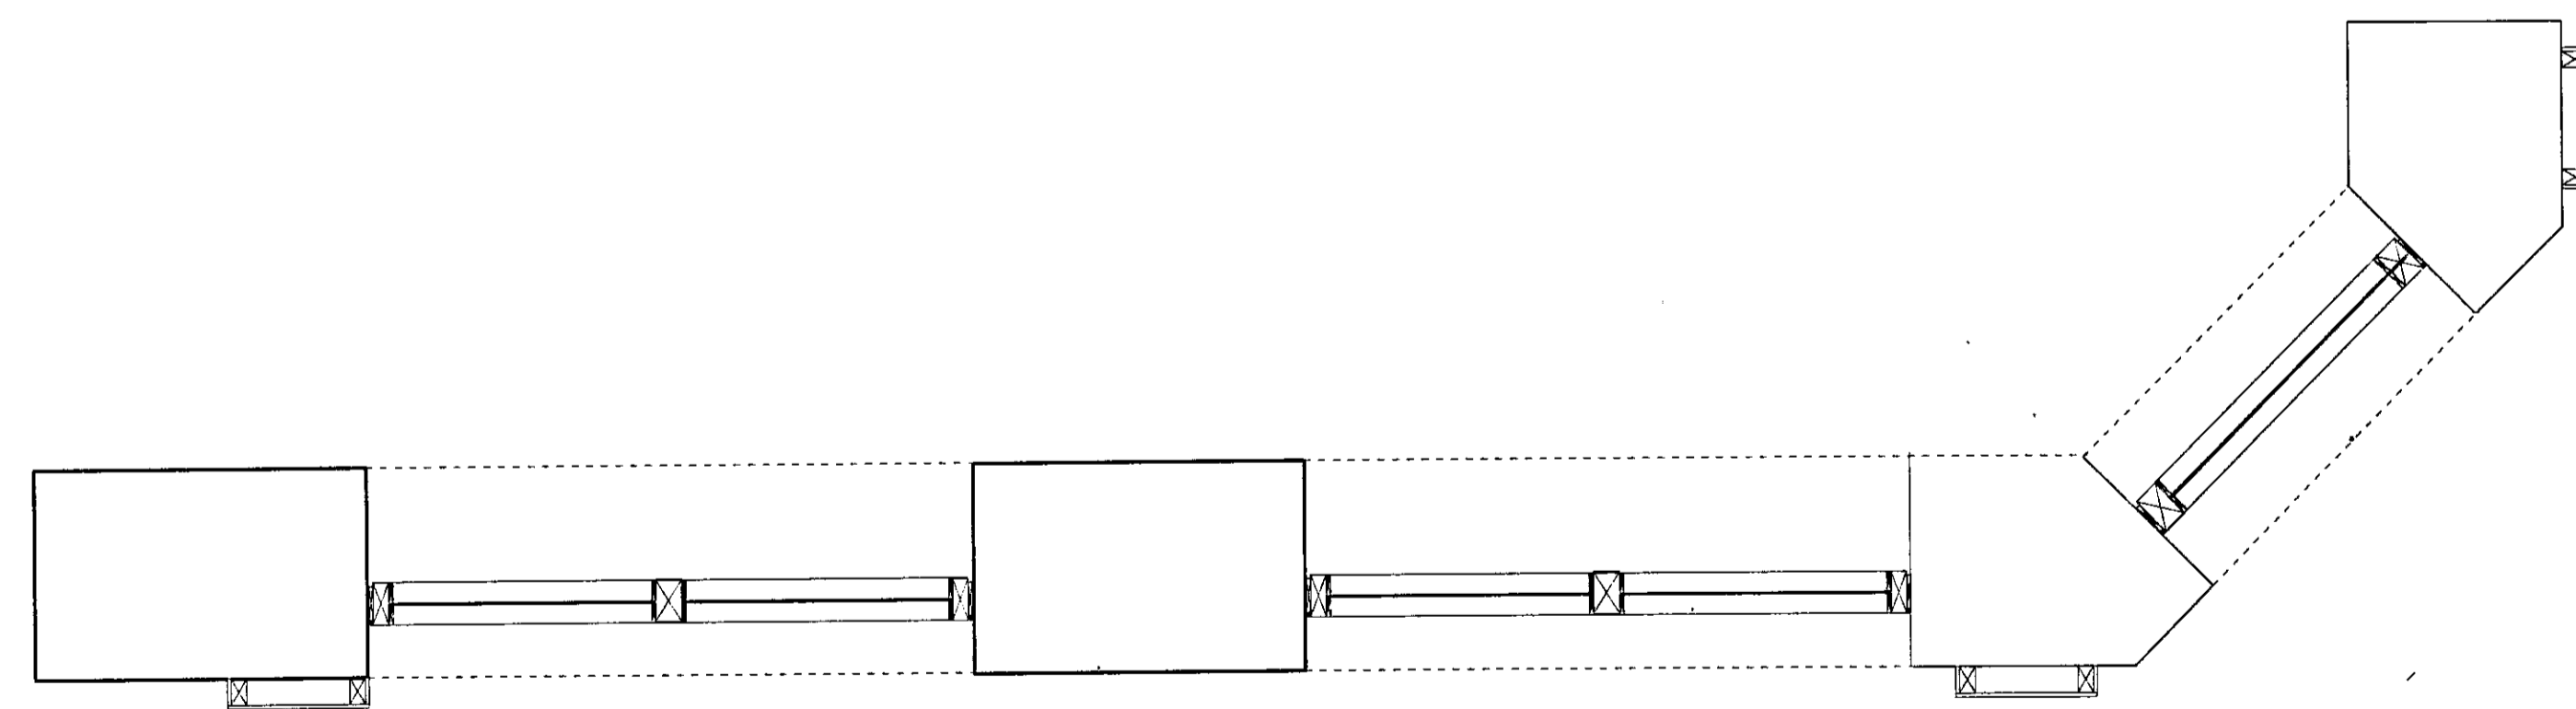

TREBOVIR RD PLAN

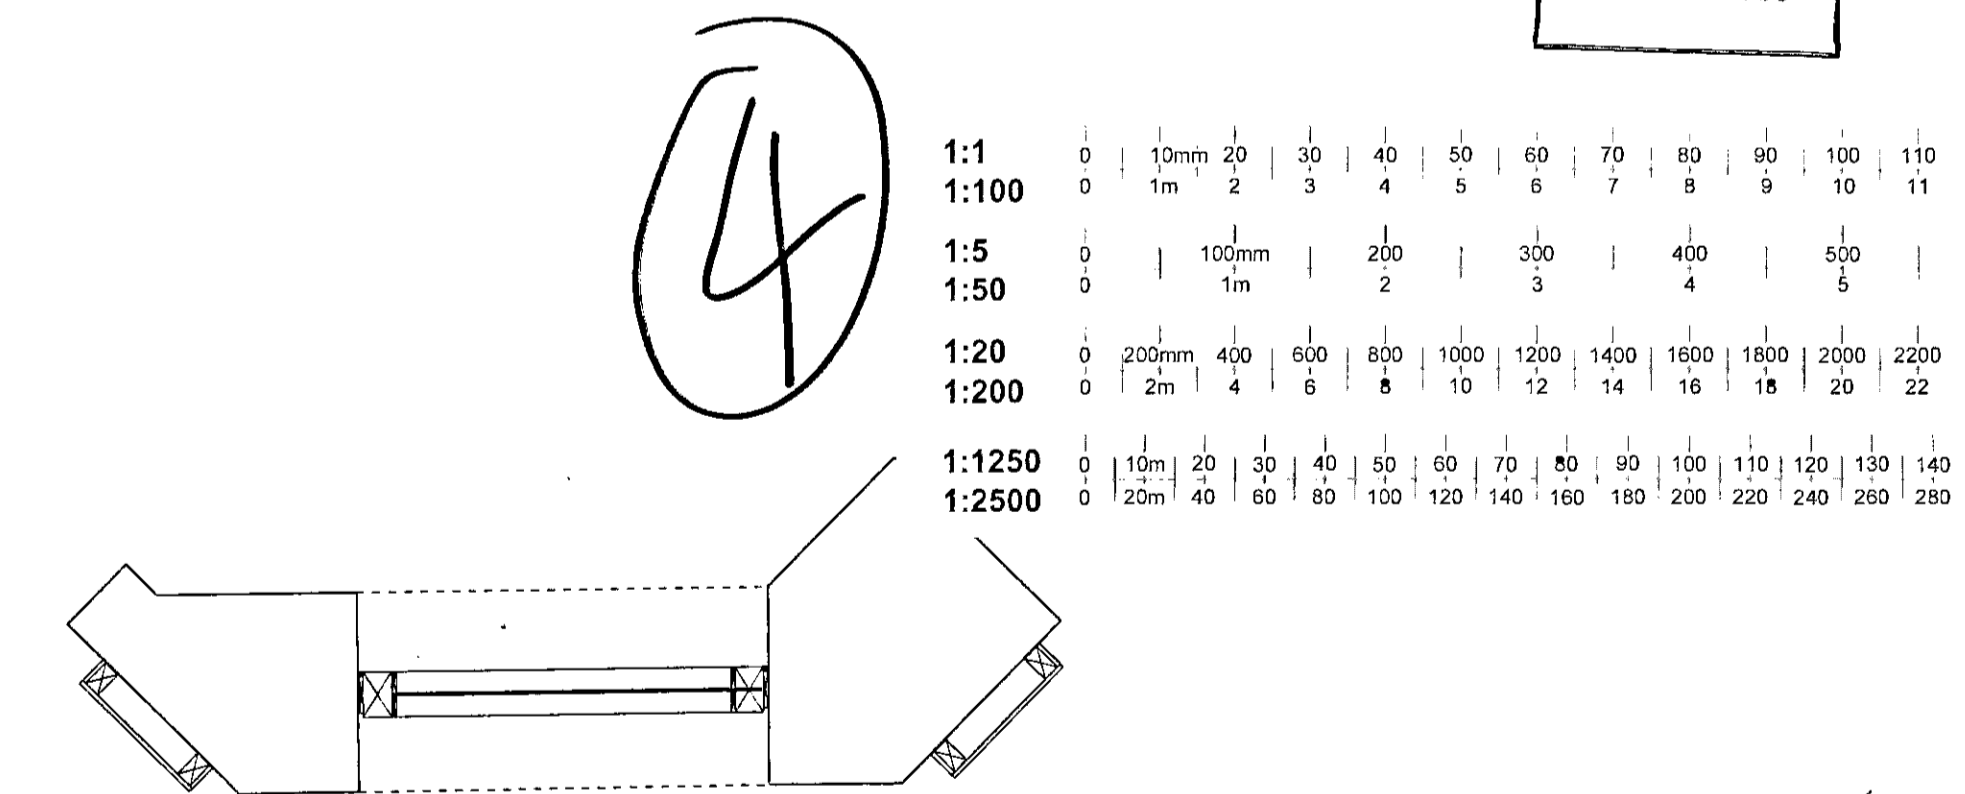

CORNER PLAN

DELEGATED APPROVAL  
27 AUG 1999

1:1	0	10mm	20	30	40	50	60	70	80	90	100	110			
1:100	0	1m	2	3	4	5	6	7	8	9	10	11			
1:5	0	100mm	200	300	400	500									
1:50	0	1m	2	3	4	5									
1:20	0	200mm	400	600	800	1000	1200	1400	1600	1800	2000	2200			
1:200	0	2m	4	6	8	10	12	14	16	18	20	22			
1:1250	0	10m	20	30	40	50	60	70	80	90	100	110	120	130	140
1:2500	0	20m	40	60	80	100	120	140	160	180	200	220	240	260	280

pp990745 / B

R.B.K.&C.  
TOWN PLANNING  
7 0 AUG 1999  
RECEIVED

ATTWOOD ASSOCIATES

ENTERPRISE HOUSE RESOURCES AND MARKETING  
PERFORMANCE PARTNERSHIP 999 708  
TEL: 01203 711882 FAX: 01203 711811

CLIENT	NANDOS
PROJECT	204 EARLS COURT ROAD LONDON SW
TITLE	SHOPFRONT DETAILS TREBOVIR ELEVATION
DRAWING NO.	1206/15A
REVISION	A
SCALE	1:20
DRAWN BY	CWP
DATE	AUG 99