


PP/11/2421/rev A.


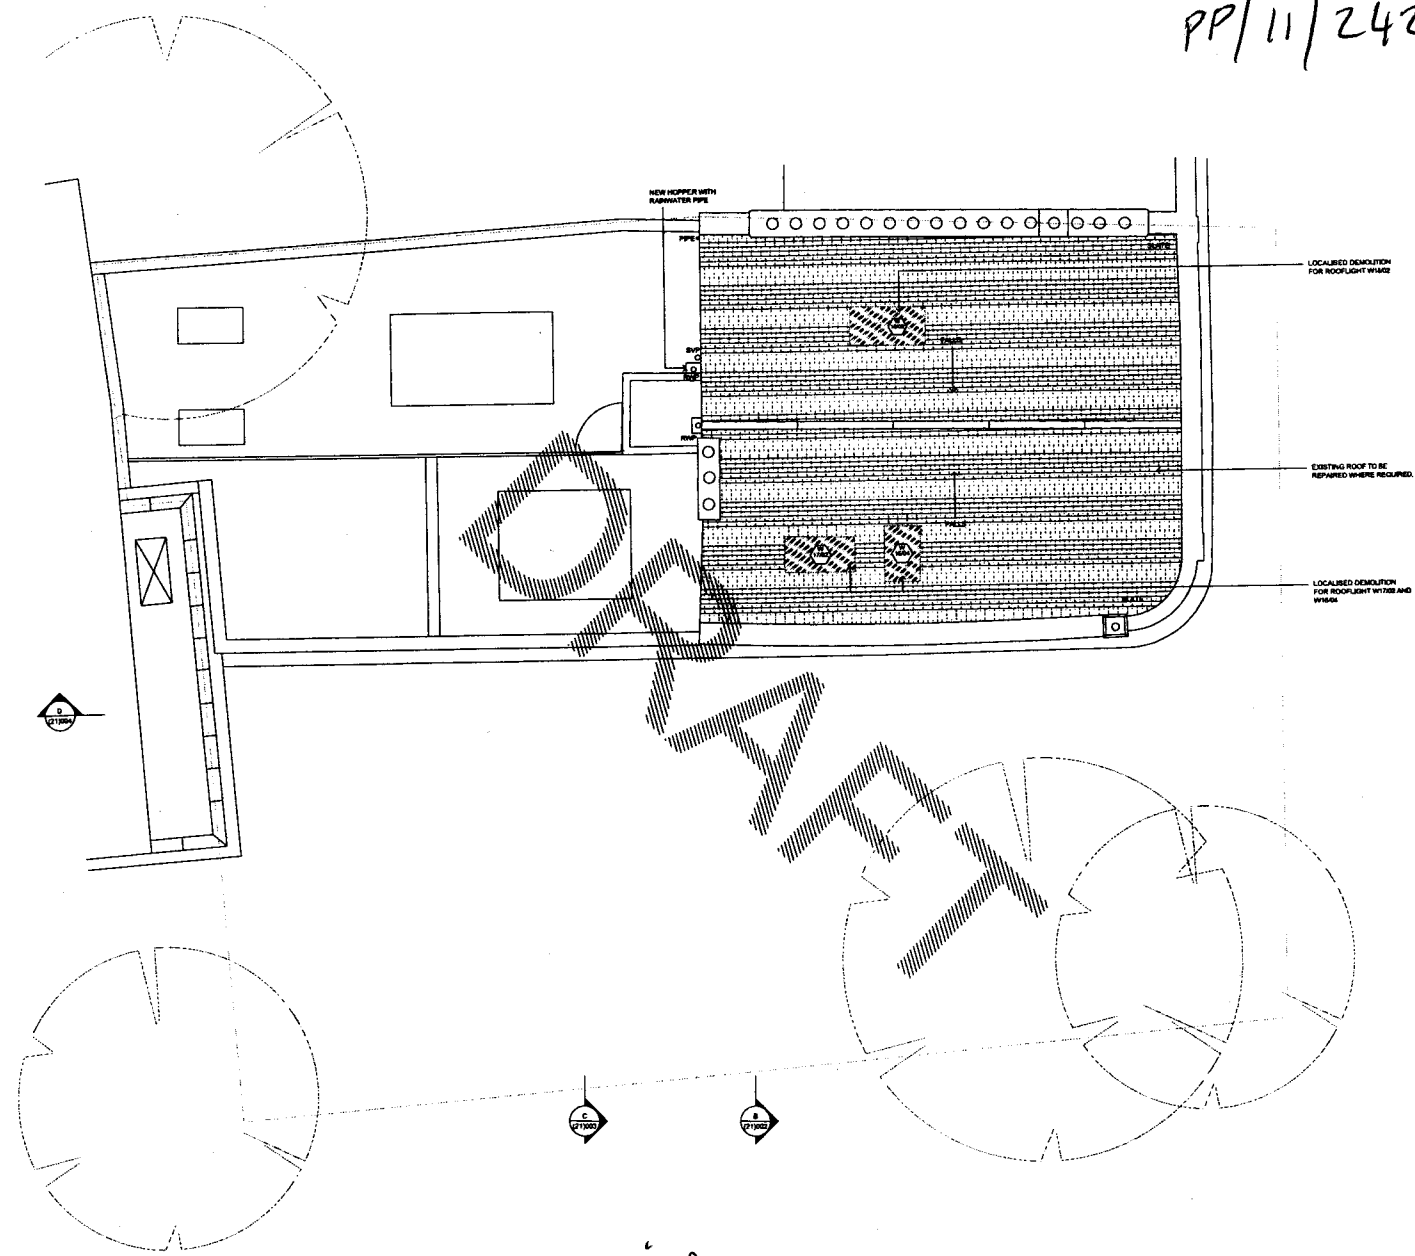

CLIENT: **RAB PENSION TRUST**

THE TREVOR LAHRF ARCHITECTS

1. On the date of this drawing, the design is preliminary. All dimensions and lines to be erected or to be demolished are subject to the final report of structural engineers and other relevant professionals.
2. Issues only for permission purposes.
3. The drawing is to be used in conjunction with other documents and should not be relied upon for construction. All work should be carried out in accordance with the relevant building regulations and BS5400 standards.
4. The drawing is copyright and shall remain the property of TLA and shall not be copied, altered or reproduced in any way without the prior written consent of the author.
5. The author accepts no liability for any errors or omissions in this drawing.
6. The drawings shown on this drawing have been based on the information provided by an independent survey company.
7. Approval to be provided by the relevant authority for TLA approval.
8. TLA is not responsible for drawings and shall not be liable for any errors or omissions.

**PROPOSED**

SPECIFIC NOTES:

REV	DATE	DESCRIPTION	BY	CHK
01	05/11/11	DRAFT PLANNING SUBMIT	AL	AL
02	06/11/11	REVISIONS	AL	AL
03	11/11/11	REVISIONS	AL	AL

9 PHENE STREET  
LONDON SW3 5NY

TITLE: **ROOF DEMOLITION PLAN**

DATE: PLANNING	DESIGN BY: RL
SCALE: 1:50 @ A1	CHECKED BY:
DATE: JULY 2011	DATE: 001
PROJECT:	REV: P3

*confirm  
 permit  
 free.*

*Also need to look at S106 contribution.*

*All received 02/12/11*






CLIENT  
**RAB PENSION TRUST**

- TREVOR LAMB ARCHITECTS

**PROPOSED**

PROPOSED

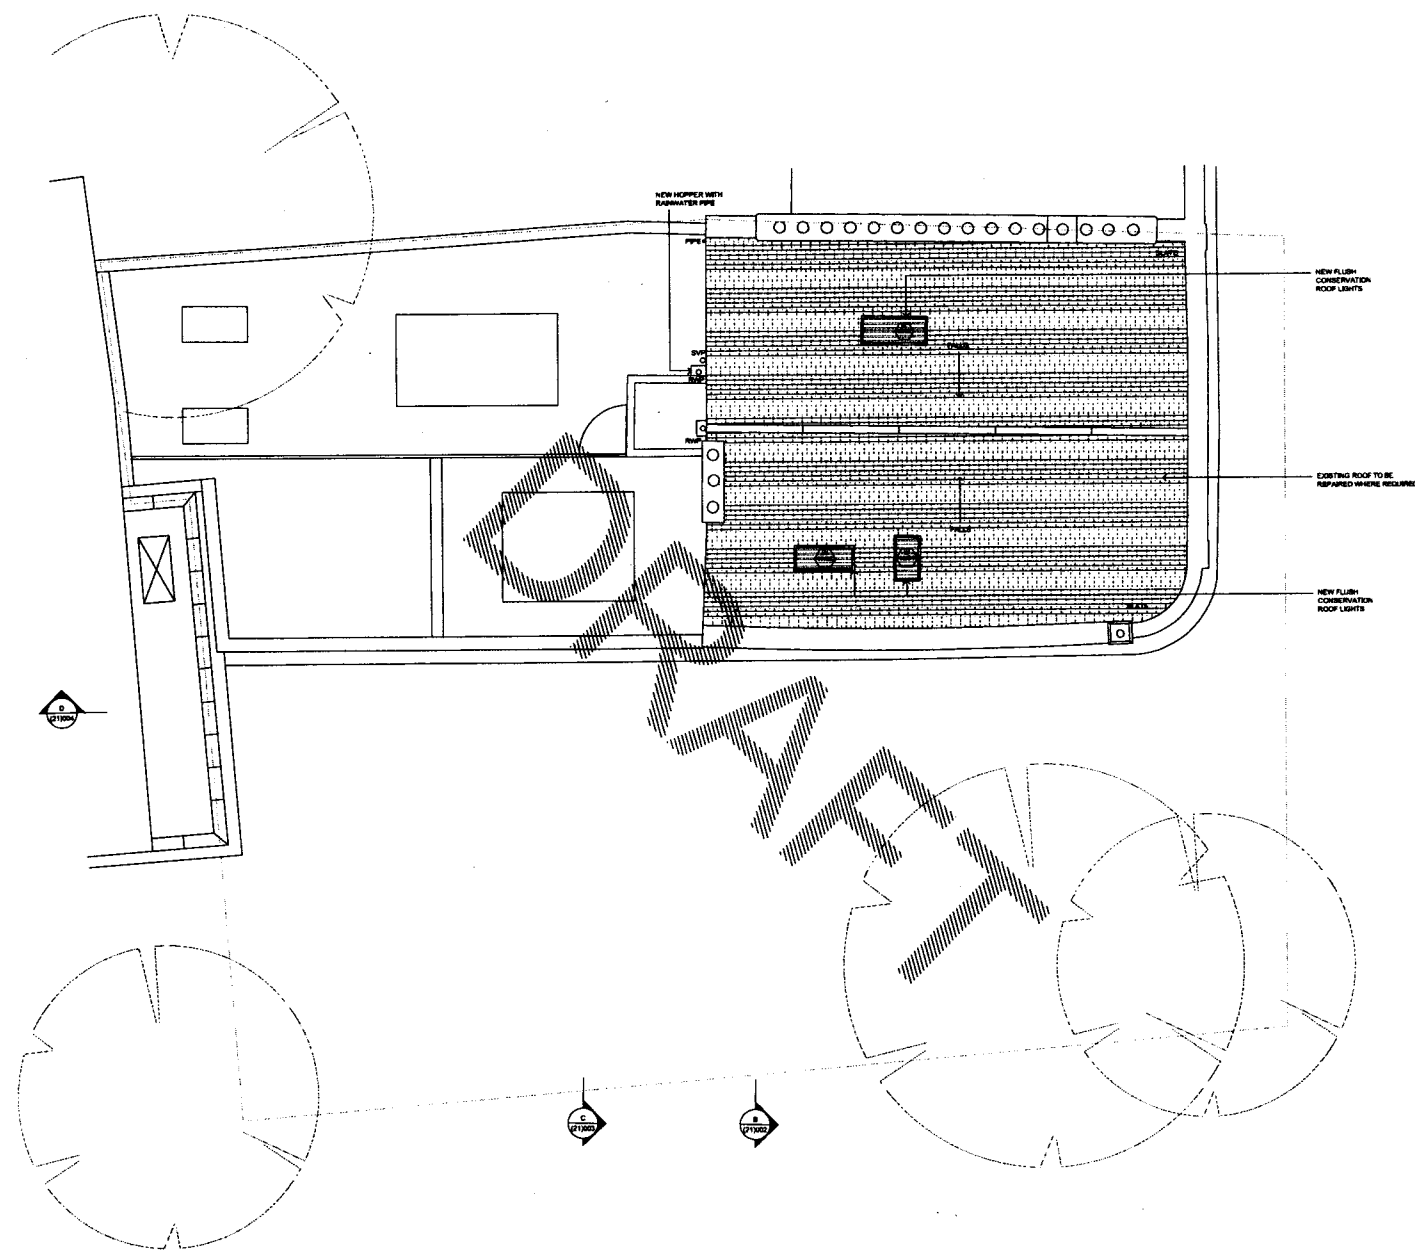

REV	DATE	DESCRIPTION	BY	CHK
01		ISSUE FOR DRAFT PLANNING BREE		
02		REVISIONS		
03		REVISIONS		

9 PHENE STREET  
LONDON SW3 5NY

**PROPOSED ROOF PLAN**

STATUS	PLANNING	DATE	004
SCALE	1:50 @ A1	DESIGNED BY	RL
DATE	JULY 2011	CHECKED BY	RL
PROJECT		NO.	004





PROPOSED ROOF PLAN - SCALE 1:50 @ A1 & 1:100 @ A3

CLIENT  
**RAB PENSION TRUST**



**PROPOSED**


SPECIFIC NOTES

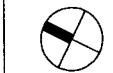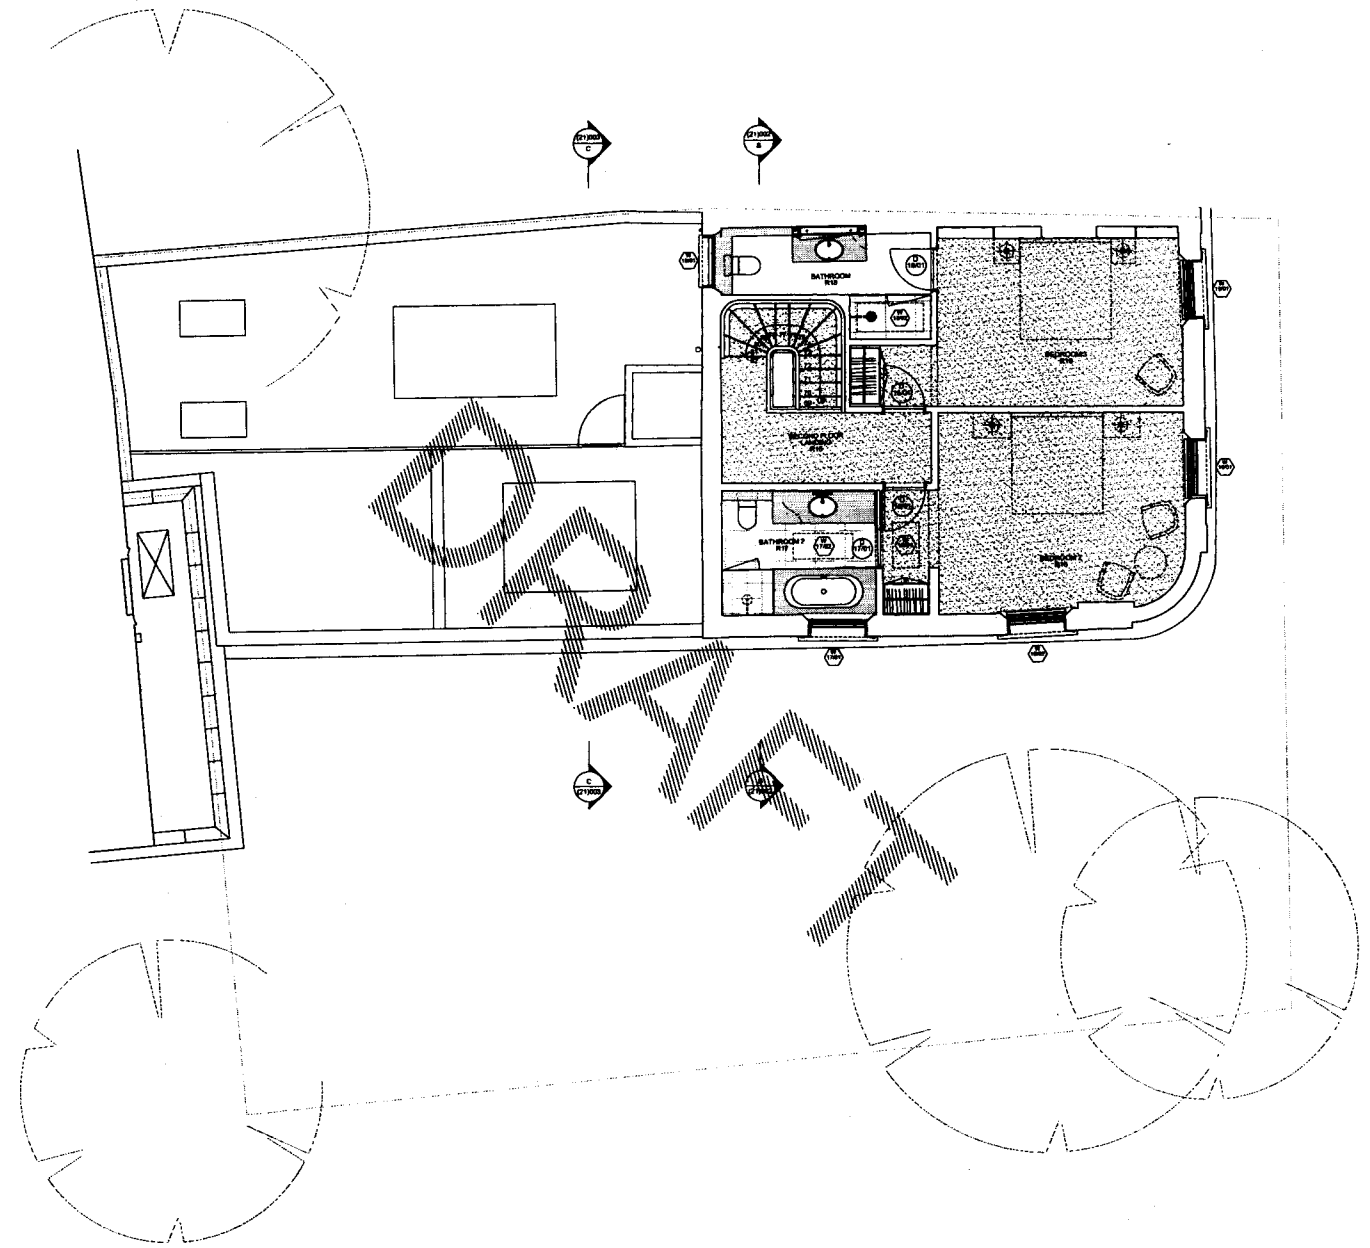


PROPOSED SECOND FLOOR PLAN - 1:50 @ A1 & 1:100 @ A3

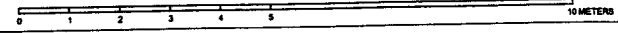

NO.	DATE	DESCRIPTION	BY	CHK
PROJECT <b>8 PHENE STREET                  LONDON SW3 5NY</b>				
TITLE <b>PROPOSED SECOND FLOOR PLAN</b>				
STATUS	PLANNING	DATE		
SCALE	1:50 @ A1 & 1:100 @ A3	DESIGNED BY		
DATE	JULY 2011	CHK		
PROJECT	822 (20)	NO.	003	PS

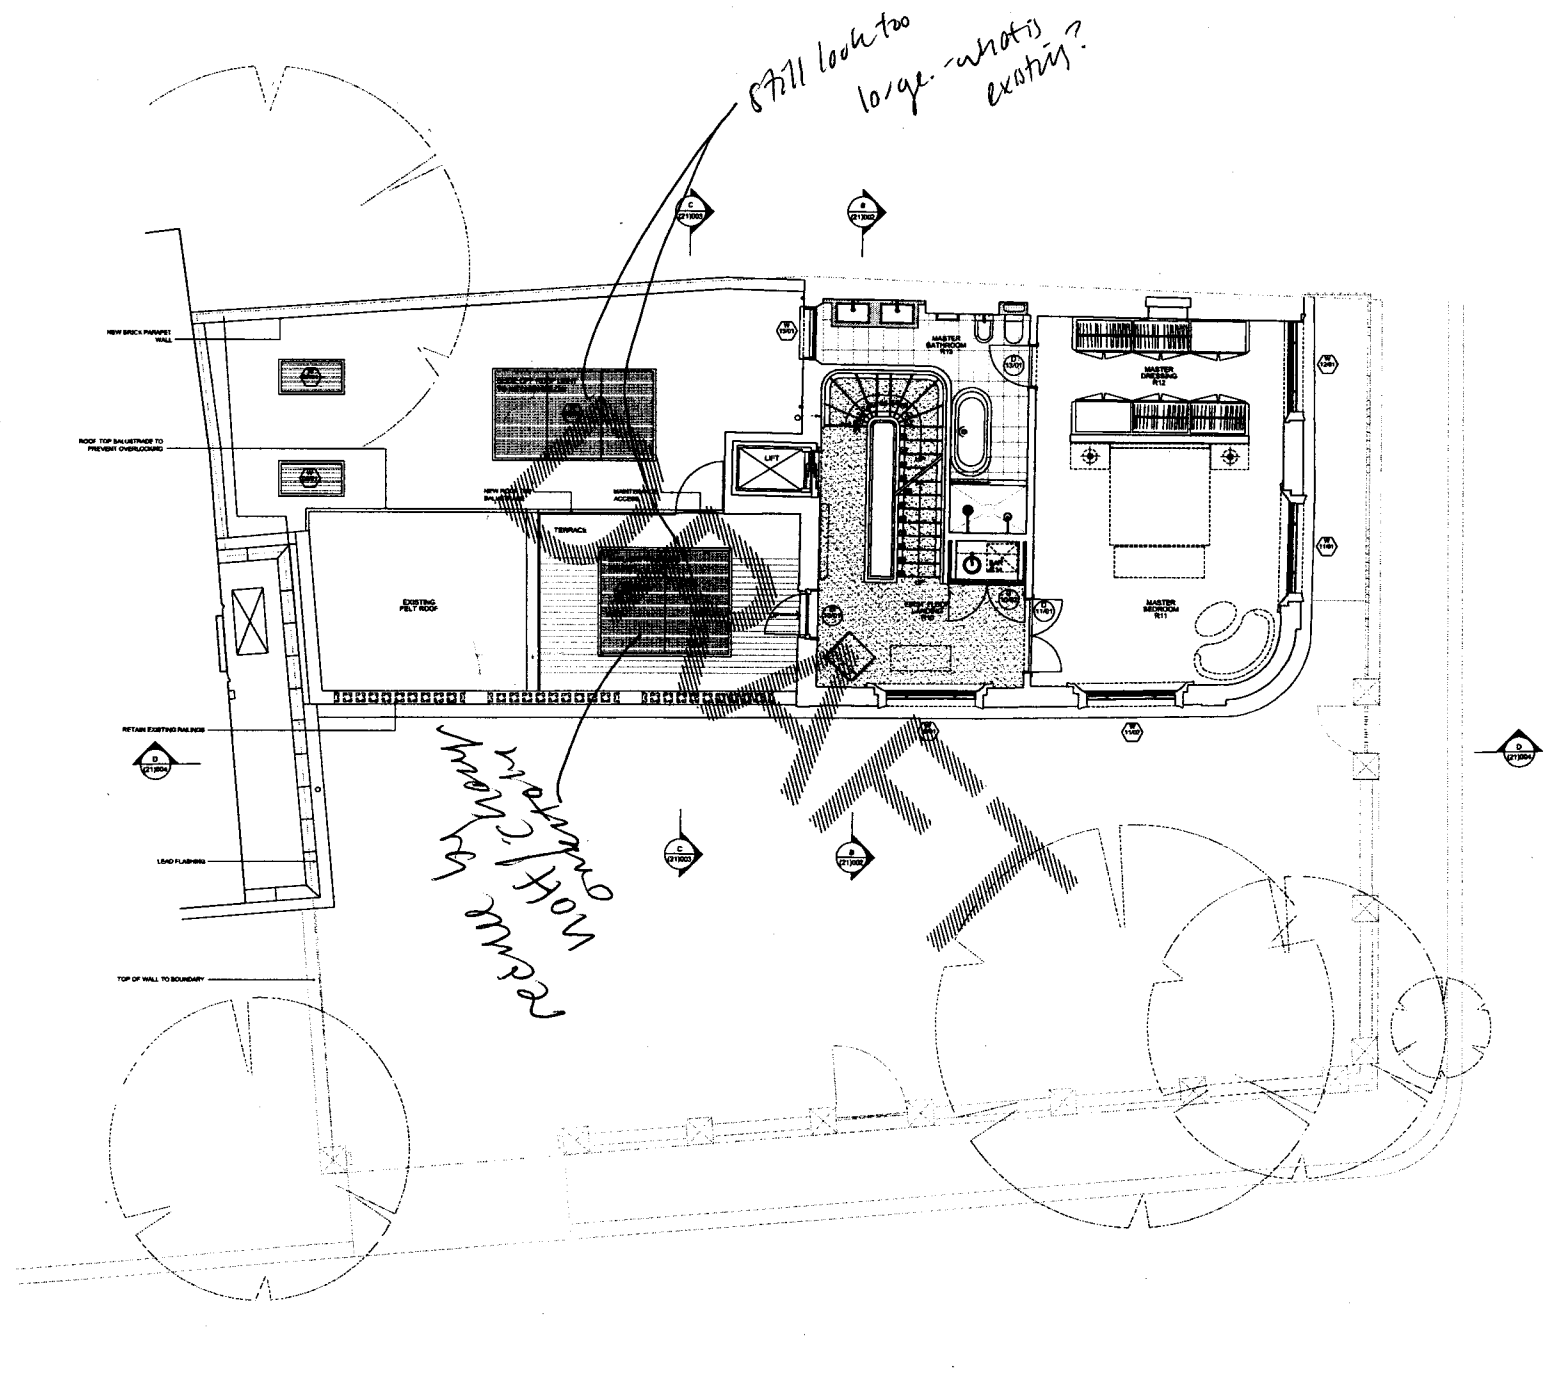

PROPOSED FIRST FLOOR PLAN - 1:50 @ A1 & 1:100 @ A3

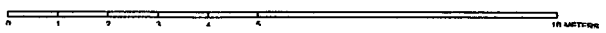


CLIENT  
**RAB PENSION TRUST**

TREVOR LAMPY ARCHITECTS

1. Do not scale off this drawing, use printed dimensions only. All dimensions and levels to be dimensioned to Contractor unless otherwise indicated. Builders obliged to comply with local and national building regulations and standards.
2. This drawing is for contract reference.
3. This drawing is to be made in conjunction with structural drawings and specifications before proceeding with construction. All dimensions and levels to be dimensioned to Contractor unless otherwise indicated. Builders obliged to comply with local and national building regulations and standards.
4. This drawing is copyright and sale proceeds of TLA and the drawings herein, shall be returned to the author or destroyed if it is used in any other way without the author's consent.
5. The design contained herein is for contract with the relevant authorities under the CDM regulations.
6. The drawings shown on this drawing have been issued on the assumption provided by or intended for the client's use.
7. Permission to be provided by the author for TLA.
8. TLA to approve all drawings and use them in construction.

**PROPOSED**

SPECIFIC NOTES

NO	DATE	DESCRIPTION	BY	CHKD
PS	06.11.11	DRAWING PLANNING	RJL	SW
PL	06.11.11	REVISED	RJL	-
REV	DATE	DESCRIPTION	BY	CHKD

ADDRESS  
**9 PHENE STREET  
 LONDON SW3 5NY**

TITLE  
**PROPOSED FIRST FLOOR PLAN**

STATUS PLANNING	DESIGNED BY RJL
SCALE 1:50 @ A1 & 1:100 @ A3	CHECKED BY RW
DATE JULY 2011	DATE 002
PROJECT NO. 822	NO. (20)



VIEW OF THE EXISTING TREES & NEIGHBORING PROPERTY




VIEW OF THE EXISTING BUILDING

*amend slightly size*

*Unoccupied in residential street*

*Water ramp this way*

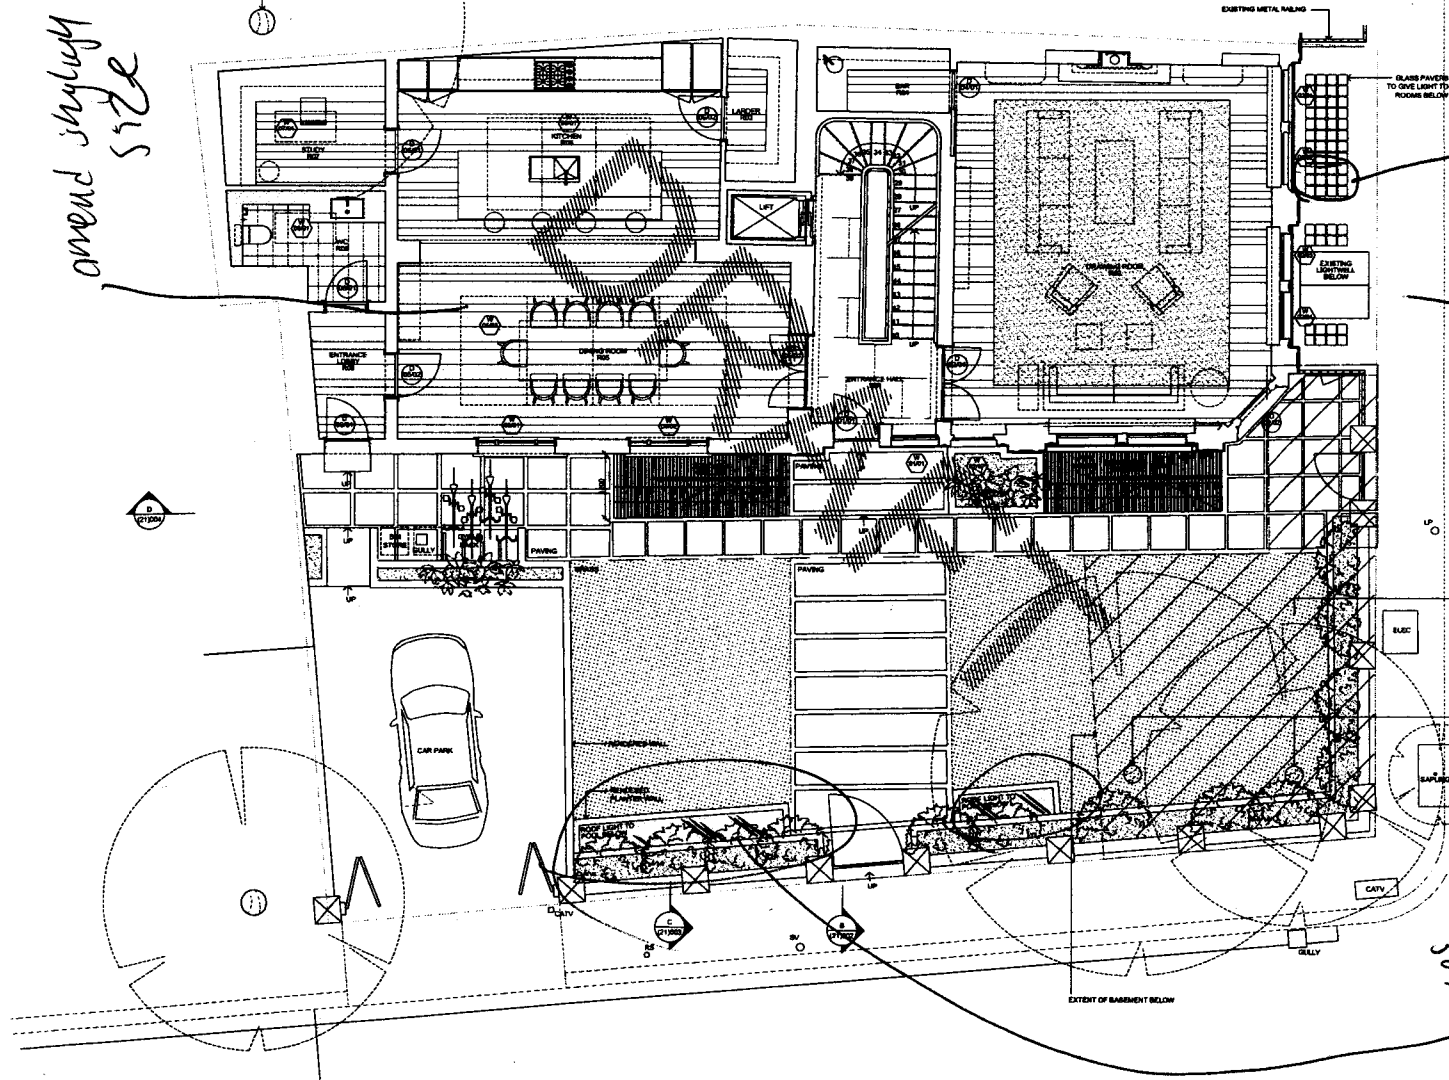


CLIENT: **RAB PENSION TRUST**

- TRIVOR | LAWRY ARCHITECTS
1. Do not scale off the drawings, use listed dimensions. Only all dimensions and levels to be treated as final. Dimensions apply to external finished levels unless otherwise stated. All dimensions are subject to the survey report of the architect and the client.
  2. Do not scale off the drawings, use listed dimensions.
  3. The drawings are to be used in conjunction with the contract documents and specifications. No part of the drawings is to be used for any other purpose without the written consent of the architect.
PROPOSED

SPECIFIC NOTES


NO.	DATE	DESCRIPTION	BY	CHKD
01	01/07/11	ISSUE FOR PERMITS	RL	RL
02	01/07/11	ISSUE FOR PERMITS	RL	RL
9 PHENE STREET  
 LONDON SW3 5NY


PROPOSED GROUND FLOOR PLAN

STATUS	PLANNING	DATE	001
SCALE	1:50 @ A1 / 1:100 @ A3	DESIGNED BY	RL
DATE	JULY 2011	CHECKED BY	RL
PROJECT	822 (20)	NO.	001

PROPOSED GROUND FLOOR PLAN - SCALE 1:50 @ A1 & 1:100 @ A3

 

*not acceptable  
ventilation/outlook  
light.*

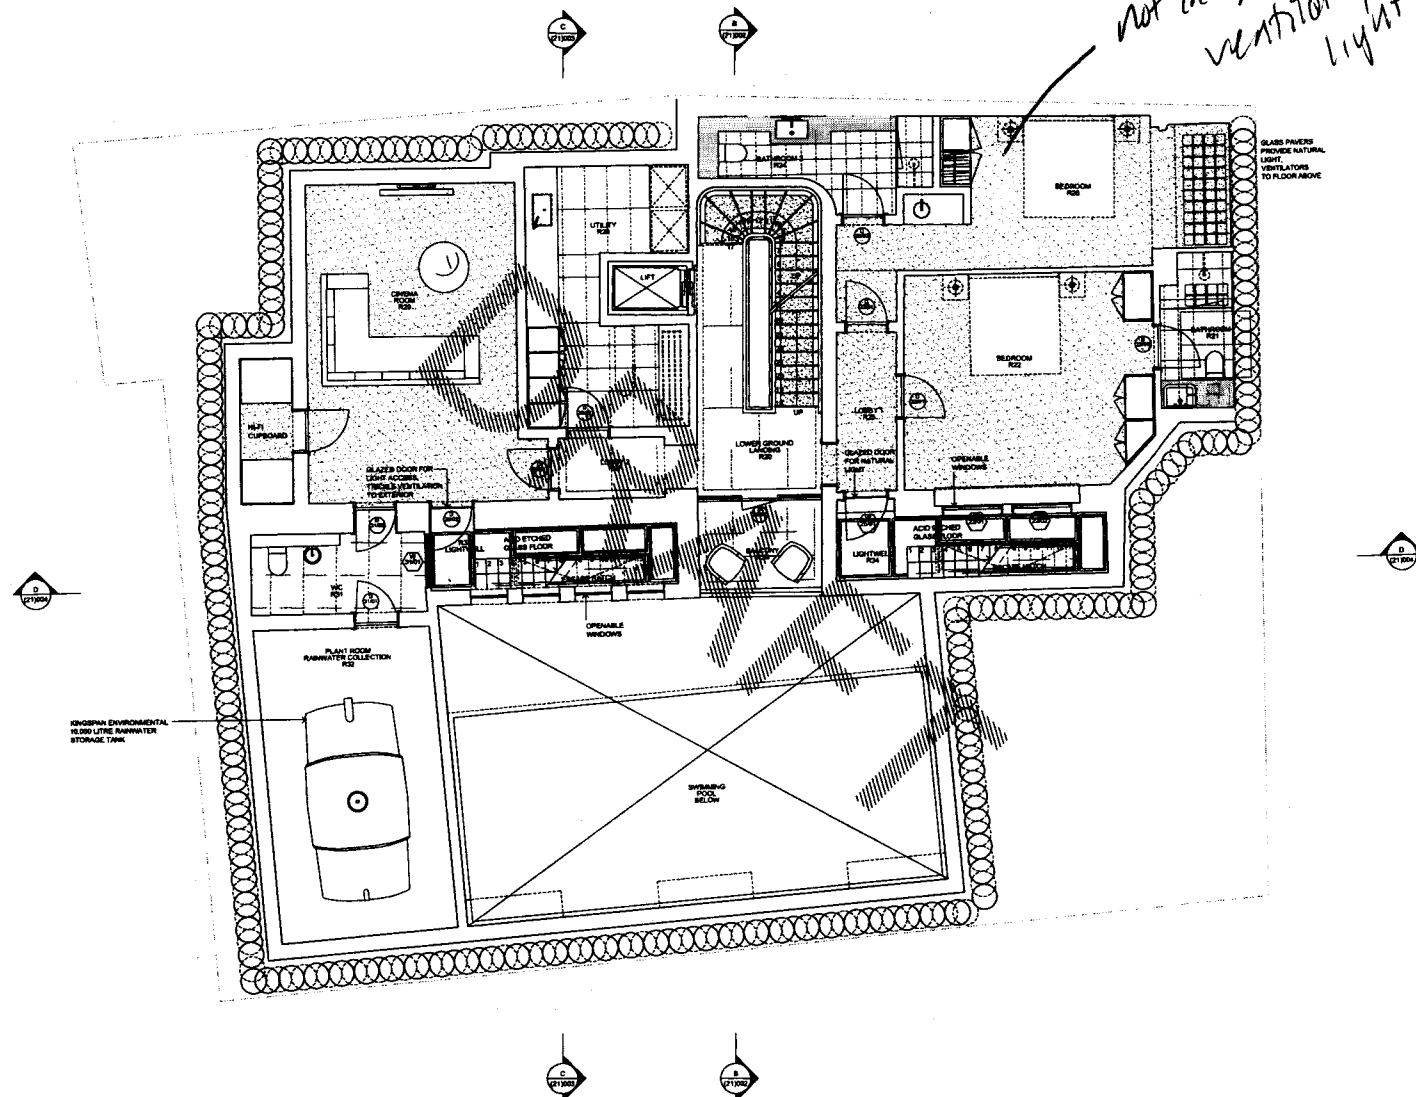

- CLIENT**  
RAB PENSION TRUST
- TREVOR | LANEY ARCHITECTS**
- Do not make any alterations, use fixed structures only, all alterations are to be approved by the Controller under sub-paragraph 6(1) of the lease or by the relevant authority in accordance with the lease.
  - Should only be proposed if allowed.

**PROPOSED**


SPECIFIC NOTES

REV	DATE	DESCRIPTION	DRAWN	CHECKED
01	01/07/11	ISSUE FOR PERMITS		
02	01/07/11	REVISIONS		
03	01/07/11	ADDITION OF SCALE BAR		
04	01/07/11	REVISIONS TO PLANNING CONSULT TYP		
05	01/07/11	REVISIONS TO PLANNING CONSULT TYP		


9 PHENE STREET  
LONDON SW3

**PROPOSED LOWER GROUND FLOOR PLAN**

STATUS	PLANNING	APPROVED	T/ND
SCALE	1:50 @ A1 & 1:100 @ A3	CHECKED BY	
DATE	JULY 2011	DATE	
PROJECT NO.	R22 (20)	DATE	

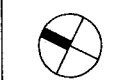

PROPOSED LOWER GROUND FLOOR PLAN - SCALE 1:50 @ A1 & 1:100 @ A3

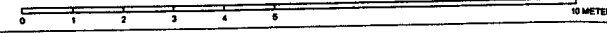


**RAB PENSION TRUST**

TREVOR LAFFY ARCHITECTS

- Do not scale off this drawing, use figure dimensions and all dimensions are based on the centre of walls. Dimensions are not to be used for any construction or other work without the written consent of the architect.
- Issued only for purposes intended.
- This drawing is to be used in conjunction with the drawings and specifications issued in connection with the contract for the building and any other documents which may be required by the building regulations and the contract.
- This drawing is copyright and the property of T.L.A. and may not be copied, altered or reproduced in any way or used for a third party without the written consent.
- The architect's liability is limited to the obligations under the contract.
- T.L.A. is not responsible for any errors or omissions.

**PROPOSED**

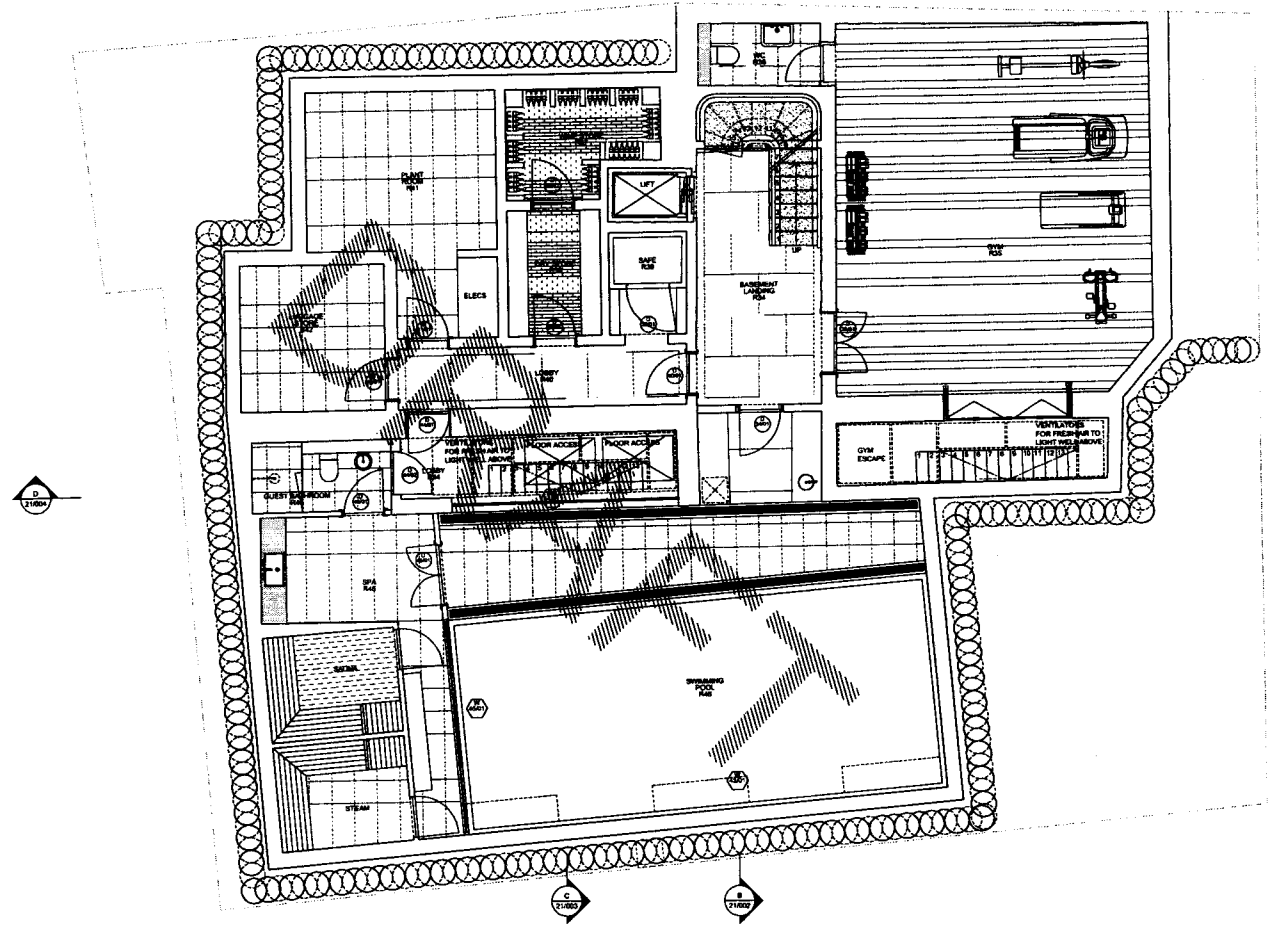

**PROPOSED BASEMENT PLAN - SCALE 1:50 @ A1 & 1:100 @ A3**



NO.	DATE	DESCRIPTION	DRAWN	CHECKED
01	12.12.10	DRAFT PLANNING DRAW	RJ	RL
02	21.11.10	REVISED	RJ	RL
03	18.07.11	ADDITION OF SCALE BAR	RJ	RL
04	18.07.11	ISSUED TO PLANNING CONSULTANT	RJ	RL
05	18.07.11	DESCRIPTION	RJ	RL

ADDRESS  
**9 PHENE STREET  
 LONDON SW3 5NY**

**PROPOSED  
 BASEMENT PLAN**

STATUS	PLANNING	DRAWN BY	RJ
SCALE	1:50 @ A1 & 1:100 @ A3	CHECKED BY	RW
DATE	JULY 2011	NO.	008
PROJECT NO.	R22 (20)	REV.	03


TREVOR | LAWRY ARCHITECTS

9 PHENE HOUSE  
 99 BROMFIELD ROAD  
 LONDON SE5 8QU  
 0207 464 0000  
 www.trevorlawry.co.uk  
 T +44(0)20 7737 6187  
 F +44(0)20 7726 0369


CLIENT  
 RAB PENSION TRUST

- TREVOR LAWRY ARCHITECTS
- Do not scale off the drawing, use figure dimensions only. All dimensions and levels to be provided on site. Customer must submit drawings to council to provide report of prior development and situation in TLA.
  - Issue only for purchase purposes.
  - This drawing is to be used for comparison only. It is not intended for construction and should not be used for any other purpose. It is not to be copied, altered or reproduced in any way without the prior written consent of Trevor Lawry Architects.
  - This drawing is copyright and the property of TLA and may not be copied, altered or reproduced in any way without the prior written consent of Trevor Lawry Architects.
  - The client accepts full responsibility for the accuracy of the information provided to the architect and for the accuracy of the drawings under the CD of regulation.
  - The architect does not accept any liability for the information provided by the client or for the accuracy of the drawings under the CD of regulation.
  - Drawings to be provided by the architect for TLA approval.
  - TLA is advised of drawings and will take responsibility.

PROPOSED

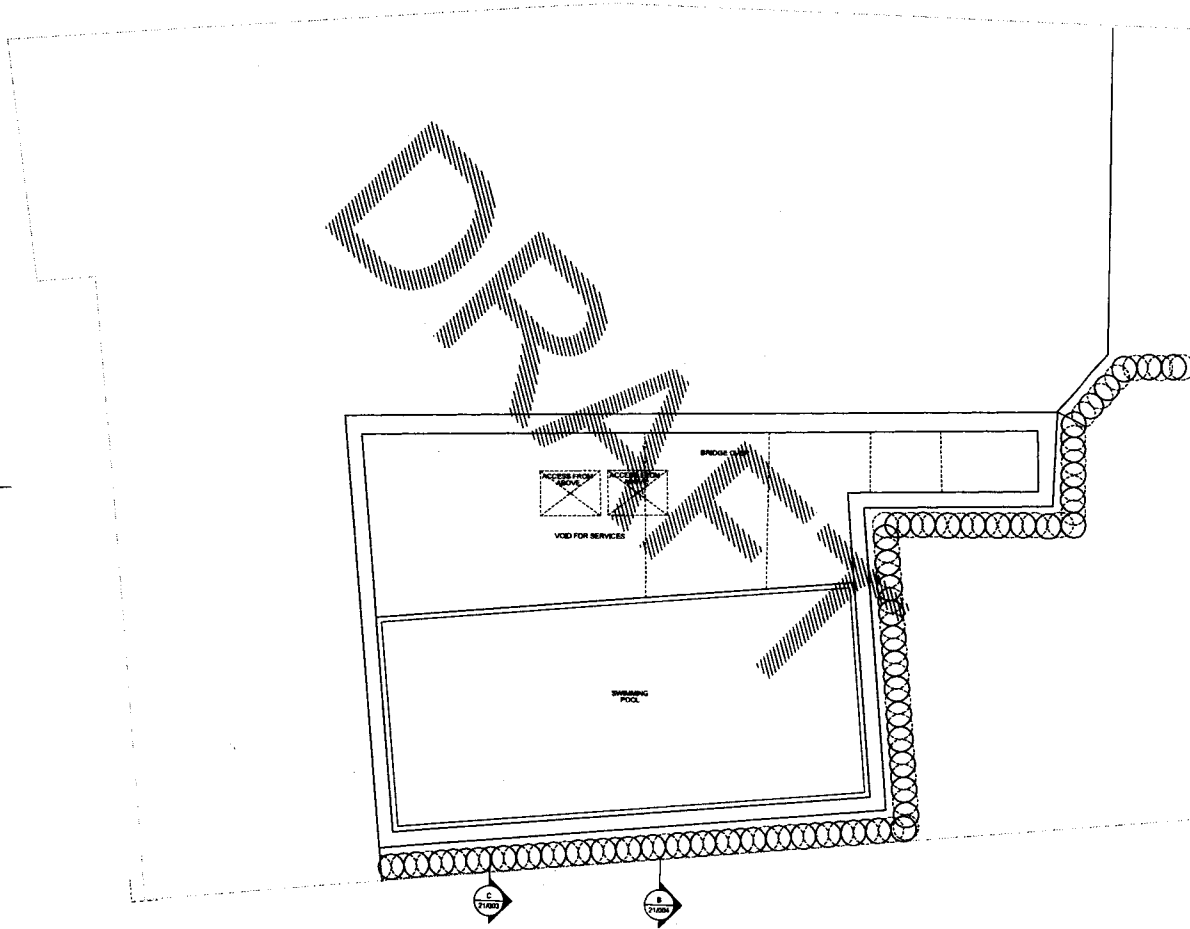

C 1/100  
 B 1/100

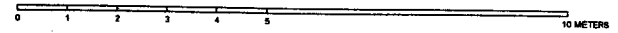

PROPOSED SUBBASEMENT PLAN - SCALE 1:50 @ A1 & 1:100 @ A3

REV	DATE	DESCRIPTION	DRAWN	CHECKED
PL1	20.12.10	DRAFT PLANNING DRAW	RJ	DM
PL2	21.11.10	REVISIONS	RJ	-
PL3	21.11.10	REVISIONS	RJ	-


ADDRESS  
 9 PHENE STREET  
 LONDON SW3 5NY

TITLE  
 PROPOSED  
 SUB BASEMENT PLAN

STATUS	PLANNING	DRAWN BY	RJ
SCALE	1:50@A1 & 1:100@A3	CHECKED BY	DM
DATE	JULY 2011	REV	007
PROJECT	822	(20)	007


Drawn



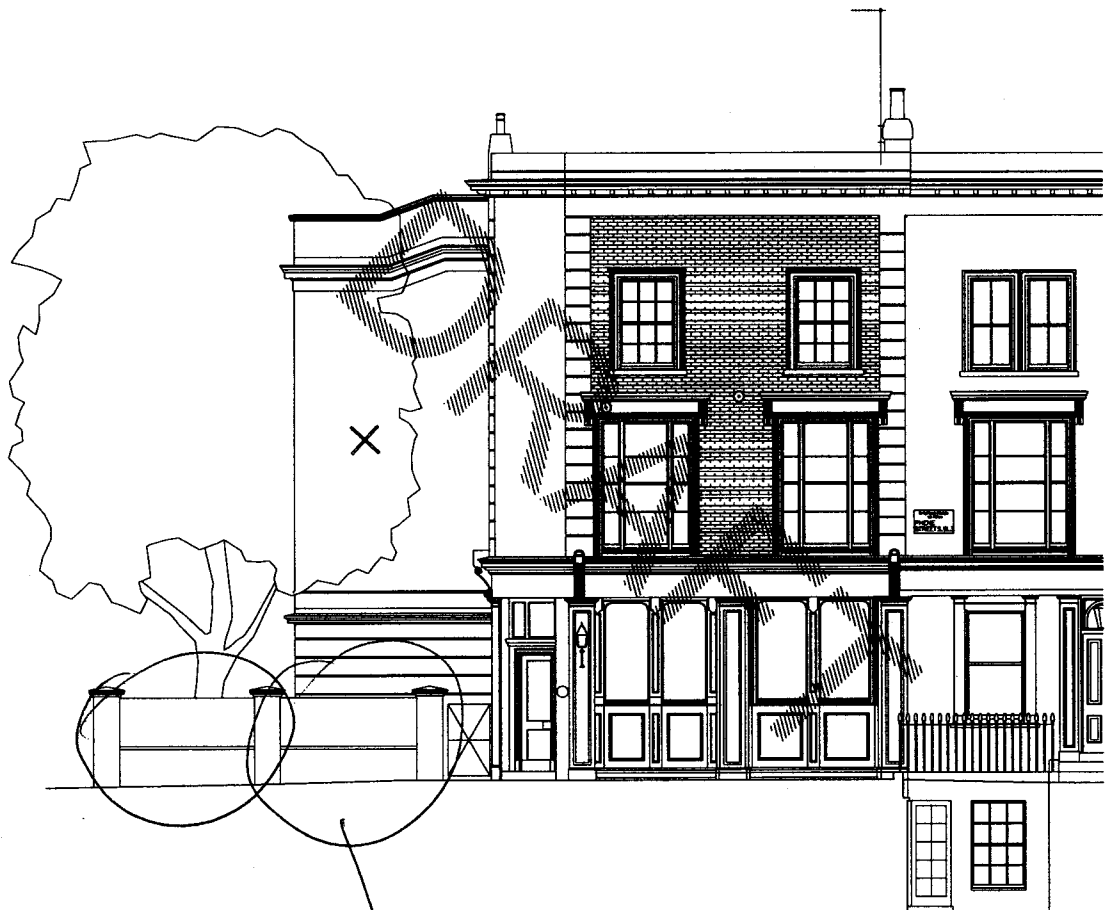

*Vanhuys*

EXISTING SOUTH EAST ELEVATION (PHENE STREET) - 1:50 @ A1 & 1:100 @ A3

 

TREVOR | LAWRY ARCHITECTS

gerrards house  
99 KINGSWAY ROAD  
LONDON W2 2JL  
design@trevorlawry.co.uk  
www.trevorlawry.co.uk  
T +44(0)20 7727 8181  
F +44(0)20 7328 0288

CLIENT  
RAB PENSION TRUST

- TREVOR LAWRY ARCHITECTS LTD
- Do not scale off this drawing, use figures dimensions, etc. All dimensions and levels to be given on this and other LRA drawings to be marked in red ink.
  - Issued only for purposes indicated.
  - This drawing is to be used in conjunction with conditions of sale and specifications.
  - This drawing is copyright of TLA and may not be copied, altered or reproduced in any way or passed to a third party without the written consent.
  - The main contractor should be advised of any necessary alterations under the CDM regulations.
  - The dimensions shown on this drawing have been based on the measurements provided by an independent survey company.

EXISTING



REVISIONS

NO.	DATE	DESCRIPTION	DATE	BY
P1	10/11/10	DRAFT PLANNING MARK		PL
P2	10/11/10	REVISIONS		PL
P3	11/11/10	REVISIONS		PL

ADDRESS  
9 PHENE STREET  
LONDON SW3 5NY

TITLE  
PROPOSED  
SOUTH EAST ELEVATION

SCALE	DATE	PROJECT NO.
1:50 @ A1	JULY 2011	822 (21)





*why is glass balustrade not more new?*

*is trellis acceptable here - worse railings be more appropriate?*

*door.*


**TREVOR LAMBY ARCHITECTS**  
 genuine house  
 18 Southwell Road  
 London SE5 8JU  
 www.trevorlambly.co.uk  
 t +44(0)20 7737 6181  
 f +44(0)20 7526 0369

- CLIENT**  
RAB PENSION TRUST
- TREVOR LAMBY ARCHITECTS**
**PROPOSED**

**Scale 1:50 @ A1 & 1:100 @ A3**

PROPOSED SOUTH WEST ELEVATION - SCALE 1:50 @ A1 & 1:100 @ A3

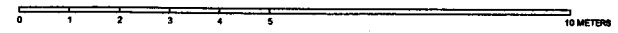

NO.	DATE	DESCRIPTION	BY	CHECKED
01	01/07/2011	CONCEPT PLAN	TJ	
02	01/07/2011	PROPOSED SOUTH WEST ELEVATION	TJ	
03	01/07/2011	PROPOSED SOUTH WEST ELEVATION	TJ	
04	01/07/2011	PROPOSED SOUTH WEST ELEVATION	TJ	

**PROJECT**  
9 PHENE STREET  
LONDON SW3 5NY

**SCALE**  
1:50 @ A1 & 1:100 @ A3


**DATE**  
JULY 2011

**PROJECT**  
02 (21)




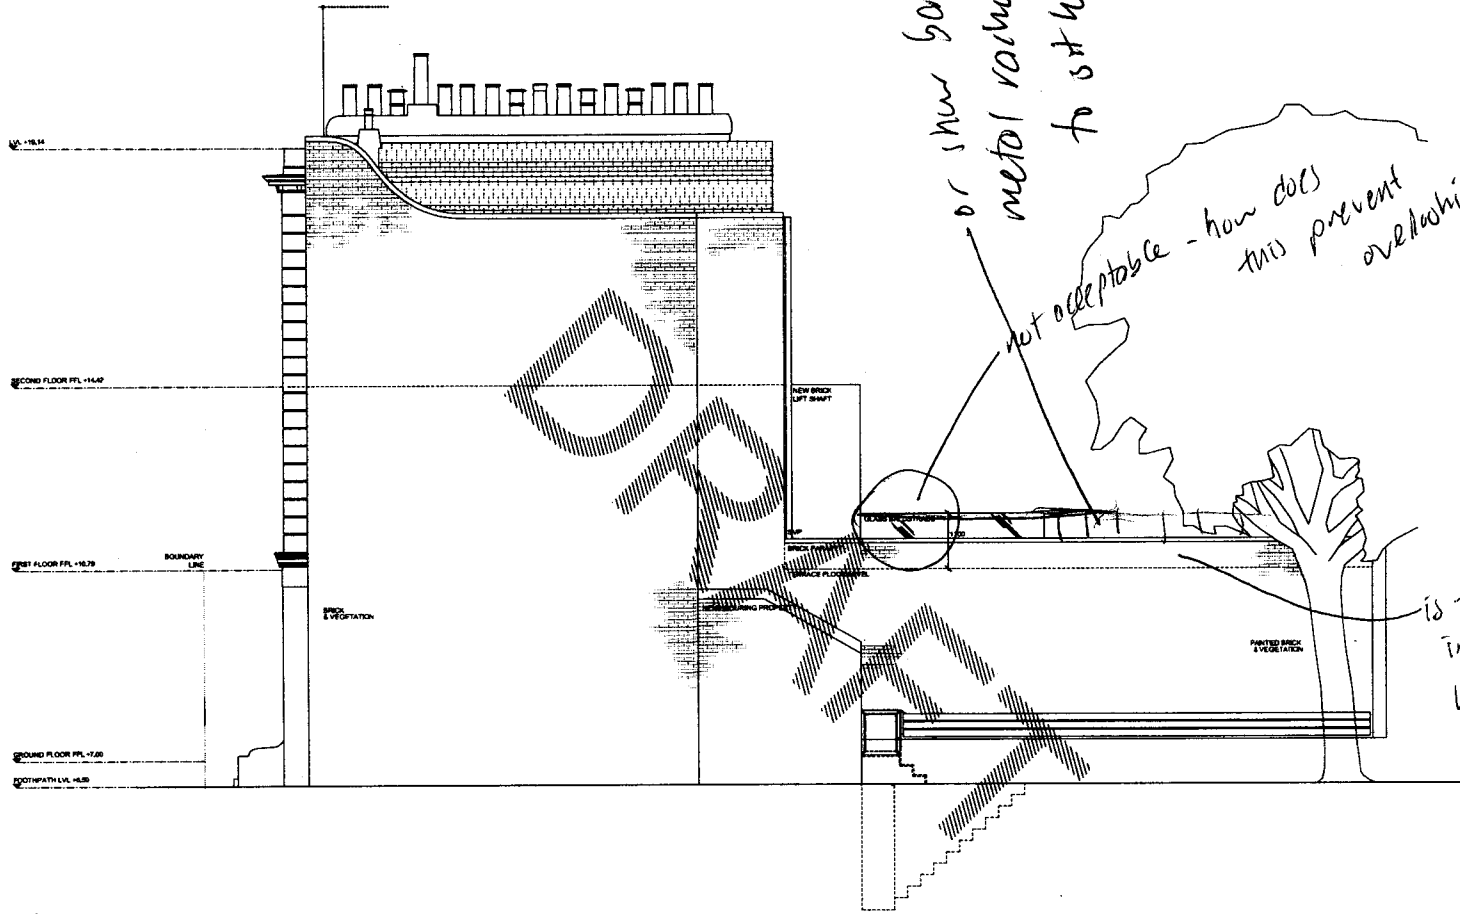

TREVOR | LAFF ARCHITECTS  
 Geneva House  
 99 Whitehall Road  
 London SE18 9QU  
 design@trevorlaff.co.uk  
 www.trevorlaff.co.uk  
 T +44(0)20 7737 6181  
 F +44(0)20 7328 0348

- CLIENT: RAB PENSION TRUST
- TREVOR LAFF ARCHITECTS
- Do not scale off this drawing, use figure dimensions only. All dimensions are metric in millimetres unless otherwise stated. Contractors must submit a detailed list of proposed materials and finishes to the Client for approval.
  - Issues only for permission to build.
  - The drawing is copyright and the property of TLA and may not be copied, altered or reproduced in any way or used in a third party without our written consent.
  - The main contractor should be consulted with the architect regarding any changes to the design.
  - The dimensions shown on this drawing shall be based on the measurements provided by an approved surveyor.
  - Examples to be provided by main contractor to TLA approval.
  - TLA is not responsible for drawings and not able to monitor.

PROPOSED

Revised Date:

REV	DATE	DESCRIPTION	DATE	BY	CHK
01		ISSUE FOR PERMITS			
02		ISSUE FOR PERMITS			
Address:  
 9 PHENE STREET  
 LONDON SW3 5NY

9 PHENE STREET  
 LONDON SW3 5NY

EXISTING NORTH EAST ELEVATION

STATUS: PLANNING

SCALE: 1:50 @ A1 & 1:100 @ A3

DATE: JULY 2011

PROJECT: 022 (21)


DESIGNED BY: JH

CHECKED BY: JH

DATE: 007

REV: PS

EXISTING NORTH EAST ELEVATION - SCALE 1:50 @ A1 & 1:100 @ A3

 

CLIENT: RAG PENSION TRUST

- TRIVOR | LAWRY ARCHITECTS
PROPOSED

SPECIFIC NOTES

NO.	DATE	DESCRIPTION	BY	CHKD
1	15.11.11	CONCEPT DESIGN	TL	TL
2	15.11.11	REVISIONS	TL	TL


ADDRESS: 9 FINE STREET LONDON SW3 5NY

VIEW: PROPOSED SECTION CC




EXISTING WINDOWS

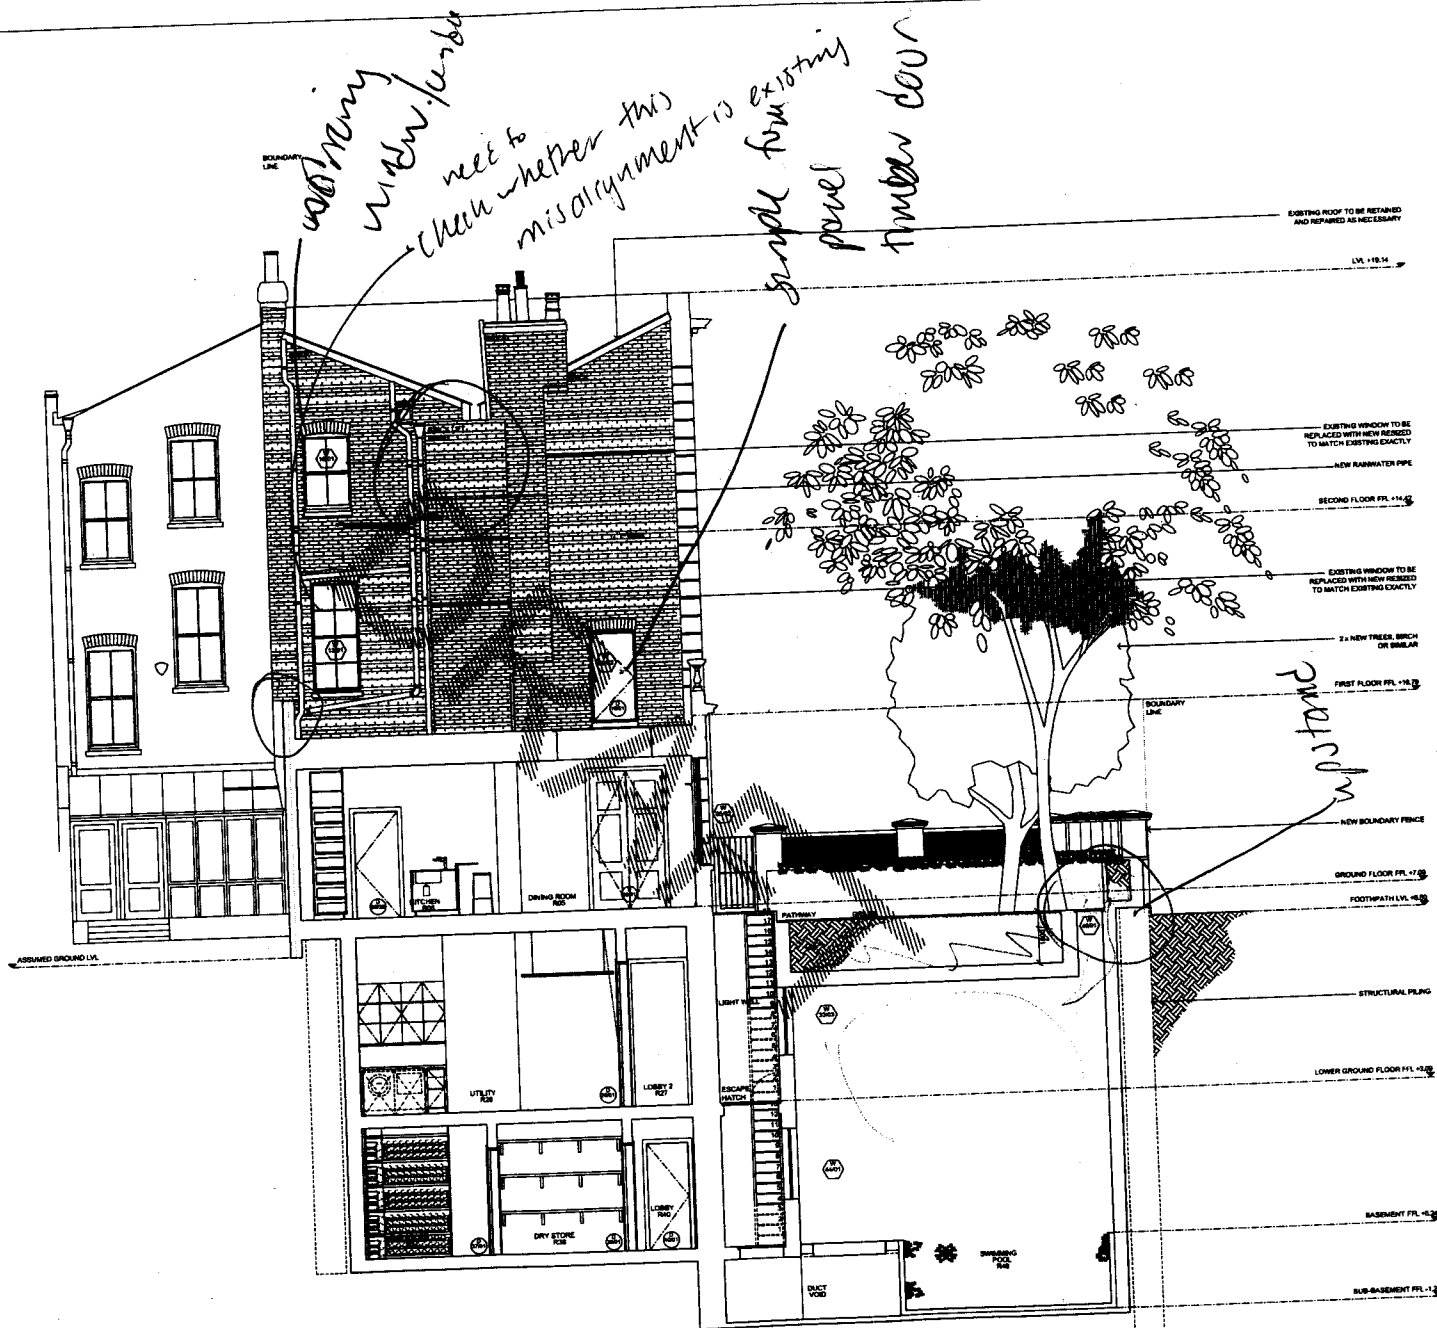

PROPOSED SECTION CC - SCALE 1:50 @ A1 & 1:100 @ A3

TREVOR | LAWRY ARCHITECTS

genesis house  
 99 BISHOPSLADE ROAD  
 LONDON SE5 8QU  
 design@trevorlawry.co.uk  
 www.trevorlawry.co.uk  
 T +44(0)20 7737 6181  
 F +44(0)20 7328 0348

CLIENT  
**RAB PENSION TRUST**

- TREVOR LAWRY ARCHITECTS
1. Do not scale off this drawing, use the grid dimensions only. All dimensions are based on the finished or 'in-situ' condition unless otherwise stated. It is subject to the prevailing rules of architectural practice and standards in the UK.
  2. Issues only for paper production.
  3. This drawing is for information only and does not constitute a contract. It is subject to the prevailing rules of architectural practice and standards in the UK. It is not to be used for any other purpose without the written consent of Trevor Lawry Architects.
  4. This drawing is copyright and the property of TLA and may not be copied, stored or transmitted in any way or format in this form without the written consent of Trevor Lawry Architects.
  5. The architect should be consulted with the relevant authorities prior to any construction.
  6. Any alterations to this drawing must be made on the amendments provided by an independent architect.
  7. Samples to be provided by each supplier to TLA approval.
  8. TLA to approve all drawings and sets with seal to architect.

**PROPOSED**

Scale: 1:50 @ A1 & 1:100 @ A3

NO.	DATE	DESCRIPTION	BY	CHECKED

PROJ.	9 PHENE STREET
PLN.	PROPOSED SECTION DD
REV.	
DATE	
ADDRESS	9 PHENE STREET LONDON SW3 5NY


TITLE  
**PROPOSED SECTION DD**

STATUS	PLANNING	DESIGNED BY	RU
SCALE	1:50 @ A1 & 1:100 @ A3	CHECKED BY	RW
DATE	JULY 2011	DATE	
PROJECT NO.	B22	(21)	DDA



*for paper format.*

*bela broke*

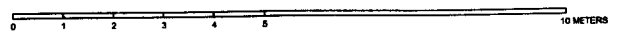

**PROPOSED SECTION DD - SCALE 1:50 @ A1 & 1:100 @ A3**

**CLIENT**  
 RAB PENSION TRUST


**TREVOR LAWFF ARCHITECTS LTD**

1. We hold each of the drawings, and approve drawings only, the client remains responsible for the use and the accuracy of the information on which they are based.
2. We are not responsible for any errors or omissions in the drawings.
3. The drawings to be used in connection with the building must be approved by the client.
4. The drawings to be approved by the client must not be used for any other purpose than that for which they were prepared.


**PROPOSED**

**SPECIFIC NOTES**

*upstone planted wall in M*

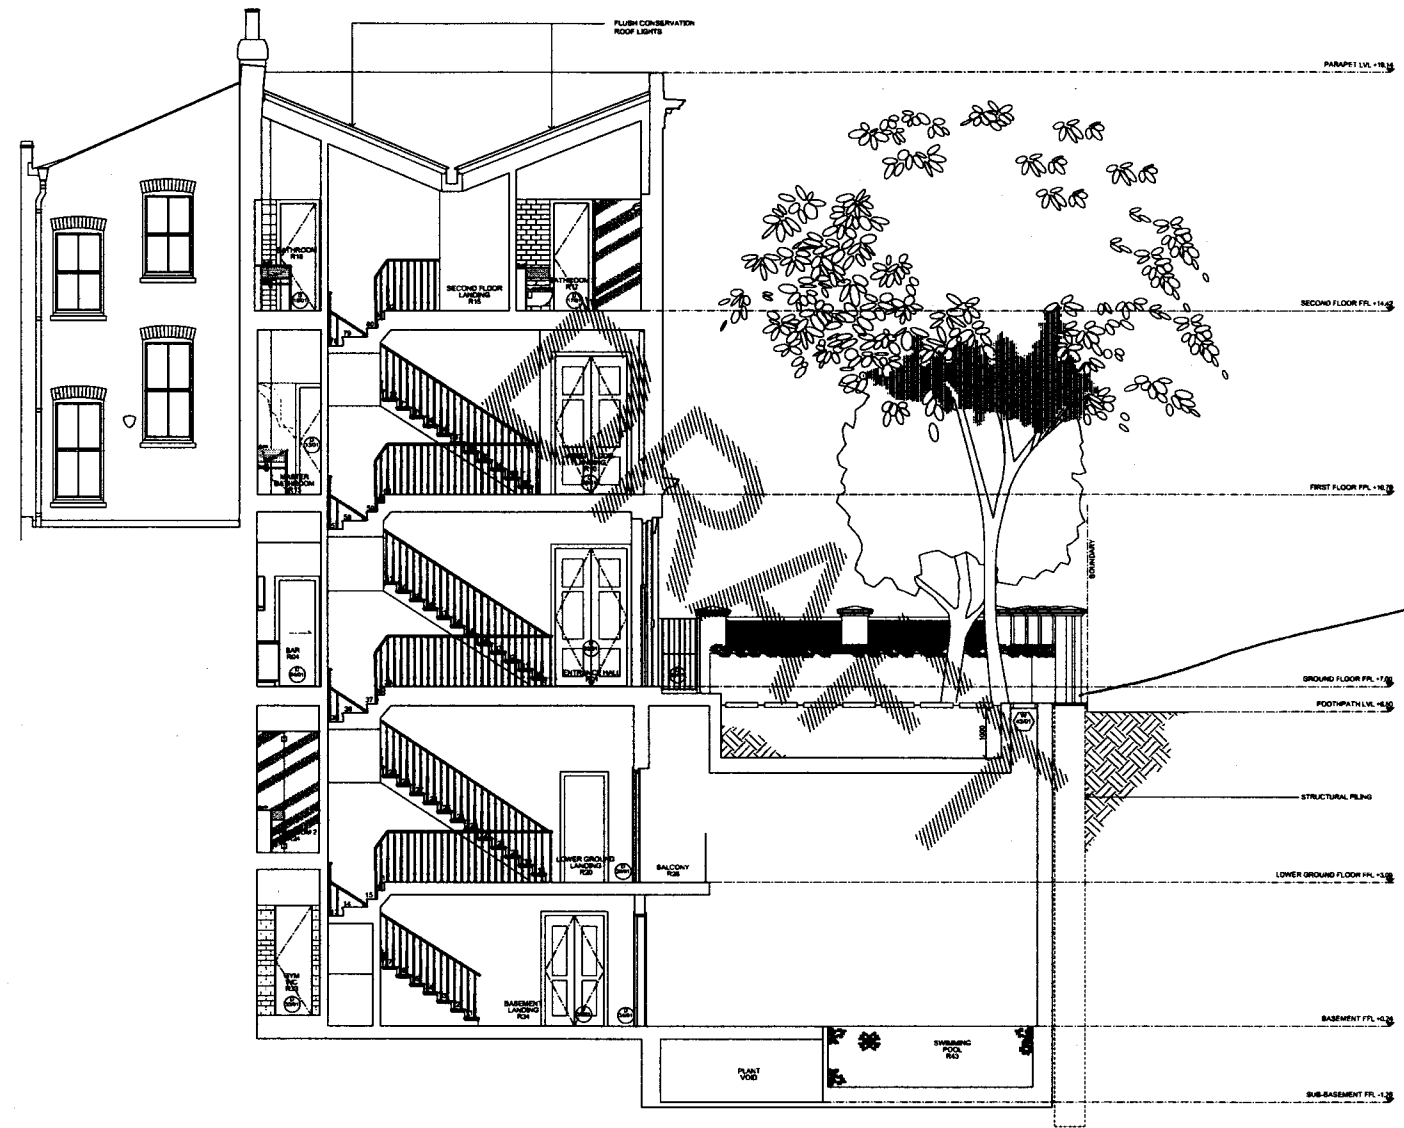

PROPOSED SECTION BB - SCALE 1:50 @ A1 & 1:100 @ A3

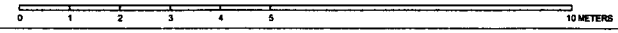

REV	DATE	DESCRIPTION	OWN/CHKD
02	21.11	CONFT PLANNING SUBM	RJ
01	11.11.10	PERMISSIONS	RJ
00	12.10	ADDITION OF SCALE BAR	RJ
00	11.10	ISSUED TO PLANNING CONSULTANT	RJ

ADDRESS  
**9 PHENE STREET  
 LONDON SW3 5NY**

TITLE  
**PROPOSED SECTION BB**

STAGE	PLANNING	DESIGNED BY	RJ
SCALE	1:50@A1 & 1:100@A3	CHECKED BY	RJW
DATE	JULY 2011	DATE	REV
PROJECT NO.	622 (21)	002	P5