


PP/11/2421/rev A.

**TREVOR | LAWRENCE ARCHITECTS**  
 Geneva House  
 89 St Pauls Church Road  
 London SE16 5JQ  
 taylor@trevorl.co.uk  
 www.trevorl.co.uk  
 T +44(0)20 7337 6181  
 F +44(0)20 7336 0249

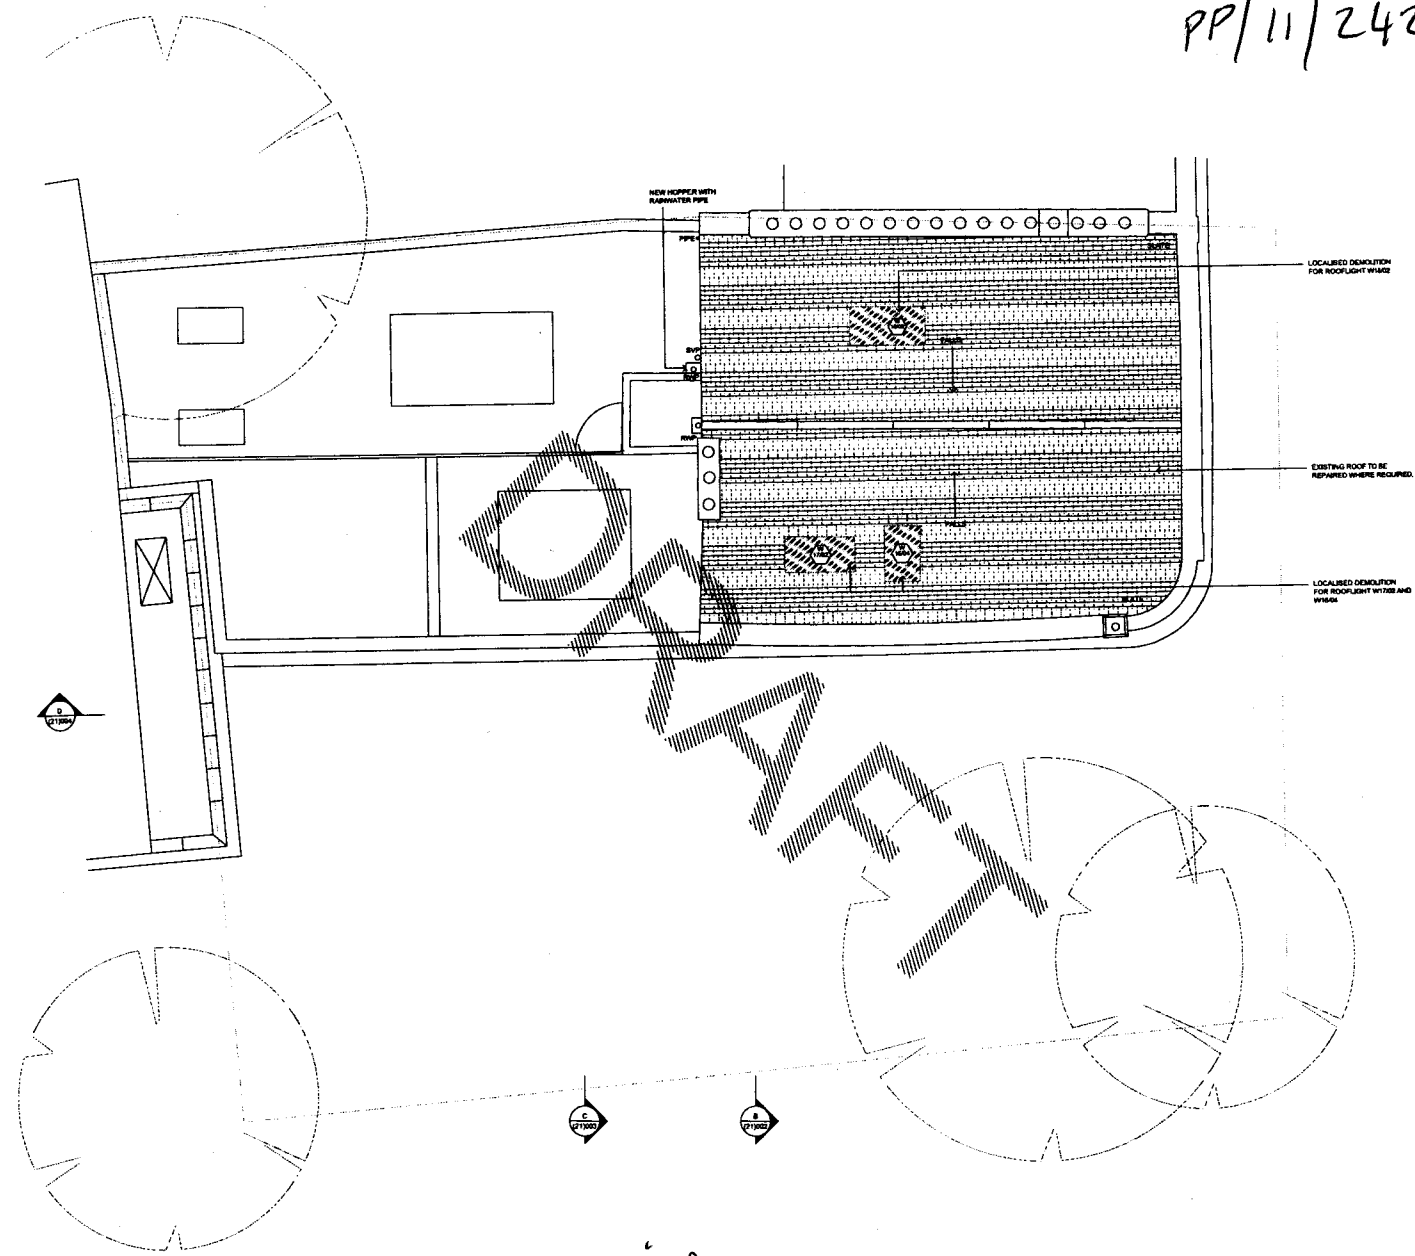

CLIENT: **RAB PENSION TRUST**

THE TREVOR LAWRENCE ARCHITECTS


**PROPOSED**

SPECIFIC NOTES:

REV	DATE	DESCRIPTION	BY	CHK
01	05/11/11	DRAFT PLANNING PERMIT	AL	AL
02	06/11/11	REVISIONS	AL	AL
03	11/11/11	REVISIONS	AL	AL

ADDRESS:

9 PHENE STREET  
 LONDON SW3 5NY

TITLE: **ROOF DEMOLITION PLAN**

DATE: PLANNING	DESIGN BY: RL
SCALE: 1:50 @ A1	CHECKED BY:
DATE: JULY 2011	DATE: 001
PROJECT:	REV: P3

*confirm  
 permit  
 free.*

*Also need to look at S106 contribution.*

*All received 02/12/11*



TREVOR LAMB ARCHITECTS


garage house  
89 bracknell road  
london SE25 8QU  
design@trevorlamb.co.uk  
www.trevorlamb.co.uk  
T +44(0)20 7737 8181  
F +44(0)20 7326 0348

CLIENT  
**RAB PENSION TRUST**

- TREVOR LAMB ARCHITECTS

**PROPOSED**

PROPOSED

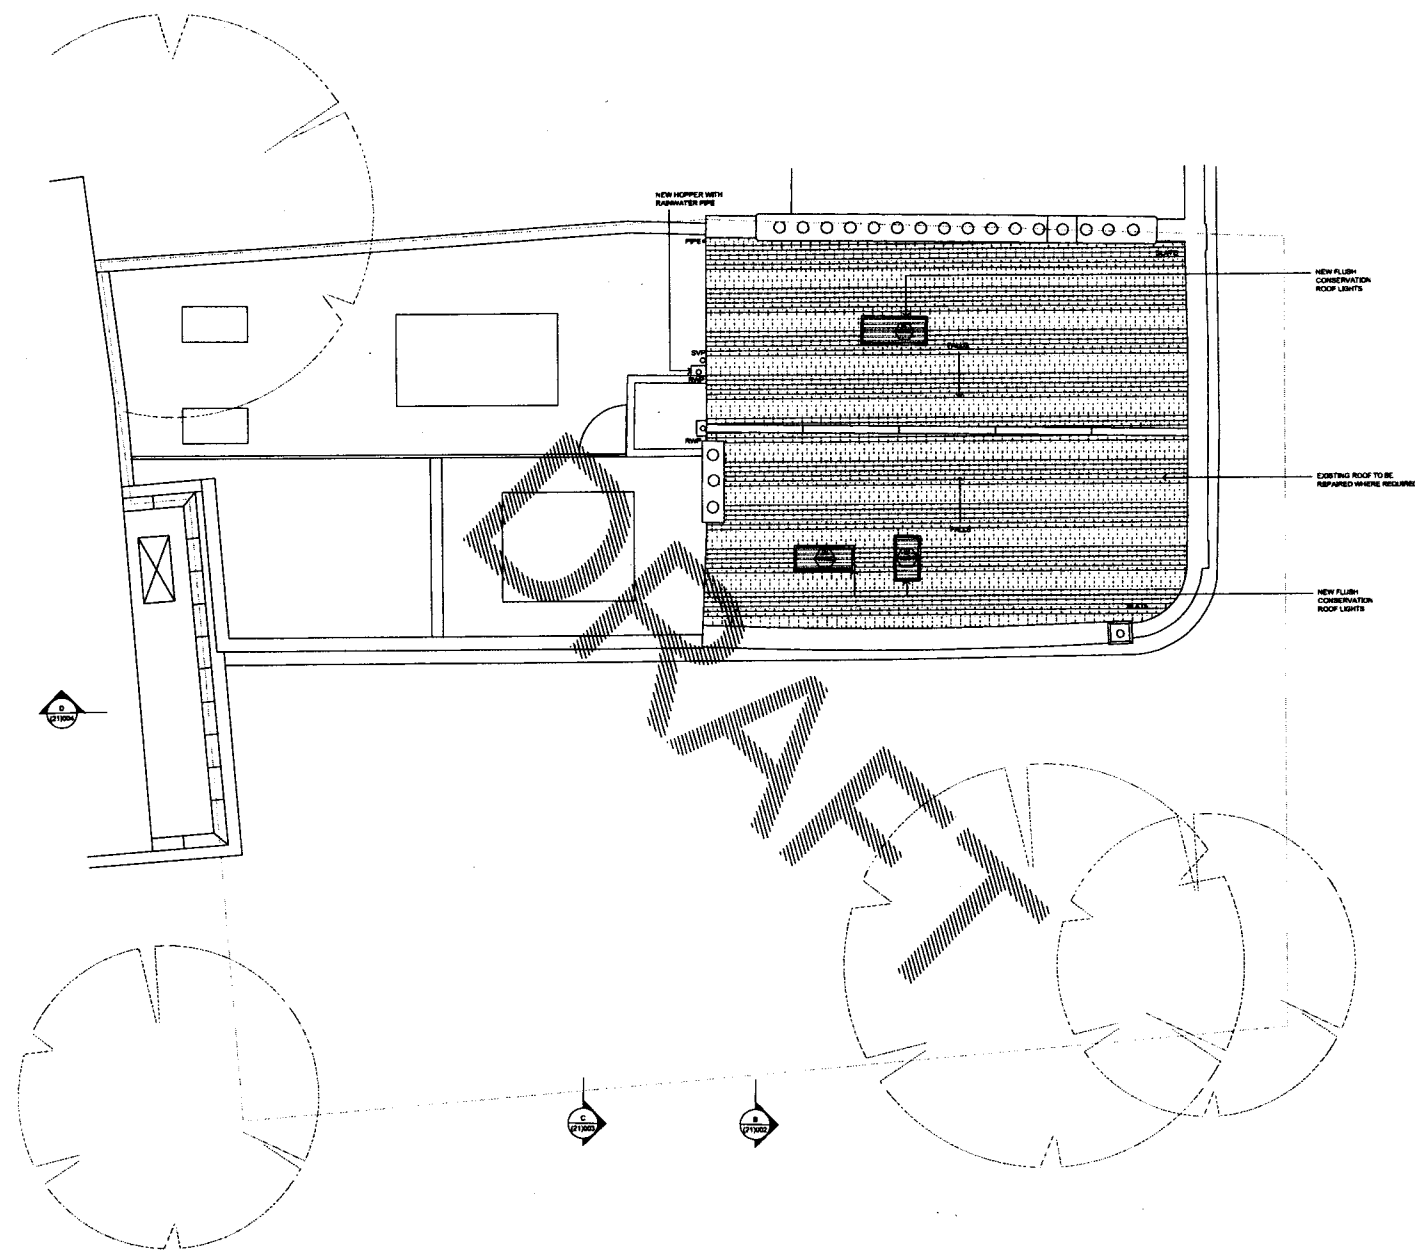

REV	DATE	DESCRIPTION	BY	CHK
01		ISSUE FOR DRAFT PLANNING		
02		REVISION		
03		REVISION		

9 PHENE STREET  
LONDON SW3 5NY

**PROPOSED ROOF PLAN**

STATUS	PLANNING	DATE	004
SCALE	1:50 @ A1	DESIGNED BY	RL
DATE	JULY 2011	CHECKED BY	RL
PROJECT		NO.	004



PROPOSED ROOF PLAN - SCALE 1:50 @ A1 & 1:100 @ A3



CLIENT  
**RAB PENSION TRUST**

TREVOR LANGFORD ARCHITECTS


**PROPOSED**

SPECIFIC NOTES

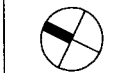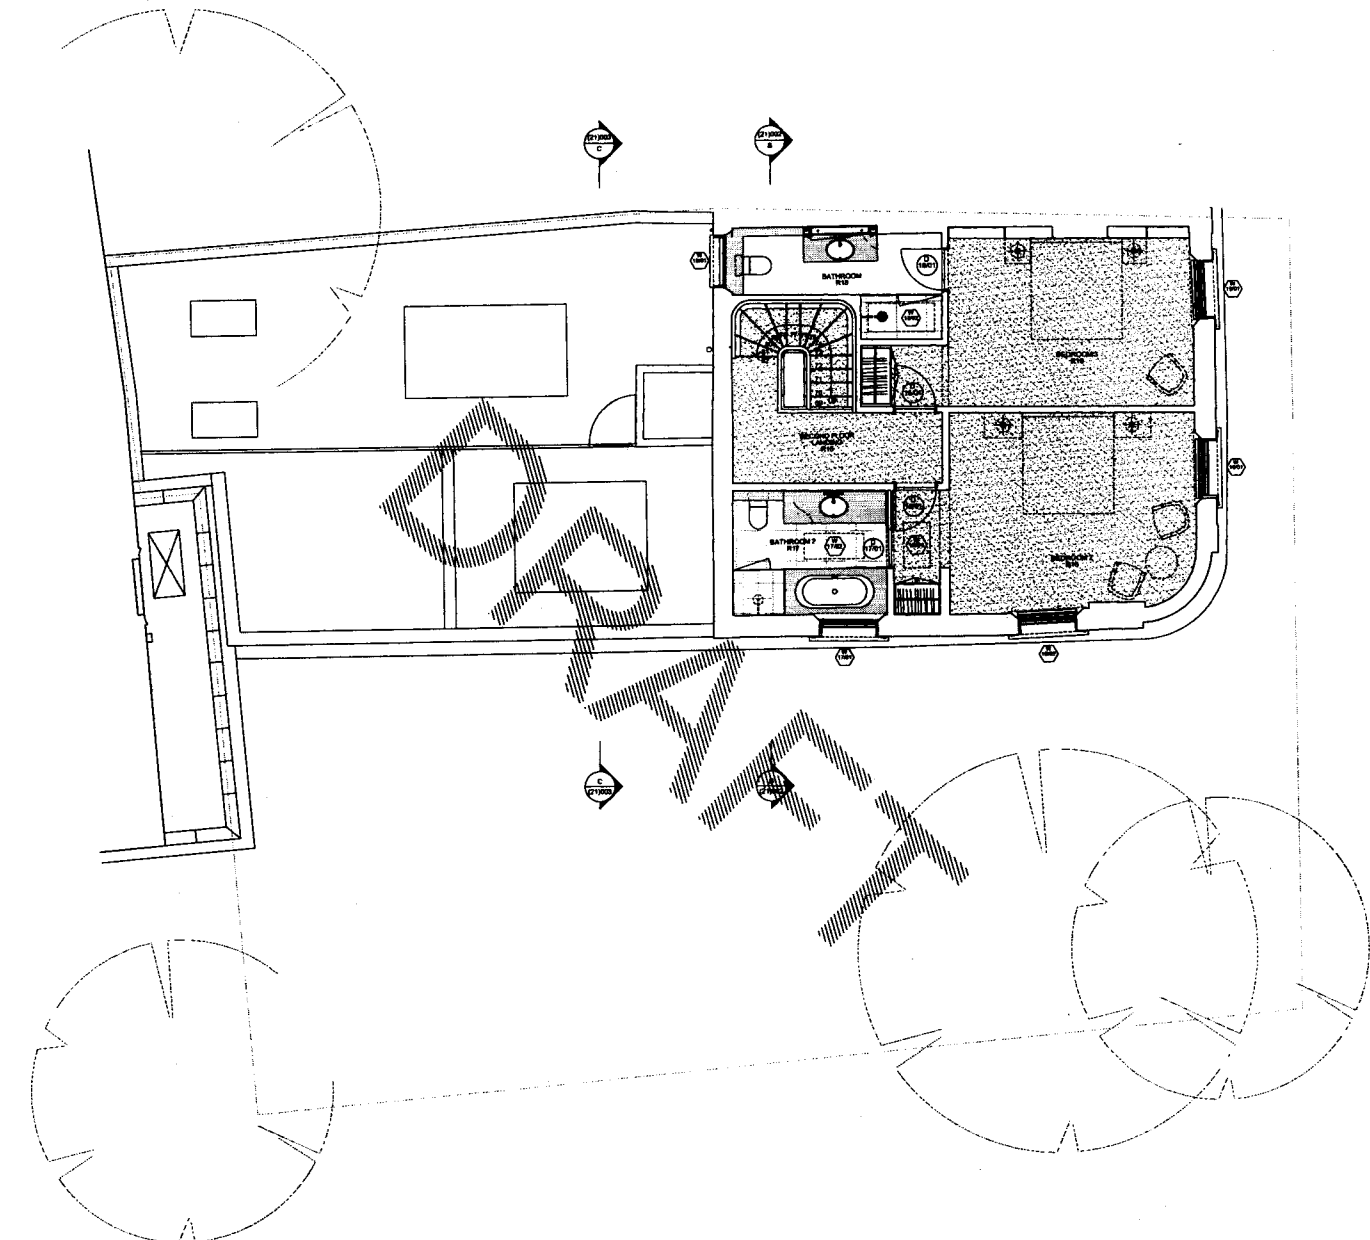

PROPOSED SECOND FLOOR PLAN - 1:50 @ A1 & 1:100 @ A3

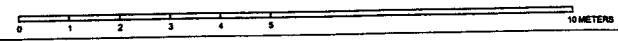


NO.	DATE	DESCRIPTION	BY	CHKD
01				
02				
03				
04				
05				
06				
07				
08				
09				
10				


PROJECT  
**8 PHENE STREET  
 LONDON SW3 5NY**

TITLE  
**PROPOSED SECOND FLOOR PLAN**

STATUS	PLANNING	DATE	
SCALE	1:50 @ A1 & 1:100 @ A3	DESIGNED BY	RLW
DATE	JULY 2011	CHKD	RLW
PROJECT	822 (20)	NO.	003

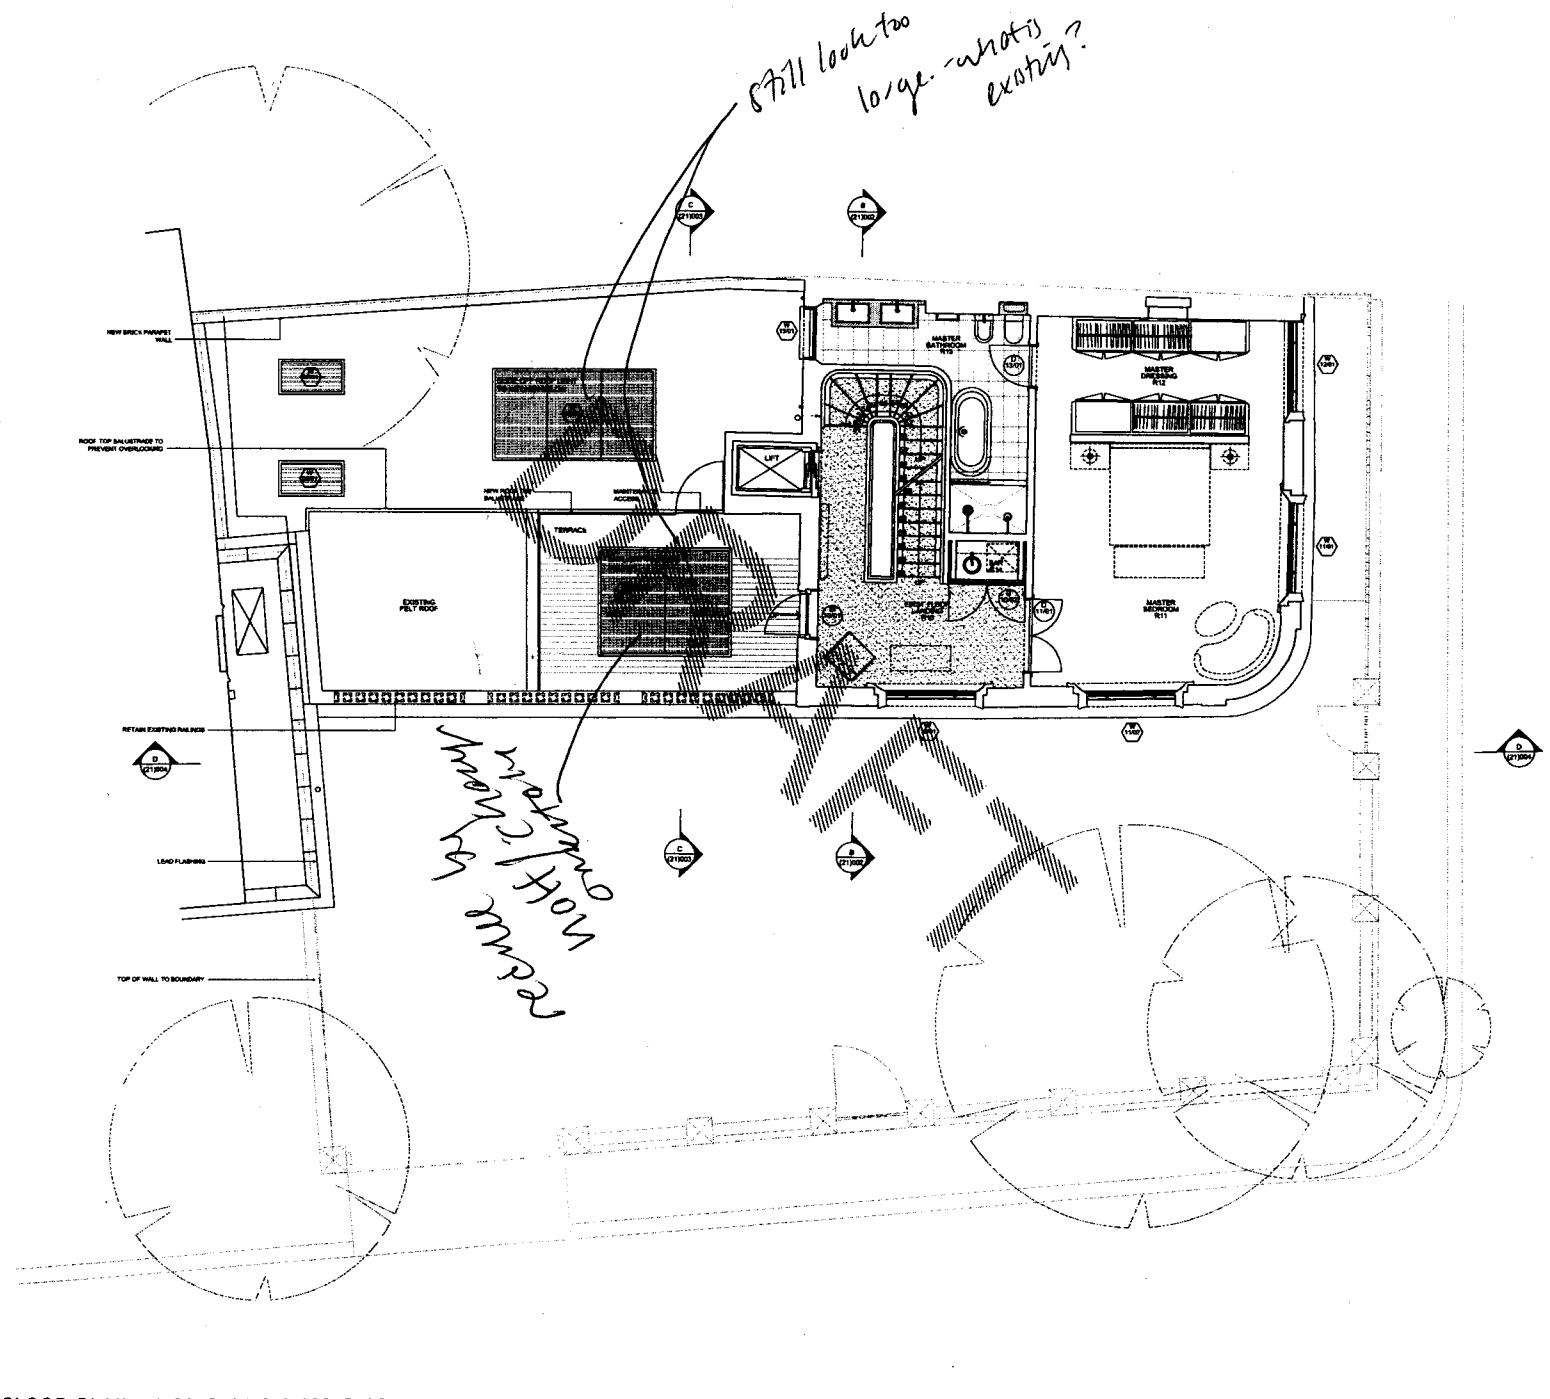

PROPOSED FIRST FLOOR PLAN - 1:50 @ A1 & 1:100 @ A3

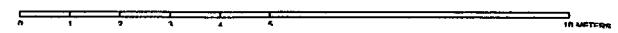

**TREVOR LAMPY ARCHITECTS**  
 general house  
 98 BRACKENHILL ROAD  
 LONDON SE5 9DU  
 design@trevorlumpy.co.uk  
 www.trevorlumpy.co.uk  
 T +44(0)20 7737 6181  
 F +44(0)20 7328 0348

- CLIENT: **RAB PENSION TRUST**
- TREVOR LAMPY ARCHITECTS
1. Do not scale off this drawing, use printed dimensions only. All dimensions and levels to be dimensioned to Contractor unless otherwise indicated. Builders obliged to comply with local and national building regulations and standards.
  2. This drawing is for contract reference.
  3. This drawing is to be made in conjunction with structural drawings and specifications before proceeding with construction. All dimensions and levels to be dimensioned to Contractor unless otherwise indicated. Builders obliged to comply with local and national building regulations and standards.
  4. This drawing is copyright and sale proceeds of TLA and the drawings herein, shall be returned to the author or destroyed if it is used in any other way without the author's consent.
  5. The design contained herein is for contract with the relevant authorities under the CDM regulations.
  6. The drawings shown on this drawing have been issued on the assumption provided by or intended for the client's use.
  7. Revision to be provided by the author for TLA approval.
  8. TLA to approve all drawings and issue site to construction.

**PROPOSED**

SPECIFIC NOTES

PS	RELEVANT DRAFT PLANNING INFO	PL	RF
PL	20.11.11	REVISIONS	PL
REV	DATE	DESCRIPTION	DRAWN/CAD
ADDRESS			
9 PHENE STREET LONDON SW3 5NY			
TITLE			
PROPOSED FIRST FLOOR PLAN			
STATUS	PLANNING	DESIGNED BY	RLJ
SCALE	1:50@A1 & 1:100@A3	CHECKED BY	RW
DATE	JULY 2011	DATE	REV
PROJECT	822	(20)	PS



VIEW OF THE EXISTING TREES & NEIGHBORING PROPERTY




VIEW OF THE EXISTING BUILDING

*amend slightly size*

*Unoccupied in residential street*  
*new area on top of existing solid.*

*water ramp this way*

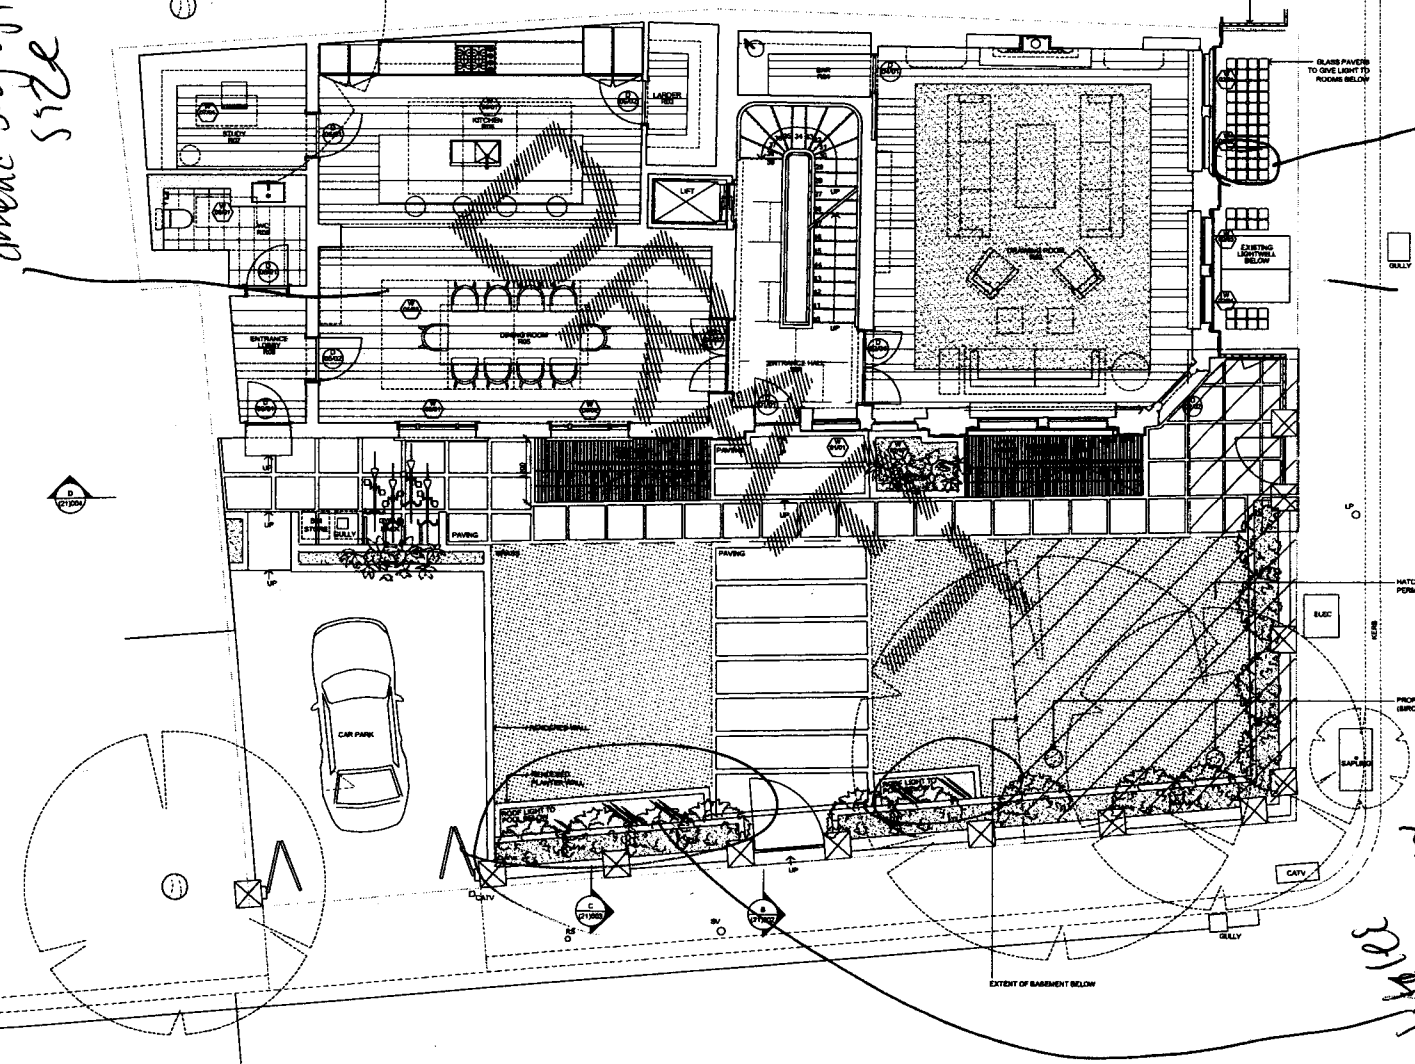

**TRIVOR | LAWRY ARCHITECTS**  
 genesis house  
 99 Strand Street East  
 London SE5 8QU  
 design@trivora.com.uk  
 www.trivora.com.uk  
 T +44(0)20 7737 6191  
 F +44(0)20 7326 0349

- CLIENT** RAB PENSION TRUST
- TRIVOR | LAWRY ARCHITECTS**
- On receipt of the drawings, we shall deliver only if all drawings are found to be correct on site. Client's employer shall remain liable to properly report all on-site observations and actions to TLA.
  - Revised only for project inclusion.
  - The drawings are to be used in conjunction with the contract and specifications. No liability shall be accepted for any consequences arising from any use of the drawings for purposes other than those intended by the client.
  - The drawings are not to be used for any other purpose without the prior written consent of Trivor | Lawry Architects.
  - The drawings are made in accordance with the statutory obligations under the CD Act regulations.
  - TLA is not liable for any delay or cost increase.

**PROPOSED**

**SPECIFIC NOTES**

- HATCHED AREA INDICATES 10% PERMISSIBLE AREA OF SITE FOR DRAINAGE
- PROPOSED TREES (BIRCH OR SIMILAR)

NO.	DATE	DESCRIPTION	DRAWN BY
01	02.11.11	DRIFT PLANNING ONLY	PL
02	03.11.11	REVISIONS	PL

**9 PHENE STREET  
 LONDON SW3 5NY**


**PROPOSED GROUND FLOOR PLAN**

STATUS	PLANNING	CLIENT
DATE	1.00.01	1.1.00.03
SCALE	1:50 @ A1	1:100 @ A3
DATE	JULY 2011	
PROJECT	822	(20)

**PROPOSED GROUND FLOOR PLAN - SCALE 1:50 @ A1 & 1:100 @ A3**



*not acceptable  
ventilation/outlook  
light.*

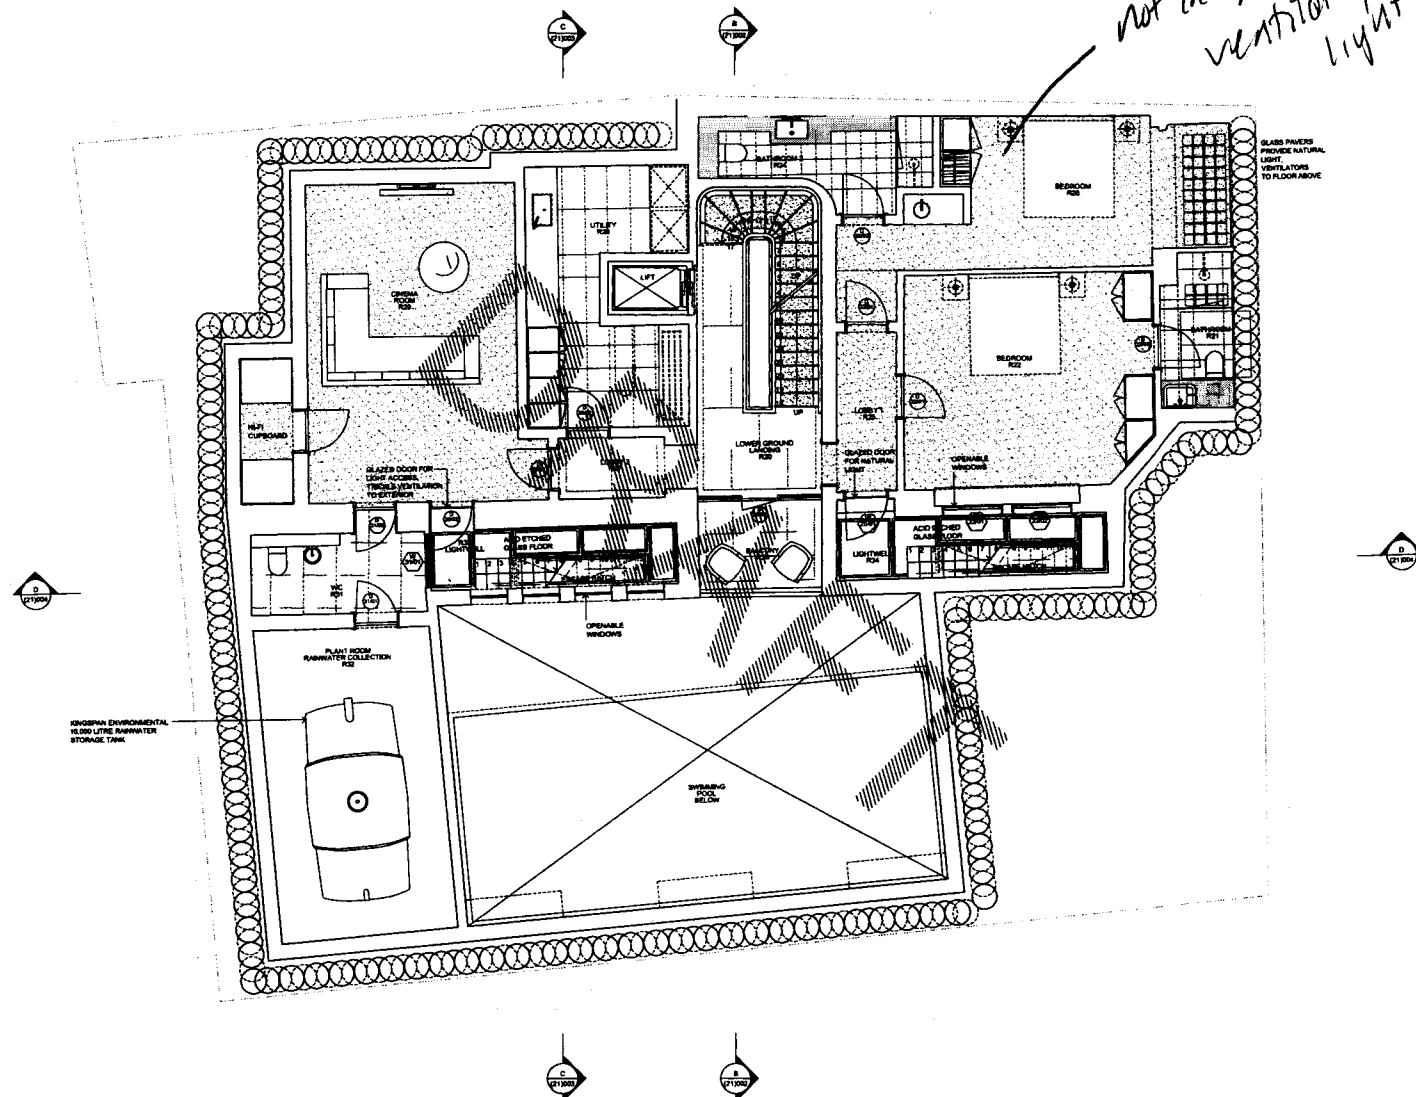

- CLIENT**  
RAB PENSION TRUST
- TREVOR | LANEY ARCHITECTS**
- Do not make any alterations, use fixed furniture, etc. All alterations are to be approved by the Client under a written agreement to be signed by a properly qualified structural engineer and submitted to TLA.
  - Should only be prepared for purposes stated.
  - The drawings are to be used for information only. They do not constitute a contract and are not to be used for any other purpose without the written consent of Trevor Laneys Architects.
  - The drawings are copyright and the property of TLA and may not be copied, altered or reproduced in any way without the prior written consent of Trevor Laneys Architects.
  - The main contractor should be consulted with the necessary approvals under the CDM regulations.
  - The drawings shown on this drawing have been issued as the measurements provided by an independent survey company.
  - Examples to be provided by main contractor for TLA approval.
  - Not responsible for drawings and details to be provided.

**PROPOSED**

SPECIFIC NOTES


REV	DATE	DESCRIPTION	DRAWN	CHECKED
01	01.11.11	ISSUE FOR PERMITS	AL	AL
02	01.11.11	REVISIONS	AL	AL
03	01.11.11	ADDITION OF SCALE BAR	AL	AL
04	01.11.11	ISSUE TO CLIENT FOR PLANNING CONSULTATION	AL	AL
05	01.11.11	DATE OF ISSUE TO PLANNING CONSULTANT	AL	AL

9 PHENE STREET  
LONDON SW3

**PROPOSED LOWER GROUND FLOOR PLAN**

STATUS	PLANNING	THD
SCALE	1:50 @ A1 & 1:100 @ A3	CHECKED BY
DATE	JULY 2011	DATE
PROJECT NO.	R22 (20)	005

PROPOSED LOWER GROUND FLOOR PLAN - SCALE 1:50 @ A1 & 1:100 @ A3

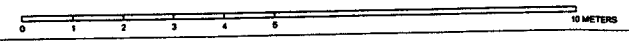


CLIENT  
**RAB PENSION TRUST**

TREVOR LAMPY ARCHITECTS

- Do not scale off this drawing, use figure dimensions and all dimensions are based on the centre of walls. Dimensions shown in brackets indicate a preferred or alternative dimension. Dimensions shown in brackets indicate a preferred or alternative dimension.
- Issued only for purposes intended.
- This drawing is to be used in conjunction with the drawings and specifications issued in connection with the contract. It is not to be used for any other purpose without the written consent of the architect.
- This drawing is copyright and the property of T.L.A. and may not be copied, altered or reproduced in any way or used for a third party without the written consent of the architect.
- The architect's liability is limited to the obligations under the CDM regulations.
- The architect's liability is limited to the obligations under the CDM regulations.
- Liability is limited to the obligations under the CDM regulations.
- T.L.A. is not responsible for any errors or omissions.

**PROPOSED**

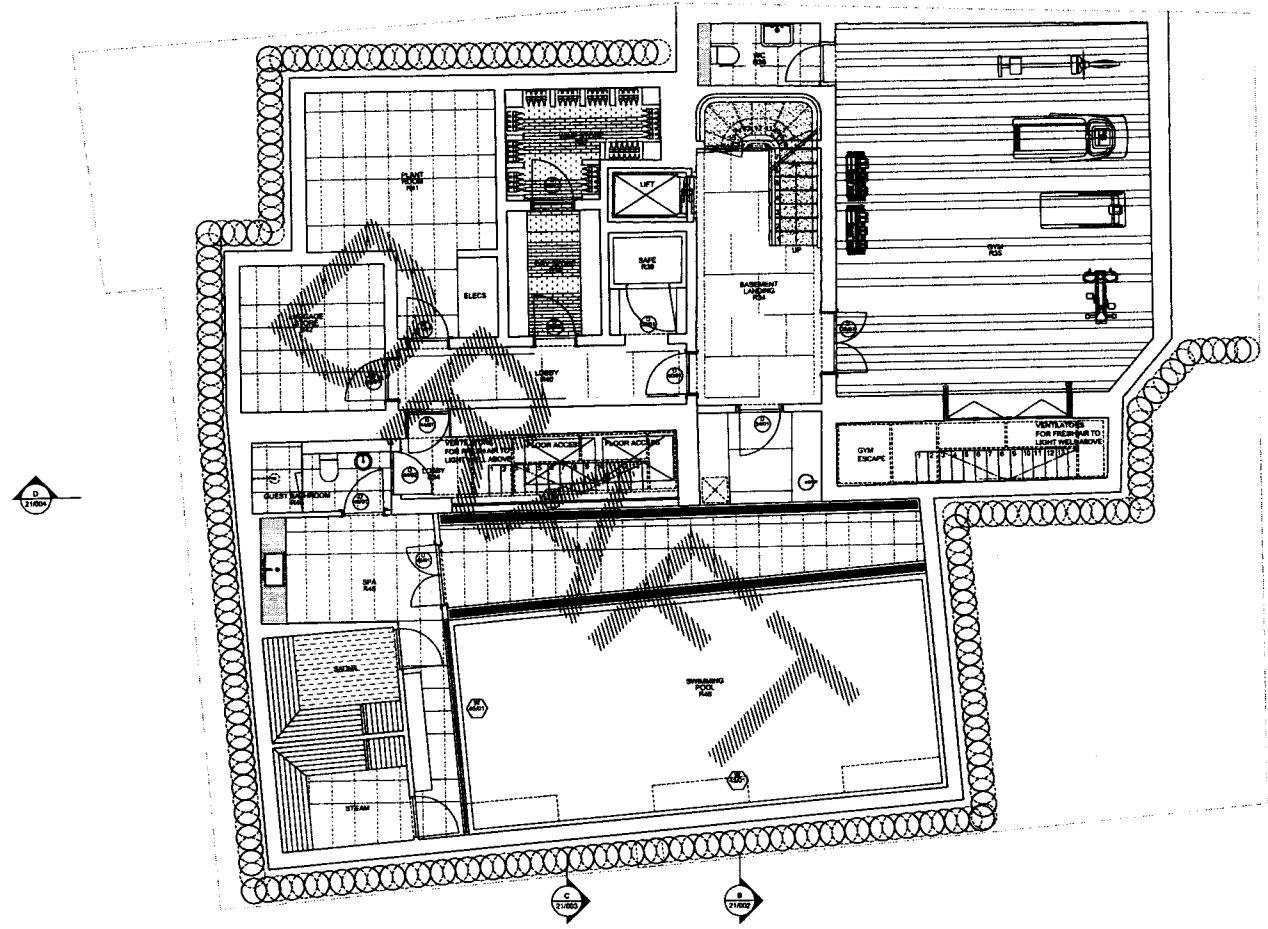

**PROPOSED BASEMENT PLAN - SCALE 1:50 @ A1 & 1:100 @ A3**



NO.	DATE	DESCRIPTION	DRAWN	CHECKED
01	12.12.10	DRAFT PLANNING DRAW	RJ	RL
02	21.11.10	REVISION	RJ	RL
03	16.07.11	ADDITION OF SCALE BAR	RJ	RL
04	16.07.11	ISSUED TO PLANNING CONSULTANT	RJ	RL
05	16.07.11	DESCRIPTION	RJ	RL

ADDRESS  
**9 PHENE STREET  
 LONDON SW3 5NY**

TITLE  
**PROPOSED  
 BASEMENT PLAN**

STATUS	PLANNING	OWNER	RJ
SCALE	1:50 @ A1 & 1:100 @ A3	CHECKED BY	RW
DATE	JULY 2011	NO.	008
PROJECT NO.	R22 (20)	REV.	03




TREVOR LAMER ARCHITECTS

T +44(0)20 7737 6187  
F +44(0)20 7326 0349

CLIENT  
RAB PENSION TRUST

- TREVOR LAMER ARCHITECTS
- Do not scale off this drawing, use figure dimensions only. All dimensions and levels to be provided on site. Contractor must submit a written report to promptly report all errors, discrepancies and omissions to TLA.
  - Issue only for purposes indicated.
  - This drawing is to be used for comparison only. It is not to be used for construction or for any other purpose. It is not to be copied, altered or reproduced in any way without the prior written consent of TLA.
  - This drawing is copyright and the property of TLA and may not be copied, altered or reproduced in any way without the prior written consent of TLA.
  - The contractor shall be responsible for all statutory obligations under the CDM regulations.
  - The dimensions shown on this drawing shall be based on the measurements provided by the professional surveying company.
  - Changes to be provided by the contractor for TLA approval.
  - TLA is not liable for drawings and notes not in accordance.

PROPOSED

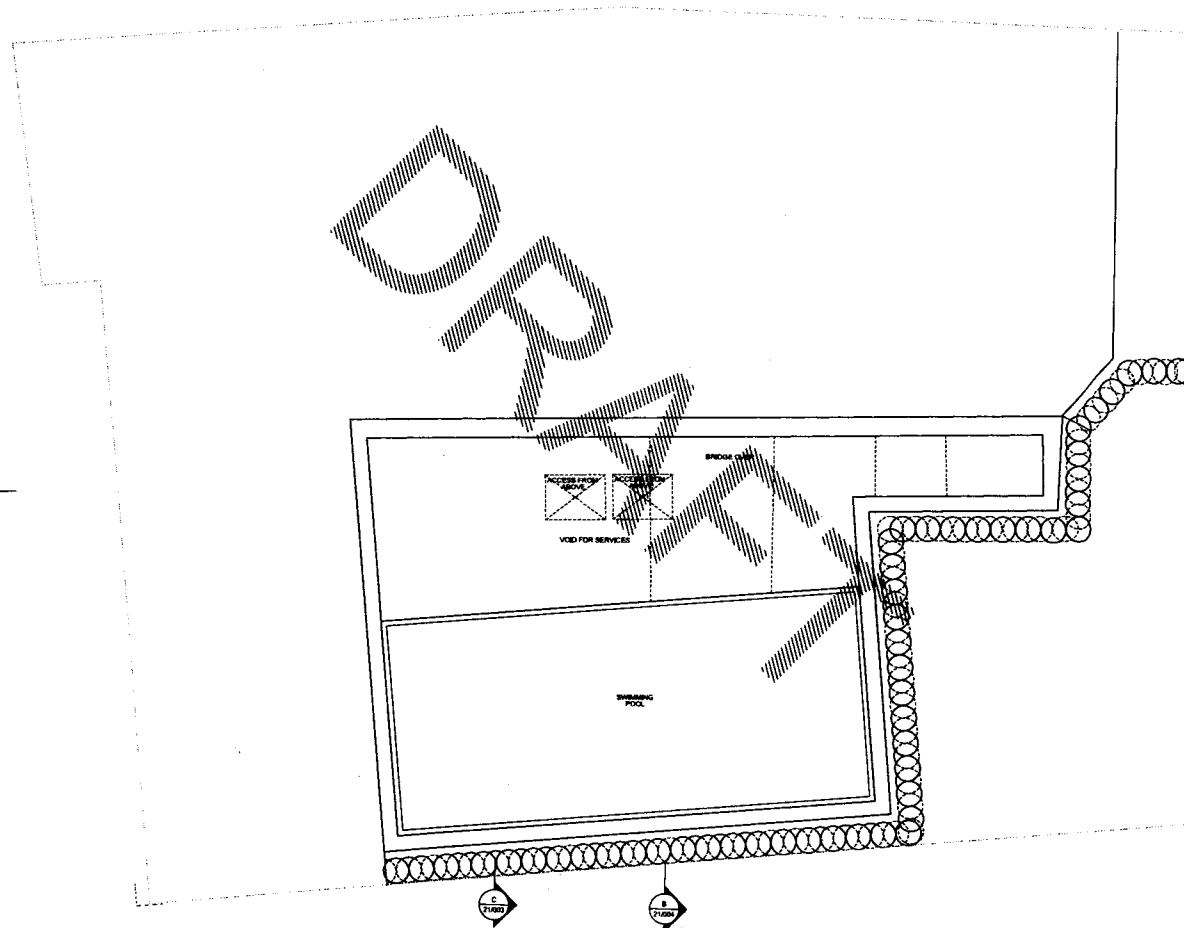

0 1 2 3 4 5 10 METERS



PROPOSED SUBBASEMENT PLAN - SCALE 1:50 @ A1 & 1:100 @ A3

REV	DATE	DESCRIPTION	DRAWN	CHECKED
PL1	20.12.10	DRAFT PLANNING DRAW	RJ	DM
PL2	24.11.10	REVISIONS	RJ	-
PL3	24.11.10	REVISIONS	RJ	-


ADDRESS  
9 PHENE STREET  
LONDON SW3 5NY

TITLE  
PROPOSED  
SUB BASEMENT PLAN

STATUS	PLANNING	DRAWN BY	RJ
SCALE	1:50@A1 & 1:100@A3	CHECKED BY	DM
DATE	JULY 2011	REV	007
PROJECT	822	(20)	007


Drawn



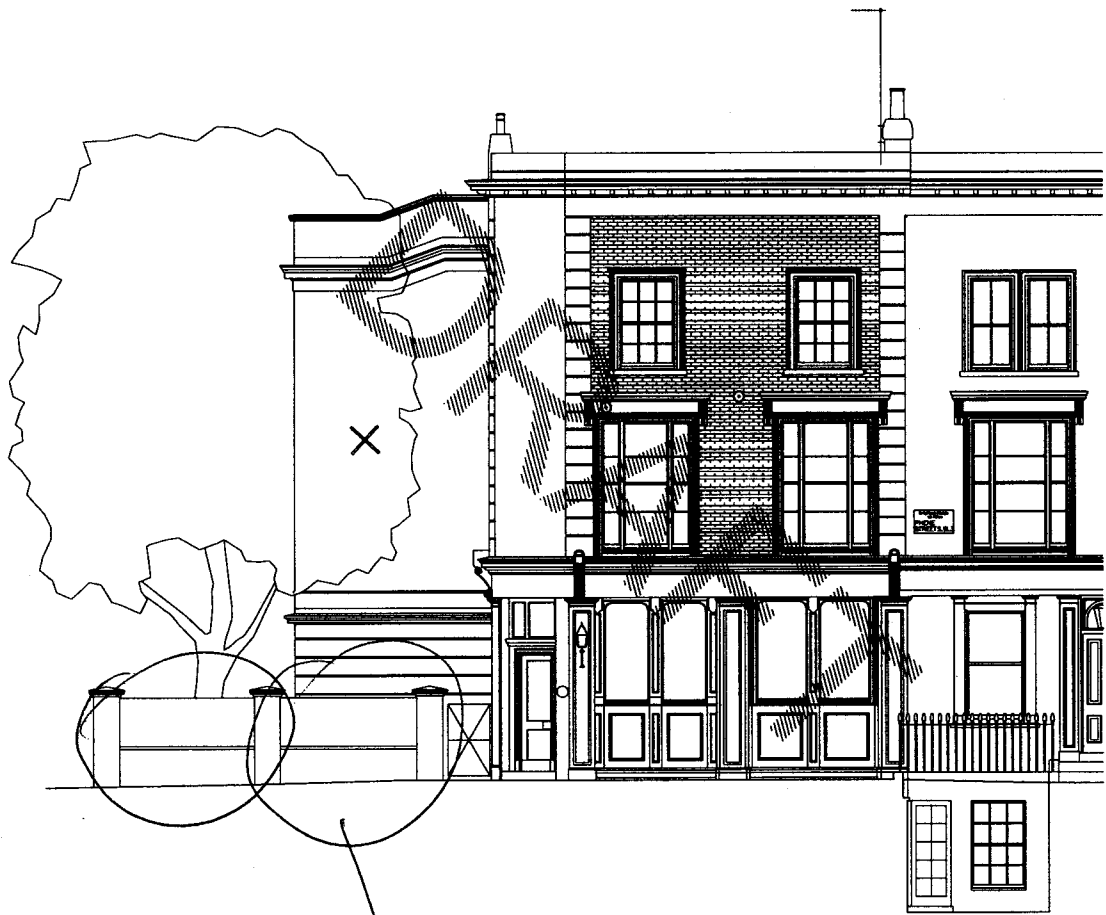

*various*

EXISTING SOUTH EAST ELEVATION (PHENE STREET) - 1:50 @ A1 & 1:100 @ A3

 

TRENOR | LAWRY ARCHITECTS

gerrards house  
99 KINGSWOOD ROAD  
LONDON SE25 8JL  
design@trenorlawry.co.uk  
www.trenorlawry.co.uk  
T +44(0)20 7727 8181  
F +44(0)20 7328 0388

CLIENT  
RAB PENSION TRUST

- TRENOR LAWRY ARCHITECTS LTD
- Do not scale off this drawing, use square dimensions only. All dimensions and levels to be given on this and other LRA drawings to be marked in red ink.
  - Intend only for purpose indicated.
  - This drawing is to be used in conjunction with construction drawings and specifications.
  - This drawing is a copy of the original and may not be used, altered or reproduced in any way or passed to a third party without the written consent.
  - The main contractor should be advised of any necessary alterations to the drawings before they are issued.
  - The drawings shall be the responsibility of the architect.

EXISTING



REVISIONS

NO.	DATE	DESCRIPTION	BY	CHKD
01	01/11/10	DRAFT PLANNING MARK	RL	MM
02	01/11/10	REVISION	RL	MM
03	01/11/10	REVISION	RL	MM

ADDRESS  
9 PHENE STREET  
LONDON SW3 5NY

TITLE  
PROPOSED SOUTH EAST ELEVATION

DISC	PLANNING	DATE	05/07/11
SCALE	1:50 @ A1	DESIGNED BY	MM
DATE	JULY 2011	CHKD	MM
PROJECT NO.	822 (21)	DATE	05/07/11



**TREVOR LAMY ARCHITECTS**  
 Geneva House  
 18 Southwark Road  
 London SE1 3QU  
 www.trevorlamy.co.uk  
 design@trevorlamy.co.uk  
 T +44(0)20 7737 6181  
 F +44(0)20 7526 0269

CLIENT  
**RAB PENSION TRUST**


- TREVOR LAMY ARCHITECTS
1. On no part of this drawing, nor figure thereon, shall any dimensions or notes be given in the absence of a written order or agreement in writing to the contrary signed by the client or its authorized representative and the architect shall not be responsible for any errors or omissions in this drawing.
  2. Issues only for professional use.
  3. This drawing is to be used in conjunction with conditions of sale and specifications unless otherwise stated. It is not to be used for any other purpose without the written consent of the architect.
  4. This drawing is copyright and any copying or reproduction in any form or by any means without the written consent of the architect is prohibited.
  5. The architect accepts no responsibility for any errors or omissions in this drawing or for any consequences arising therefrom.
  6. The architect shall not be responsible for any errors or omissions in this drawing or for any consequences arising therefrom.

PROPOSED

Scale: 1:50 @ A1 & 1:100 @ A3



PROPOSED SOUTH WEST ELEVATION - SCALE 1:50 @ A1 & 1:100 @ A3

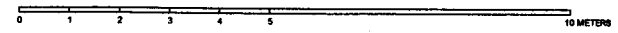


NO.	DATE	DESCRIPTION	BY	CHKD
01	01/10/11	CONCEPT PLANNING	TL	TL
02	01/10/11	REVISIONS FOLLOWING PLANNING	TL	TL
03	01/10/11	REVISIONS FOLLOWING PLANNING	TL	TL
04	01/10/11	REVISIONS FOLLOWING PLANNING	TL	TL

PROJECT: 9 PHENE STREET LONDON SW3 5NY

TITLE: PROPOSED SOUTH WEST ELEVATION

STATUS: PLANNING	DESIGNER: TL
SCALE: 1:50 @ A1 & 1:100 @ A3	DATE: JULY 2011
PROJECT: 022	DATE: 04

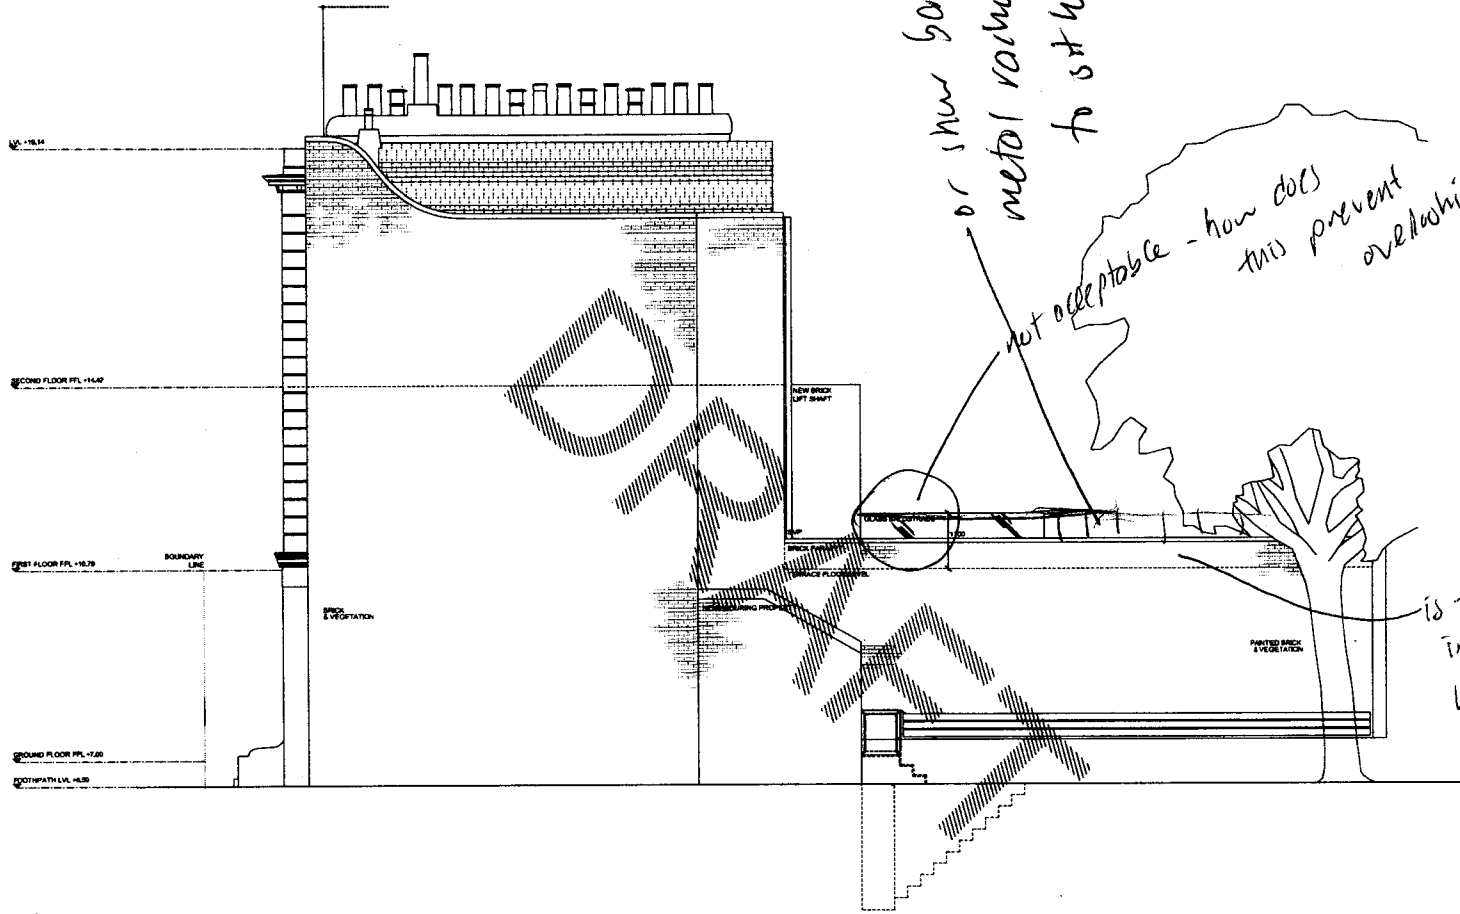

TREVOR | LAFF ARCHITECTS  
 Geneva House  
 99 Whitehall Road  
 London SE18 9QU  
 design@trevorlaff.co.uk  
 www.trevorlaff.co.uk  
 T +44(0)20 7737 6181  
 F +44(0)20 7328 0348

- CLIENT: RAB PENSION TRUST
- TREVOR LAFF ARCHITECTS
1. Do not scale off this drawing, use figure dimensions only. All dimensions are metric in millimetres unless otherwise stated. Contractors must submit a detailed schedule of materials to the Client for approval.
  2. Issues only for permission purposes.
  3. The drawing is to be used for planning only. Contractors must not be allowed to make any alterations to the drawing without the written consent of the architect.
  4. The drawing is copyright and the property of TLA and may not be copied, altered or reproduced in any way or used in a third party without the written consent of TLA.
  5. The main contractor should be consulted with the architect regarding the correct use of the drawing.
  6. The dimensions shown on this drawing shall be based on the measurements provided by an approved surveyor.
  7. Samples to be provided by the contractor to TLA approval.
  8. TLA is not responsible for drawings and not able to monitor.

PROPOSED

Proposed Name:

REV	DATE	DESCRIPTION	DRAWN BY	CHECKED BY
01				
02				
9 PHENE STREET  
 LONDON SW3 5NY

EXISTING NORTH EAST ELEVATION


STATUS: PLANNING

SCALE: 1:50 @ A1 & 1:100 @ A3

DATE: JULY 2011


PROJECT: 022 (21)

EXISTING NORTH EAST ELEVATION - SCALE 1:50 @ A1 & 1:100 @ A3

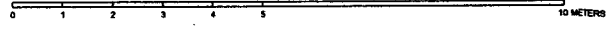



EXISTING WINDOWS

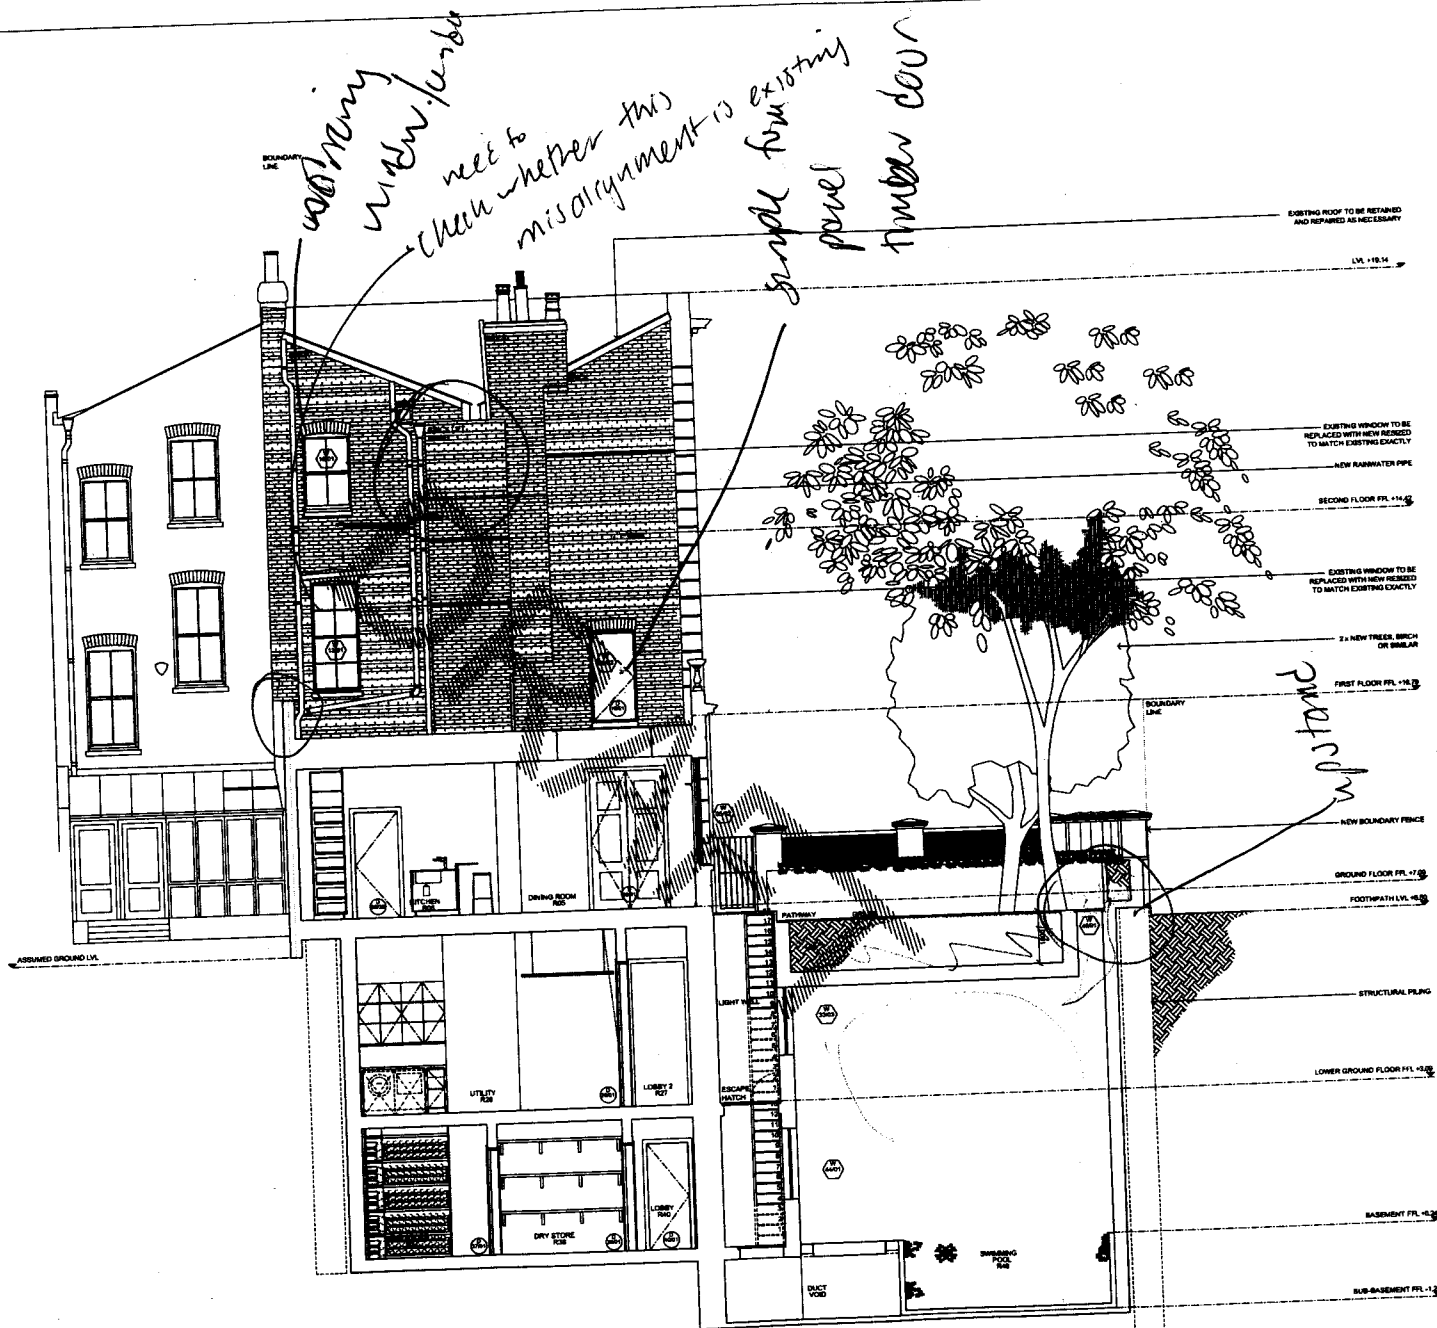

**TRIVOR | LAWRY ARCHITECTS**

genera house  
68 broadfield road  
London SE5 8QU  
design@trivor.co.uk  
www.trivor.co.uk  
T +44(0)20 7737 8181  
F +44(0)20 7528 0340

- CLIENT: RAG PENSION TRUST
- TRIVOR | LAWRY ARCHITECTS
**PROPOSED**

SPECIFIC NOTES

NO.	DATE	DESCRIPTION	BY	CHECKED
PROPOSED SECTION CC - SCALE 1:50 @ A1 & 1:100 @ A3

**TREVOR | LAYBY ARCHITECTS**  
 genesis house  
 88 hatchedwell road  
 london SE5 8QU  
 design@trevorlayby.co.uk  
 www.trevorlayby.co.uk  
 T +44(0)20 7737 8181  
 F +44(0)20 7328 0348

CLIENT  
**RAB PENSION TRUST**

- TREVOR LAYBY ARCHITECTS
1. Do not scale off this drawing, use the grid dimensions only. All dimensions are based on the ground level. Changes made after submission will be subject to a charge of £100 per hour plus any applicable building regulations and statutory fees.
  2. Issues only for paper editions.
  3. This drawing is to be used in conjunction with construction drawings. All drawings are to be drawn in accordance with the latest Building Regulations and Approved Documents.
  4. This drawing is copyright and with priority of TLA and may not be copied, altered or reproduced in any way or used for any other purpose without the prior consent of Trevor Layby Architects.
  5. The main contractor should be consulted with the statutory regulations prior to construction.
  6. Any alterations to this drawing must be made on this drawing or on a separate sheet. An amendment note is required.
  7. Examples are provided by each member for TLA approval.
  8. TLA is responsible for drawings and not liable for construction.

**PROPOSED**

Revised Notes

NO. | DATE | DESCRIPTION


PN	02.10.11	CRAFT PLANING/SHALE	PL	1/10
PN	03.11.11	REVISED	PL	1/1
PN	14.11.11	REVISED	PL	1/1

REV DATE | DESCRIPTION

ADDRESS  
**9 PHENE STREET  
 LONDON SW3 5NY**

TITLE  
**PROPOSED SECTION DD**


STATUS	PLANNING	DESIGNED BY	RU
SCALE	1:50 @ A1 & 1:100 @ A3	CHECKED BY	RW
DATE	JULY 2011	DRAWN BY	DDA
PROJECT NO.	822	(21)	PS

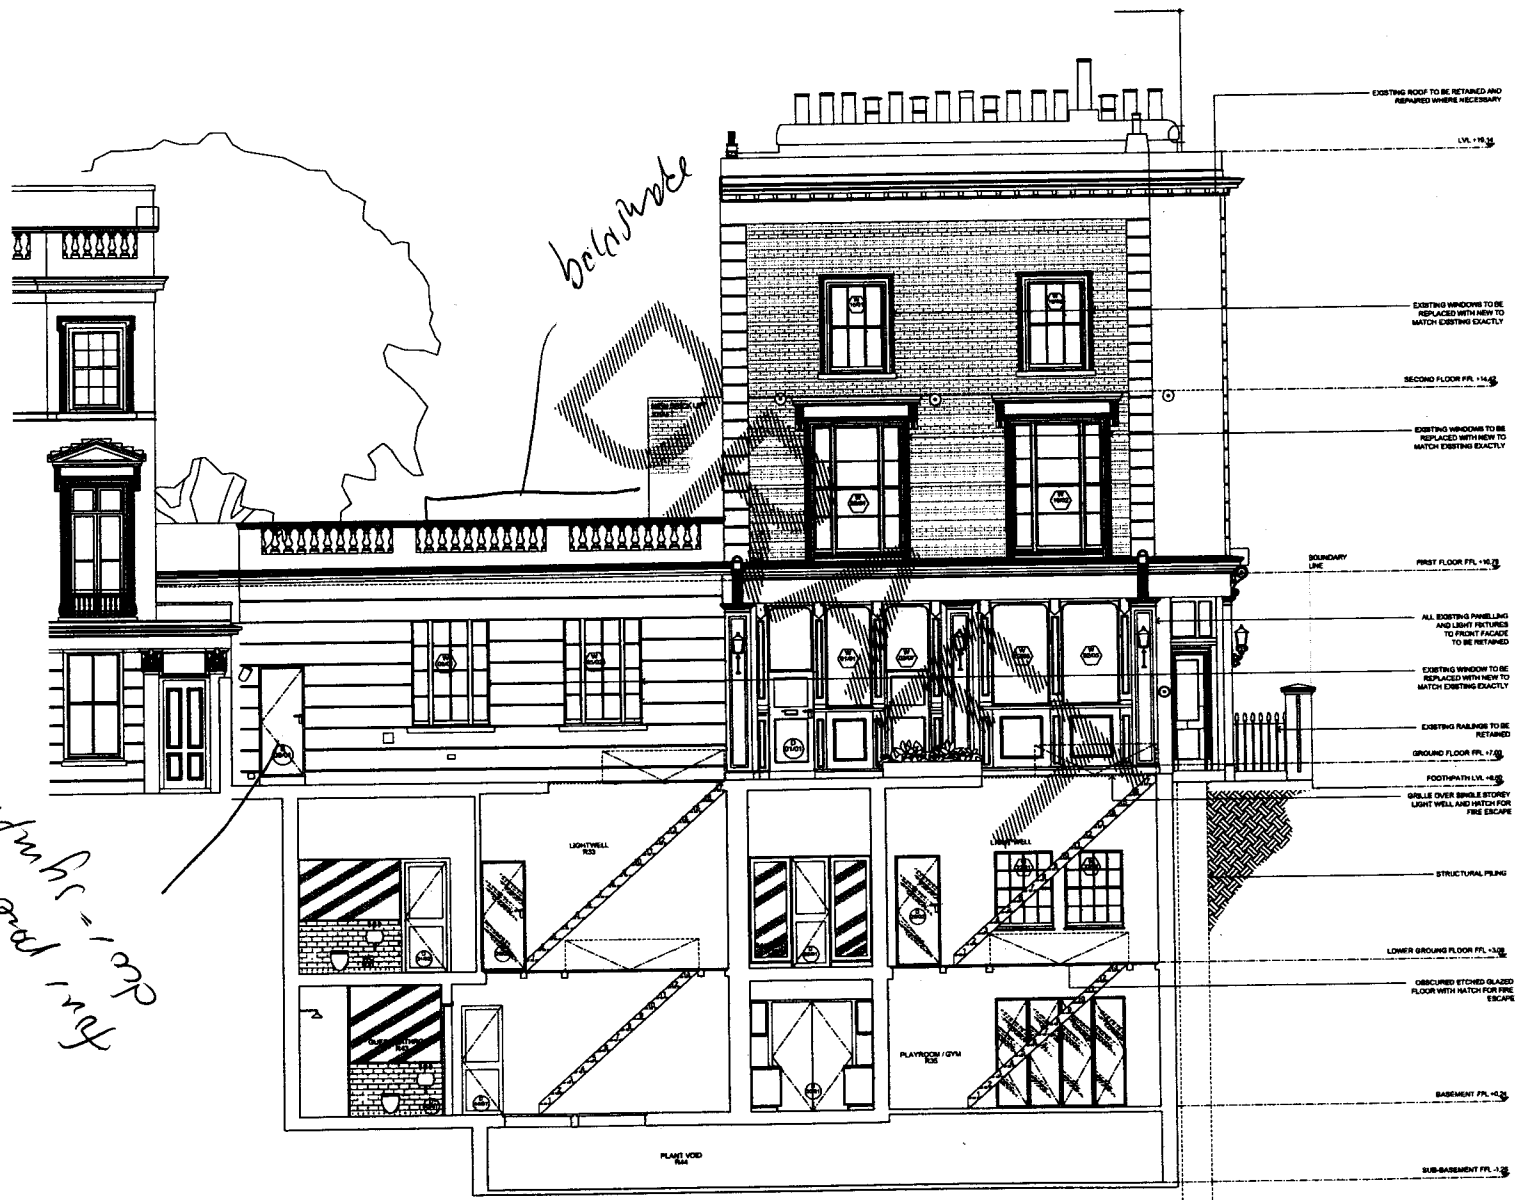

*for paper print.*

*before*

PROPOSED SECTION DD - SCALE 1:50 @ A1 & 1:100 @ A3

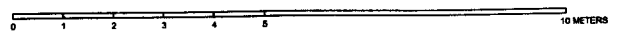

**CLIENT**  
 RAB PENSION TRUST


**TREVOR | LAMPP ARCHITECTS | 1/10**



**PROPOSED**

**GENERAL NOTES**

*upstone planted wall in M*

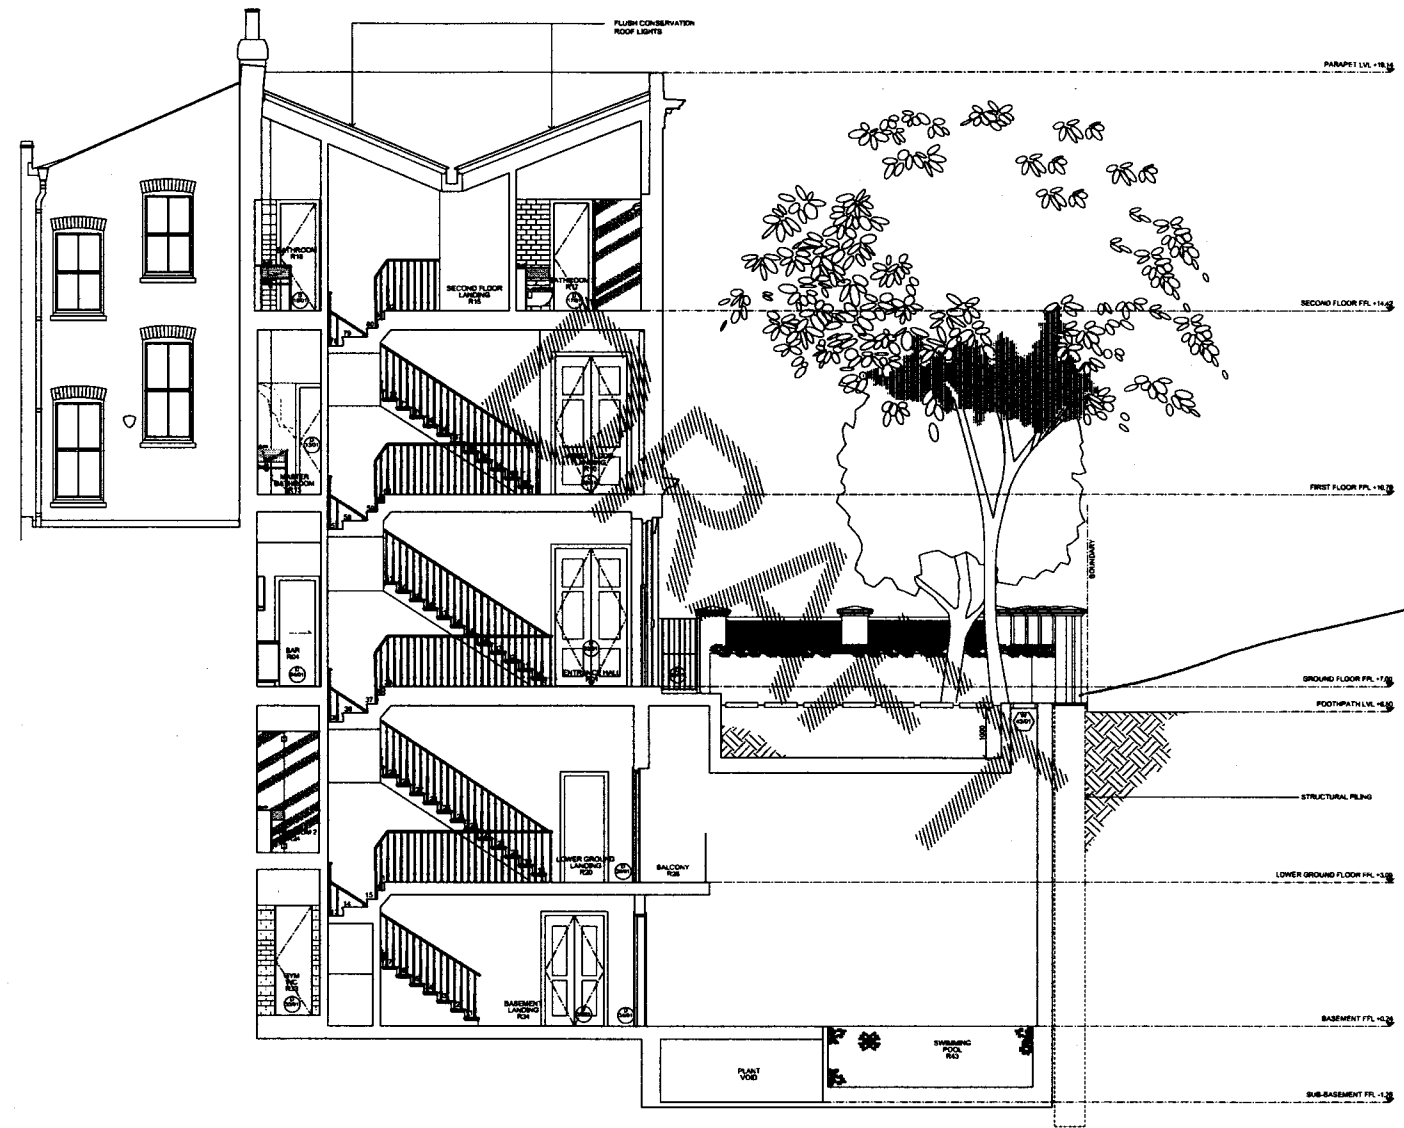

PROPOSED SECTION BB - SCALE 1:50 @ A1 & 1:100 @ A3

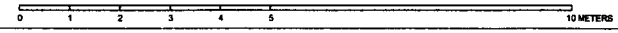

REV	DATE	DESCRIPTION	OWN/CHKD
02	21.11	CONCEPT PLANNING SHEET	RJ
01	11.11.10	PERMISSIONS	RJ
00	11.11.10	ADDITION OF SCALE BAR	RJ
00	11.11.10	ISSUED TO PLANNING CONSULTANT	RJ

ADDRESS  
**9 PHENE STREET  
 LONDON SW3 5NY**

TITLE  
**PROPOSED SECTION BB**

STAGE	PLANNING	DESIGNED BY
SCALE	1:50 @ A1 & 1:100 @ A3	DESIGNED BY RJ
DATE	JULY 2011	CHECKED BY RJM
PROJECT NO.	622 (21)	DATE 002